



# SIGN PERMIT

Community Development Department  
250 North 5th Street  
Grand Junction, CO 81501  
(303) 244-1430

PERMIT NO. 53477  
Date Submitted 9-20-95  
FEE \$ 25.00  
Tax Schedule 2945-131-01-027  
Zone B-3

BUSINESS NAME Hobby Lobby  
STREET ADDRESS 2401 Nth Ave  
PROPERTY OWNER Hobby Lobby  
OWNER ADDRESS 2101 Nth Ave

CONTRACTOR Shaw Signs  
LICENSE NO 2950563  
ADDRESS 1314 Webster  
TELEPHONE NO 970-493-6244

- 1. FLUSH WALL 2 Square Feet per Linear Foot of Building Facade
  - 2. ROOF 2 Square Feet per Linear Foot of Building Facade
  - 3. FREE-STANDING 2 Traffic Lanes - 0.75 Square Feet x Street Frontage  
4 or more Traffic Lanes - 1.5 Square Feet x Street Frontage
  - 4. PROJECTING 0.5 Square Feet per each Linear Foot of Building Facade
  - 5. OFF-PREMISE See #3 Spacing Requirements; Not > 300 Square Feet or < 15 Square Feet
- Externally Illuminated       Internally Illuminated       Non-Illuminated

(1 - 5) Area of Proposed Sign 289 Square Feet  
(1,2,4) Building Facade 225 Linear Feet  
(1 - 4) Street Frontage \_\_\_\_\_ Linear Feet  
(2,4,5) Height to Top of Sign 19 Feet Clearance to Grade 14 Feet  
(5) Distance from all Existing Off-Premise Signs within 600 Feet N/A Feet

<u>Existing Signage/Type</u>	_____	Sq Ft
_____	_____	Sq Ft
_____	_____	Sq Ft
<b>Total Existing:</b>	_____	<b>Sq Ft</b>

**FOR OFFICE USE ONLY:**

Signage Allowed on Parcel

Building See full Sq Ft

Free-Standing #41-89 Sq Ft

**Total Allowed:** #41-89 Sq Ft

COMMENTS: Replaces former Gibson's wall  
sign - 293 A

**NOTE:** No sign may exceed 300 square feet. A separate sign permit is required for each sign. Attach a sketch of proposed and existing signage including types, dimensions, lettering, abutting streets, alleys, easements, property lines, and locations. All signs require a separate permit from the Building Department.

Mark Foster  
Applicant's Signature  
Mark Foster

9-20-95  
Date

[Signature]  
Approved By  
MICHAEL T. DROLLINGER  
9-20-95  
Date




13034936288 P.02

TO

09-13-1995 10:47AM FROM

\* show to supply Greenfield & fittings \* pull faces to  
 Install - ATTACH THRU BACK OF LETTERS  
 \* DIT NEED

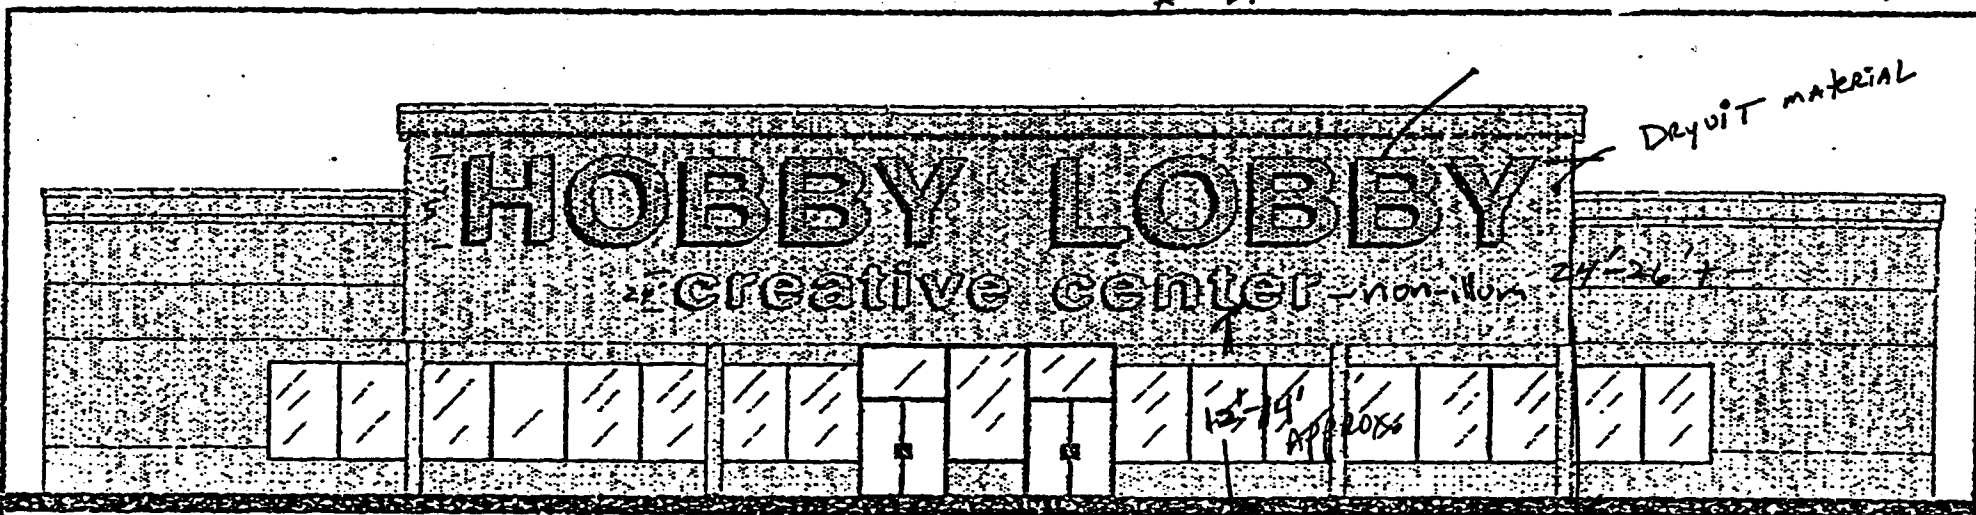

TYPICAL STOREFRONT ELEVATION WITH A 5' FOOT SET OF LETTERS

**SPECIFICATIONS:**

ALL LETTERS ARE .063 & .080 WELDED ALUMINUM CONSTRUCTION  
 HOBBY LOBBY IS ILLUMINATED BY 15MM RED NEON.  
 CREATIVE CENTER IS NOT ILLUMINATED.  
 HOBBY LOBBY IS #2119 ORANGE PLEXIGLAS.  
 CREATIVE CENTER IS #2648 BLUE PLEX.  
 ALL LETTERS ARE ETCH PRIMED AND FINISHED WITH DARK BRONZE ACRYLIC ENAMEL OUT AND WHITE ACRYLIC INTERIOR.  
 ALL TRIMCAP IS 1 INCH GOLD

LETTER HEIGHT	4 ft	5 ft	6 ft	7ft	8ft
HOBBY LOBBY Over all length	39"	48.4"	58.6"	67.5"	76"
creative center Over all length	23.6"	29.4"	35.3"	41.2"	47"
total height	7'	8'8"	10'6"	12'3"	14'
Square Ft HOBBY LOBBY	156	242	351	474	624
Square Ft creative center	47	73.5	106	144	188
Total square Ft	203	315.5	457	618	812

NOTE: CREATIVE CENTER IS 1/2 THE HEIGHT OF HOBBY LOBBY

hiform6.cdr


PREPARED BY: David Bish	Hobby Lobby Stores, Inc. Corporate Identity Graphics		Exterior Building Signs	ORIGINAL DRAWING	PAGE NO. 1
DATE: JUNE 1995			Store Location:	FILE- HIFORM5.CDR	

HOBBY LOBBY (970) 256-1125  
2401 North Ave. #22  
Grand Junction 81501

TOTAL 9.61

# Teller Arm Center

GRAND JCT CO. #102

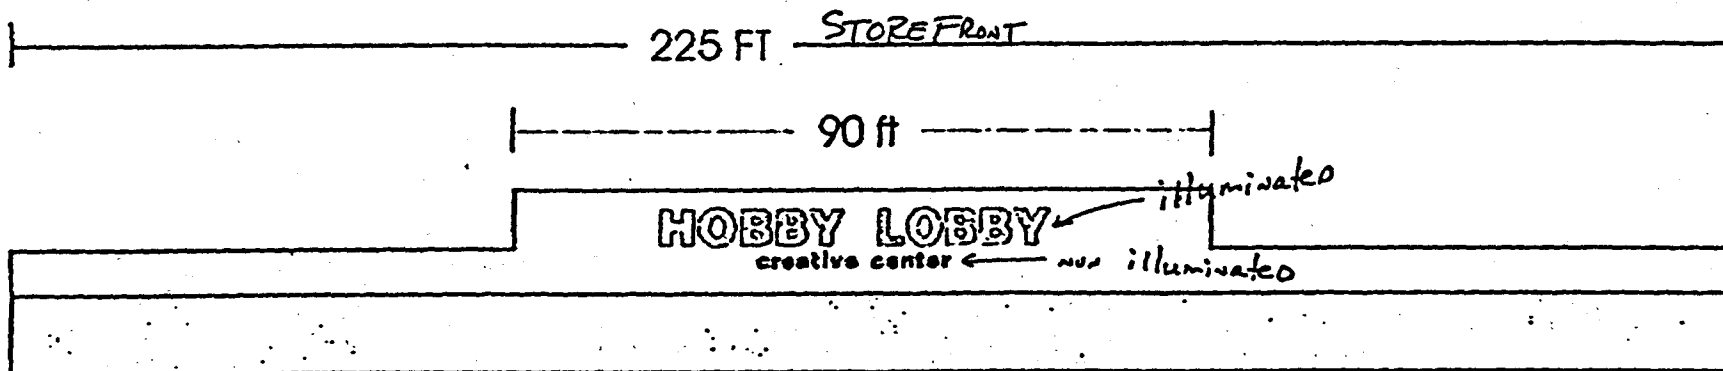

HOBBY LOBBY IS 60" X 48'4" = 242 SQFT  
creative center IS 24" X 23.6" = 47 SQFT  
TOTAL SQ FT = 289

CUSTOMER HOBBY LOBBY  
DATE 8/28/95  
SALESMAN DAVID BISH  
DRAWING NO. GRAND102.CDR



SIZE \_\_\_\_\_  
SCALE: APPROX 1/16" = 1'  
COST \$ \_\_\_\_\_