



SIGN CLEARANCE

Community Development Department
 250 North 5th Street
 Grand Junction, CO 81501
 (970) 244-1430

Clearance No. 103327
 Date Submitted _____
 FEE \$ 25.00
 Tax Schedule 2945-091-00-104
 Zone C-2

A

BUSINESS NAME 2455 CIRCUIT CITY CONTRACTOR WESTERN NOON SIGN
 STREET ADDRESS 2455 6th St LICENSE NO. 2970446
 PROPERTY OWNER CIRCUIT CITY ADDRESS 2495 Industrial
 OWNER ADDRESS 2455-6-50 TELEPHONE NO. 242-7843

- 1. FLUSH WALL 2 Square Feet per Linear Foot of Building Facade
- 2. ROOF 2 Square Feet per Linear Foot of Building Facade
- 3. FREE-STANDING 2 Traffic Lanes - 0.75 Square Feet x Street Frontage
4 or more Traffic Lanes - 1.5 Square Feet x Street Frontage
- 4. PROJECTING 0.5 Square Feet per each Linear Foot of Building Facade
- 5. OFF-PREMISE See #3 Spacing Requirements; Not > 300 Square Feet or < 15 Square Feet

Externally Illuminated Internally Illuminated Non-Illuminated

- (- 5) Area of Proposed Sign 112 Square Feet
- (1,2,4) Building Facade 10180 Linear Feet
- (1 - 4) Street Frontage 329 Linear Feet
- (2,4,5) Height to Top of Sign 40 Feet Clearance to Grade 32 Feet
- (5) Distance from all Existing Off-Premise Signs within 600 Feet _____ Feet

Existing Signage/Type:			
B - CIRCUIT CITY	196	Sq. Ft.	
A - POLE SIGN	112	Sq. Ft.	
		Sq. Ft.	
Total Existing:	<u>0</u>	<u>208</u>	Sq. Ft.

● FOR OFFICE USE ONLY ●	
Signage Allowed on Parcel:	
Building	<u>280360</u> Sq. Ft.
Free-Standing	<u>493.5</u> Sq. Ft.
Total Allowed:	<u>493.5</u> Sq. Ft.

COMMENTS: _____

NOTE: No sign may exceed 300 square feet. A separate sign clearance is required for each sign. Attach a sketch of proposed and existing signage including types, dimensions, lettering, abutting streets, alleys, easements, property lines, and locations. **A SEPARATE PERMIT FROM THE BUILDING DEPARTMENT IS REQUIRED.**

[Signature] 2-20-97 [Signature] 12/12/97
 Applicant's Signature Date Community Development Approval Date
 (White: Community Development) (Canary: Applicant) (Pink: Building Dept) (Goldenrod: Code Enforcement)



SIGN CLEARANCE

Community Development Department
250 North 5th Street
Grand Junction, CO 81501
(970) 244-1430

Clearance No. 103328
Date Submitted _____
FEES \$ 5.00
Tax Schedule 2945-091-00-104
Zone C-2

B

BUSINESS NAME Circuit City
STREET ADDRESS 2455 - 6th SO
PROPERTY OWNER Reed Miller
OWNER ADDRESS 2455 - 6th SO

CONTRACTOR Western Neon Sign
LICENSE NO. 2970446
ADDRESS 2495 Industrial
TELEPHONE NO. 242-7843

- 1. FLUSH WALL 2 Square Feet per Linear Foot of Building Facade
- 2. ROOF 2 Square Feet per Linear Foot of Building Facade
- 3. FREE-STANDING 2 Traffic Lanes - 0.75 Square Feet x Street Frontage
4 or more Traffic Lanes - 1.5 Square Feet x Street Frontage
- 4. PROJECTING 0.5 Square Feet per each Linear Foot of Building Facade
- 5. OFF-PREMISE See #3 Spacing Requirements; Not > 300 Square Feet or < 15 Square Feet

Externally Illuminated

Internally Illuminated

Non-Illuminated

- (- 5) Area of Proposed Sign 90 Square Feet
- (1,2,4) Building Facade 180 Linear Feet
- (1 - 4) Street Frontage 329 Linear Feet
- (2,4,5) Height to Top of Sign 18 Feet Clearance to Grade 15 Feet
- (5) Distance from all Existing Off-Premise Signs within 600 Feet _____ Feet

Existing Signage/Type:	
Pole Sign	112 Sq. Ft.
	Sq. Ft.
	Sq. Ft.
Total Existing:	Sq. Ft.

● FOR OFFICE USE ONLY ●	
Signage Allowed on Parcel:	
Building	360 Sq. Ft.
Free-Standing	493 Sq. Ft.
Total Allowed:	493 Sq. Ft.

COMMENTS: _____

NOTE: No sign may exceed 300 square feet. A separate sign clearance is required for each sign. Attach a sketch of proposed and existing signage including types, dimensions, lettering, abutting streets, alleys, easements, property lines, and locations. **A SEPARATE PERMIT FROM THE BUILDING DEPARTMENT IS REQUIRED.**

Edward Kowalski 12-9-97 Mike Pelletier 12/12/97
Applicant's Signature Date Community Development Approval Date

(White: Community Development) (Canary: Applicant) (Pink: Building Dept) (Goldenrod: Code Enforcement)



SIGN CLEARANCE

Community Development Department
250 North 5th Street
Grand Junction, CO 81501
(970) 244-1430

Clearance No. 103328
Date Submitted _____
FEE \$ 5.00
Tax Schedule 2945-091-00-104
Zone C-2

BUSINESS NAME CIRCUIT CITY
STREET ADDRESS 2455 6+50
PROPERTY OWNER Reed Miller
OWNER ADDRESS 2455 - 6+50

CONTRACTOR Western Neon Sign
LICENSE NO. 2970466
ADDRESS 2495 INDUSTRIAL
TELEPHONE NO. 242-7843

- 1. FLUSH WALL 2 Square Feet per Linear Foot of Building Facade
- 2. ROOF 2 Square Feet per Linear Foot of Building Facade
- 3. FREE-STANDING 2 Traffic Lanes - 0.75 Square Feet x Street Frontage
4 or more Traffic Lanes - 1.5 Square Feet x Street Frontage
- 4. PROJECTING 0.5 Square Feet per each Linear Foot of Building Facade
- 5. OFF-PREMISE See #3 Spacing Requirements; Not > 300 Square Feet or < 15 Square Feet

Externally Illuminated Internally Illuminated Non-Illuminated

- (- 5) Area of Proposed Sign 97 Square Feet
- (1,2,4) Building Facade ¹⁸⁰ ~~140~~ Linear Feet
- (1 - 4) Street Frontage 329 Linear Feet
- (2,4,5) Height to Top of Sign 10 Feet Clearance to Grade 8 Feet
- (5) Distance from all Existing Off-Premise Signs within 600 Feet _____ Feet

Existing Signage/Type:	
CAR STEREO INSTALL 97	Sq. Ft.
Pole Sign	112 Sq. Ft.
Flush Wall "B"	90 Sq. Ft.
Total Existing:	202 Sq. Ft.

● FOR OFFICE USE ONLY ●		
Signage Allowed on Parcel:		
Building	360	Sq. Ft.
Free-Standing	493	Sq. Ft.
Total Allowed:	493	Sq. Ft.

COMMENTS: _____

NOTE: No sign may exceed 300 square feet. A separate sign clearance is required for each sign. Attach a sketch of proposed and existing signage including types, dimensions, lettering, abutting streets, alleys, easements, property lines, and locations. **A SEPARATE PERMIT FROM THE BUILDING DEPARTMENT IS REQUIRED.**

Edward Kowalski 12-9-97 Mike Pelletier 12/12/97
Applicant's Signature Date Community Development Approval Date

(White: Community Development) (Canary: Applicant) (Pink: Building Dept) (Goldenrod: Code Enforcement)



SIGN CLEARANCE

Community Development Department
250 North 5th Street
Grand Junction, CO 81501
(970) 244-1430

D

Clearance No. 2945-091-00-104
63328
Date Submitted _____
FEES 5.00
Tax Schedule 2970 2943-041
Zone C-2

BUSINESS NAME CIRCUIT CITY
STREET ADDRESS 2455 6+50
PROPERTY OWNER Reed Miller
OWNER ADDRESS 2455 - 6+50

CONTRACTOR Western Neon Sign
LICENSE NO. 2970466
ADDRESS 2495 INDUSTRIAL
TELEPHONE NO. 242-7843

- 1. FLUSH WALL 2 Square Feet per Linear Foot of Building Facade
- 2. ROOF 2 Square Feet per Linear Foot of Building Facade
- 3. FREE-STANDING 2 Traffic Lanes - 0.75 Square Feet x Street Frontage
4 or more Traffic Lanes - 1.5 Square Feet x Street Frontage
- 4. PROJECTING 0.5 Square Feet per each Linear Foot of Building Facade
- 5. OFF-PREMISE See #3 Spacing Requirements; Not > 300 Square Feet or < 15 Square Feet

Externally Illuminated

Internally Illuminated

Non-Illuminated

- 5) Area of Proposed Sign 88.5 Square Feet
- (1,2,4) Building Facade 180 Linear Feet
- (1 - 4) Street Frontage 284 Linear Feet
- (2,4,5) Height to Top of Sign 24 Feet Clearance to Grade 18 Feet
- (5) Distance from all Existing Off-Premise Signs within 600 Feet _____ Feet

Existing Signage/Type:	
CIRCUIT CITY <u>88.5</u>	Sq. Ft.
Pole Sign	<u>112</u> Sq. Ft.
Flush Wall "B", "C"	<u>99</u> Sq. Ft.
Total Existing:	<u>211</u> Sq. Ft.

● FOR OFFICE USE ONLY ●	
Signage Allowed on Parcel:	
Building	<u>360</u> Sq. Ft.
Free-Standing	<u>493</u> Sq. Ft.
Total Allowed:	<u>493</u> Sq. Ft.

COMMENTS: _____

NOTE: No sign may exceed 300 square feet. A separate sign clearance is required for each sign. Attach a sketch of proposed and existing signage including types, dimensions, lettering, abutting streets, alleys, easements, property lines, and locations. **A SEPARATE PERMIT FROM THE BUILDING DEPARTMENT IS REQUIRED.**

Edward Kowalski 12-9-97 Mike Pelletier 12/12/97
Applicant's Signature Date Community Development Approval Date

(White: Community Development) (Canary: Applicant) (Pink: Building Dept) (Goldenrod: Code Enforcement)



SIGN CLEARANCE

Community Development Department
250 North 5th Street
Grand Junction, CO 81501
(970) 244-1430

Clearance No. 03328
Date Submitted _____
FEE \$ 5.00
Tax Schedule 2945-091-00-104
Zone C-2

E

BUSINESS NAME CIRCUIT CITY
STREET ADDRESS 2455 G-50
PROPERTY OWNER Reed Miller
OWNER ADDRESS 2455-6-5

CONTRACTOR Western Neon Sign
LICENSE NO. 2970446
ADDRESS 2495 Industrial
TELEPHONE NO. 242-7843

- 1. FLUSH WALL 2 Square Feet per Linear Foot of Building Facade
- 2. ROOF 2 Square Feet per Linear Foot of Building Facade
- 3. FREE-STANDING 2 Traffic Lanes - 0.75 Square Feet x Street Frontage
4 or more Traffic Lanes - 1.5 Square Feet x Street Frontage
- 4. PROJECTING 0.5 Square Feet per each Linear Foot of Building Facade
- 5. OFF-PREMISE See #3 Spacing Requirements; Not > 300 Square Feet or < 15 Square Feet

Externally Illuminated Internally Illuminated Non-Illuminated

- (- 5) Area of Proposed Sign 77 Square Feet
- (1,2,4) Building Facade 180 Linear Feet
- (1 - 4) Street Frontage 284 Linear Feet
- (2,4,5) Height to Top of Sign 14 Feet Clearance to Grade 12 Feet
- (5) Distance from all Existing Off-Premise Signs within 600 Feet _____ Feet

Existing Signage/Type:	Sq. Ft.
Audio - T#	
Pole Sign	112 Sq. Ft.
Flush Wall "B", "C", "D"	187.5 Sq. Ft.
Total Existing:	299.5 Sq. Ft.

● FOR OFFICE USE ONLY ●		
Signage Allowed on Parcel:		
Building	360	Sq. Ft.
Free-Standing	493	Sq. Ft.
Total Allowed:	493	Sq. Ft.

COMMENTS: _____

NOTE: No sign may exceed 300 square feet. A separate sign clearance is required for each sign. Attach a sketch of proposed and existing signage including types, dimensions, lettering, abutting streets, alleys, easements, property lines, and locations. **A SEPARATE PERMIT FROM THE BUILDING DEPARTMENT IS REQUIRED.**

Edward Kowalski 12-9-97 4 Mike Pelletier 12/12/97
Applicant's Signature Date Community Development Approval Date

(White: Community Development) (Canary: Applicant) (Pink: Building Dept) (Goldenrod: Code Enforcement)



SIGN CLEARANCE

Community Development Department
250 North 5th Street
Grand Junction, CO 81501
(970) 244-1430

Clearance No. 103328
Date Submitted _____
FEE \$ 5.00
Tax Schedule 2945-091-00-104
Zone C-2

F

BUSINESS NAME CIRCUIT CITY
STREET ADDRESS 2455-6th50
PROPERTY OWNER Reed Miller
OWNER ADDRESS 2455-6-50

CONTRACTOR 2970446
LICENSE NO. Western Neon SIGN
ADDRESS 2495 Industrial
TELEPHONE NO. 242-7843

- 1. FLUSH WALL 2 Square Feet per Linear Foot of Building Facade
- 2. ROOF 2 Square Feet per Linear Foot of Building Facade
- 3. FREE-STANDING 2 Traffic Lanes - 0.75 Square Feet x Street Frontage
4 or more Traffic Lanes - 1.5 Square Feet x Street Frontage
- 4. PROJECTING 0.5 Square Feet per each Linear Foot of Building Facade
- 5. OFF-PREMISE See #3 Spacing Requirements; Not > 300 Square Feet or < 15 Square Feet

Externally Illuminated Internally Illuminated Non-Illuminated

- (1-5) Area of Proposed Sign 16.5 Square Feet
- (1,2,4) Building Facade 180 Linear Feet
- (1-4) Street Frontage 284 Linear Feet
- (2,4,5) Height to Top of Sign 14 Feet Clearance to Grade 12 Feet
- (5) Distance from all Existing Off-Premise Signs within 600 Feet _____ Feet

Existing Signage/Type:	
VIDEO <u>16.5</u>	Sq. Ft.
<u>Pole Sign</u>	<u>112</u> Sq. Ft.
<u>Flush Wall (B,C,D,E)</u>	<u>194.5</u> Sq. Ft.
Total Existing:	<u>306.5</u> Sq. Ft.

● FOR OFFICE USE ONLY ●		
Signage Allowed on Parcel:		
Building	<u>360</u>	Sq. Ft.
Free-Standing	<u>493</u>	Sq. Ft.
Total Allowed:	<u>493</u>	Sq. Ft.

COMMENTS: _____

NOTE: No sign may exceed 300 square feet. A separate sign clearance is required for each sign. Attach a sketch of proposed and existing signage including types, dimensions, lettering, abutting streets, alleys, easements, property lines, and locations. **A SEPARATE PERMIT FROM THE BUILDING DEPARTMENT IS REQUIRED.**

Edward Kowalski 12-9-97 Mike Pelletui 12/12/97
Applicant's Signature Date Community Development Approval Date

(White: Community Development) (Canary: Applicant) (Pink: Building Dept) (Goldenrod: Code Enforcement)



SIGN CLEARANCE

Community Development Department
250 North 5th Street
Grand Junction, CO 81501
(970) 244-1430

Clearance No. 63328
Date Submitted _____
FEE \$ 5.00
Tax Schedule 2945-091-00-104
Zone C-2

G

BUSINESS NAME CIRCUIT CITY
STREET ADDRESS 2455-6-50
PROPERTY OWNER Reed Miller
OWNER ADDRESS 2455-6-50

CONTRACTOR Western Neon SIGN
LICENSE NO. 2970466
ADDRESS 2495 Industrial
TELEPHONE NO. 242-7843

- 1. FLUSH WALL 2 Square Feet per Linear Foot of Building Facade
- 2. ROOF 2 Square Feet per Linear Foot of Building Facade
- 3. FREE-STANDING 2 Traffic Lanes - 0.75 Square Feet x Street Frontage
4 or more Traffic Lanes - 1.5 Square Feet x Street Frontage
- 4. PROJECTING 0.5 Square Feet per each Linear Foot of Building Facade
- 5. OFF-PREMISE See #3 Spacing Requirements; Not > 300 Square Feet or < 15 Square Feet

Externally Illuminated Internally Illuminated Non-Illuminated

- 5) Area of Proposed Sign 34.5 Square Feet
- (1,2,4) Building Facade 180 Linear Feet
- (1 - 4) Street Frontage 284 Linear Feet
- (2,4,5) Height to Top of Sign 14 Feet Clearance to Grade 12 Feet
- (5) Distance from all Existing Off-Premise Signs within 600 Feet _____ Feet

Existing Signage/Type:	
COMPUTERS <u>34.5</u>	Sq. Ft.
Pole Sign	<u>112</u> Sq. Ft.
Flush Wall (B,C,D,E,F)	<u>211</u> Sq. Ft.
Total Existing:	<u>323</u> Sq. Ft.

● FOR OFFICE USE ONLY ●		
Signage Allowed on Parcel:		
Building	<u>360</u>	Sq. Ft.
Free-Standing	<u>493</u>	Sq. Ft.
Total Allowed:	<u>493</u>	Sq. Ft.

COMMENTS: _____

NOTE: No sign may exceed 300 square feet. A separate sign clearance is required for each sign. Attach a sketch of proposed and existing signage including types, dimensions, lettering, abutting streets, alleys, easements, property lines, and locations. **A SEPARATE PERMIT FROM THE BUILDING DEPARTMENT IS REQUIRED.**

Edward Kowalski 12-9-97 Mike Pelletier 12/12/97
Applicant's Signature Date Community Development Approval Date

(White: Community Development) (Canary: Applicant) (Pink: Building Dept) (Goldenrod: Code Enforcement)



SIGN CLEARANCE

Community Development Department
250 North 5th Street
Grand Junction, CO 81501
(970) 244-1430

Clearance No. 63328
Date Submitted _____
FEE \$ 5.00
Tax Schedule 2945-091-00-104
Zone C-2

H

BUSINESS NAME CIRCUIT CITY CONTRACTOR Western Neon Sign
STREET ADDRESS 2455-6+50 LICENSE NO. 2970466
PROPERTY OWNER Reed Miller ADDRESS 2495 Industrial
OWNER ADDRESS 2455-6+50 TELEPHONE NO. 242-7843

- 1. FLUSH WALL 2 Square Feet per Linear Foot of Building Facade
 - 2. ROOF 2 Square Feet per Linear Foot of Building Facade
 - 3. FREE-STANDING 2 Traffic Lanes - 0.75 Square Feet x Street Frontage
4 or more Traffic Lanes - 1.5 Square Feet x Street Frontage
 - 4. PROJECTING 0.5 Square Feet per each Linear Foot of Building Facade
 - 5. OFF-PREMISE See #3 Spacing Requirements; Not > 300 Square Feet or < 15 Square Feet
- Externally Illuminated Internally Illuminated Non-Illuminated

- 5) Area of Proposed Sign 17 Square Feet
(1,2,4) Building Facade 180 Linear Feet
(1 - 4) Street Frontage 284 Linear Feet
(2,4,5) Height to Top of Sign 14 Feet Clearance to Grade 12 Feet
(5) Distance from all Existing Off-Premise Signs within 600 Feet _____ Feet

Existing Signage/Type:	
<u>MUSIC VIDEO 17A</u>	Sq. Ft.
<u>Pole</u>	<u>112</u> Sq. Ft.
<u>Flush Wall (A,B,C,D,E,F,G)</u>	<u>245.5</u> Sq. Ft.
Total Existing:	<u>357.5</u> Sq. Ft.

● FOR OFFICE USE ONLY ●		
Signage Allowed on Parcel:		
Building	<u>360</u>	Sq. Ft.
Free-Standing	<u>493</u>	Sq. Ft.
Total Allowed:	<u>493</u>	Sq. Ft.

COMMENTS: _____

NOTE: No sign may exceed 300 square feet. A separate sign clearance is required for each sign. Attach a sketch of proposed and existing signage including types, dimensions, lettering, abutting streets, alleys, easements, property lines, and locations. **A SEPARATE PERMIT FROM THE BUILDING DEPARTMENT IS REQUIRED.**

Edward Kowalski 12-9-97 Mike Pelletier 12/12/97
Applicant's Signature Date Community Development Approval Date

(White: Community Development) (Canary: Applicant) (Pink: Building Dept) (Goldenrod: Code Enforcement)



SIGN CLEARANCE

Community Development Department
250 North 5th Street
Grand Junction, CO 81501
(970) 244-1430

Clearance No. 103328
Date Submitted _____
FEE \$ _____
Tax Schedule ~~2970466~~ 2945-091-
Zone 00-104

J

BUSINESS NAME CIRCUIT CITY
STREET ADDRESS 2455 - 6+50
PROPERTY OWNER Reed Miller
OWNER ADDRESS 245 - 6+50

CONTRACTOR Western Neon Sign
LICENSE NO. 2970466
ADDRESS 2495 Industrial
TELEPHONE NO. 242-7843

- 1. FLUSH WALL 2 Square Feet per Linear Foot of Building Facade
- 2. ROOF 2 Square Feet per Linear Foot of Building Facade
- 3. FREE-STANDING 2 Traffic Lanes - 0.75 Square Feet x Street Frontage
4 or more Traffic Lanes - 1.5 Square Feet x Street Frontage
- 4. PROJECTING 0.5 Square Feet per each Linear Foot of Building Facade
- 5. OFF-PREMISE See #3 Spacing Requirements; Not > 300 Square Feet or < 15 Square Feet

Externally Illuminated Internally Illuminated Non-Illuminated

- 5) Area of Proposed Sign 34 Square Feet
- (1,2,4) Building Facade 180 Linear Feet
- (1 - 4) Street Frontage 284 Linear Feet
- (2,4,5) Height to Top of Sign 14 Feet Clearance to Grade 12 Feet
- (5) Distance from all Existing Off-Premise Signs within 600 Feet _____ Feet

Existing Signage/Type:	
Appliances 34	Sq. Ft.
Pole	112 Sq. Ft.
Flush Wall	262.5 Sq. Ft.
Total Existing:	374.5 Sq. Ft.

● FOR OFFICE USE ONLY ●		
Signage Allowed on Parcel:		
Building	360	Sq. Ft.
Free-Standing	493	Sq. Ft.
Total Allowed:	493	Sq. Ft.

COMMENTS: _____

NOTE: No sign may exceed 300 square feet. A separate sign clearance is required for each sign. Attach a sketch of proposed and existing signage including types, dimensions, lettering, abutting streets, alleys, easements, property lines, and locations. **A SEPARATE PERMIT FROM THE BUILDING DEPARTMENT IS REQUIRED.**

Edward Kowalski 12-9-97 Mike Pelletier 12/12/97
Applicant's Signature Date Community Development Approval Date

(White: Community Development) (Canary: Applicant) (Pink: Building Dept) (Goldenrod: Code Enforcement)



SIGN CLEARANCE

Community Development Department
250 North 5th Street
Grand Junction, CO 81501
(970) 244-1430

Clearance No. 63328
Date Submitted _____
FEE \$ 5.00
Tax Schedule 2970466 2945-091-
Zone C-2 00-104

K

BUSINESS NAME CIRCUIT CITY
STREET ADDRESS 2455 6+50
PROPERTY OWNER Reed Miller
OWNER ADDRESS 2455-6+50

CONTRACTOR Western Neon Sign
LICENSE NO. 2970466
ADDRESS 2495 Industrial
TELEPHONE NO. 242-7843

- 1. FLUSH WALL 2 Square Feet per Linear Foot of Building Facade
- 2. ROOF 2 Square Feet per Linear Foot of Building Facade
- 3. FREE-STANDING 2 Traffic Lanes - 0.75 Square Feet x Street Frontage
4 or more Traffic Lanes - 1.5 Square Feet x Street Frontage
- 4. PROJECTING 0.5 Square Feet per each Linear Foot of Building Facade
- 5. OFF-PREMISE See #3 Spacing Requirements; Not > 300 Square Feet or < 15 Square Feet

Externally Illuminated

Internally Illuminated

Non-Illuminated

- 1 - 5) Area of Proposed Sign 16 Square Feet
- (1,2,4) Building Facade 180 Linear Feet
- (1 - 4) Street Frontage 284 Linear Feet
- (2,4,5) Height to Top of Sign 10 Feet Clearance to Grade 8 Feet
- (5) Distance from all Existing Off-Premise Signs within 600 Feet _____ Feet

Existing Signage/Type:	
CUSTOMER Pickup 16	Sq. Ft.
Pole	112 Sq. Ft.
Flush Wall	296.5 Sq. Ft.
Total Existing:	408.5 Sq. Ft.

● FOR OFFICE USE ONLY ●		
Signage Allowed on Parcel:		
Building	360	Sq. Ft.
Free-Standing	493	Sq. Ft.
Total Allowed:	493	Sq. Ft.

COMMENTS: _____

NOTE: No sign may exceed 300 square feet. A separate sign clearance is required for each sign. Attach a sketch of proposed and existing signage including types, dimensions, lettering, abutting streets, alleys, easements, property lines, and locations. **A SEPARATE PERMIT FROM THE BUILDING DEPARTMENT IS REQUIRED.**

Edward Kowalski
Applicant's Signature

Date

Mike Palotini
Community Development Approval


12/12/97
Date

(White: Community Development)

(Canary: Applicant)


(Pink: Building Dept)

(Goldenrod: Code Enforcement)

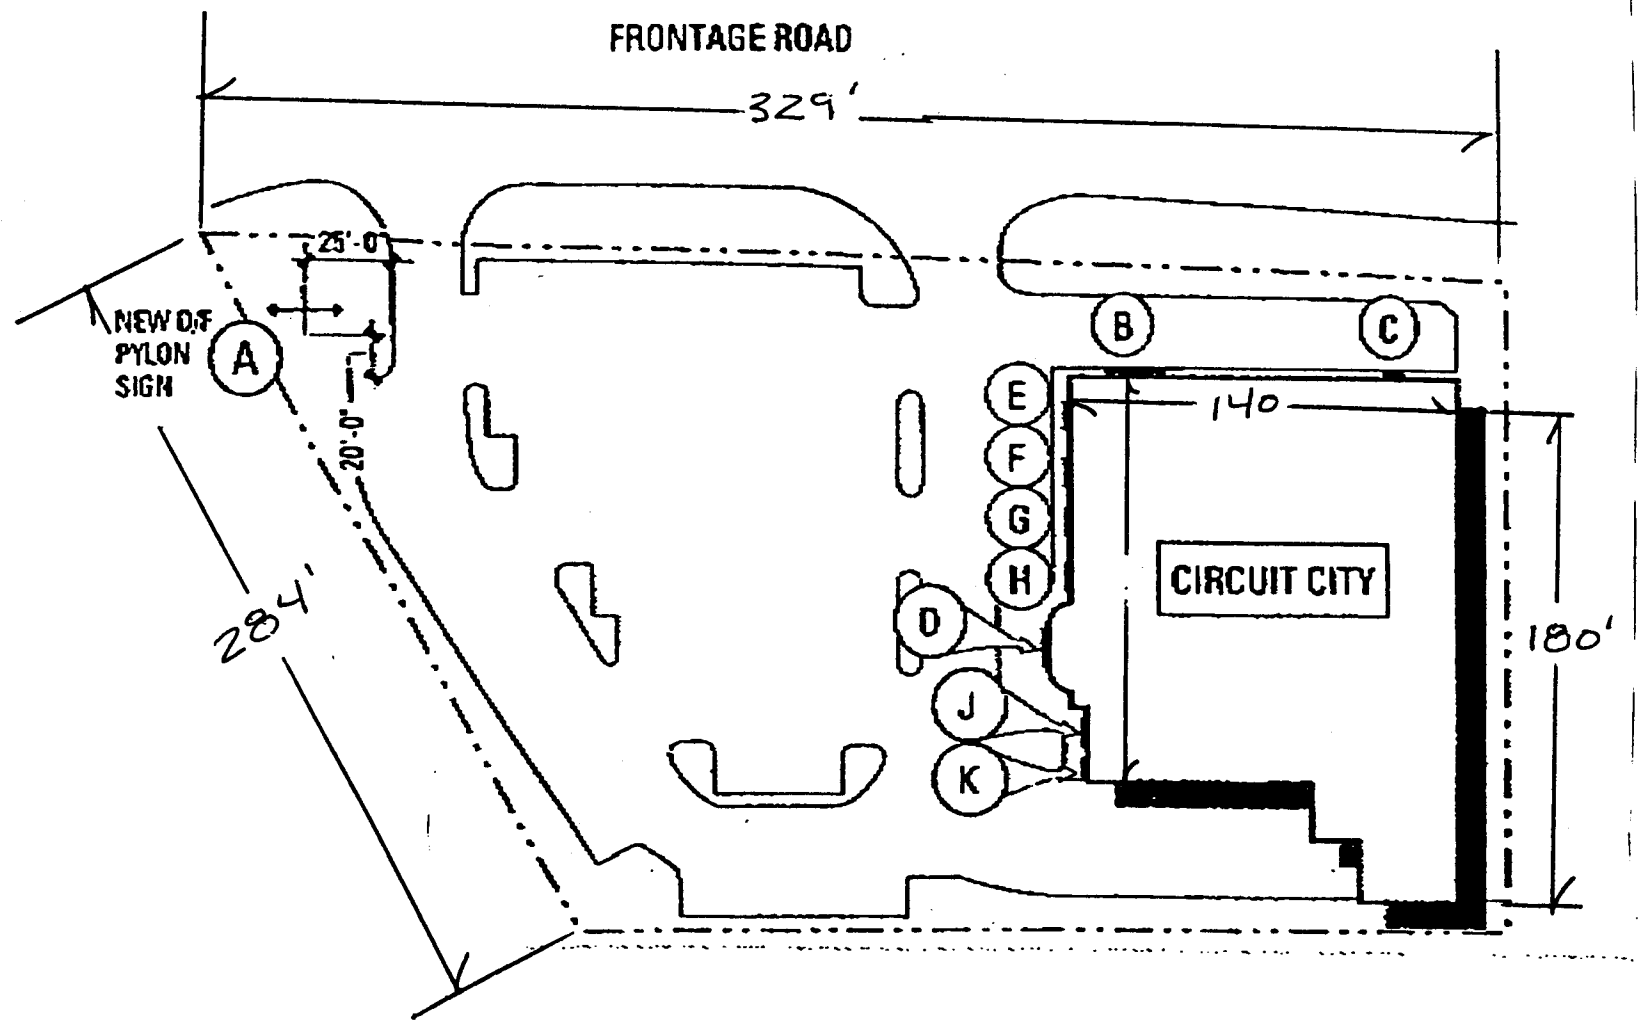


SITE PLAN

9' high x 14' 8" Long
Face Size

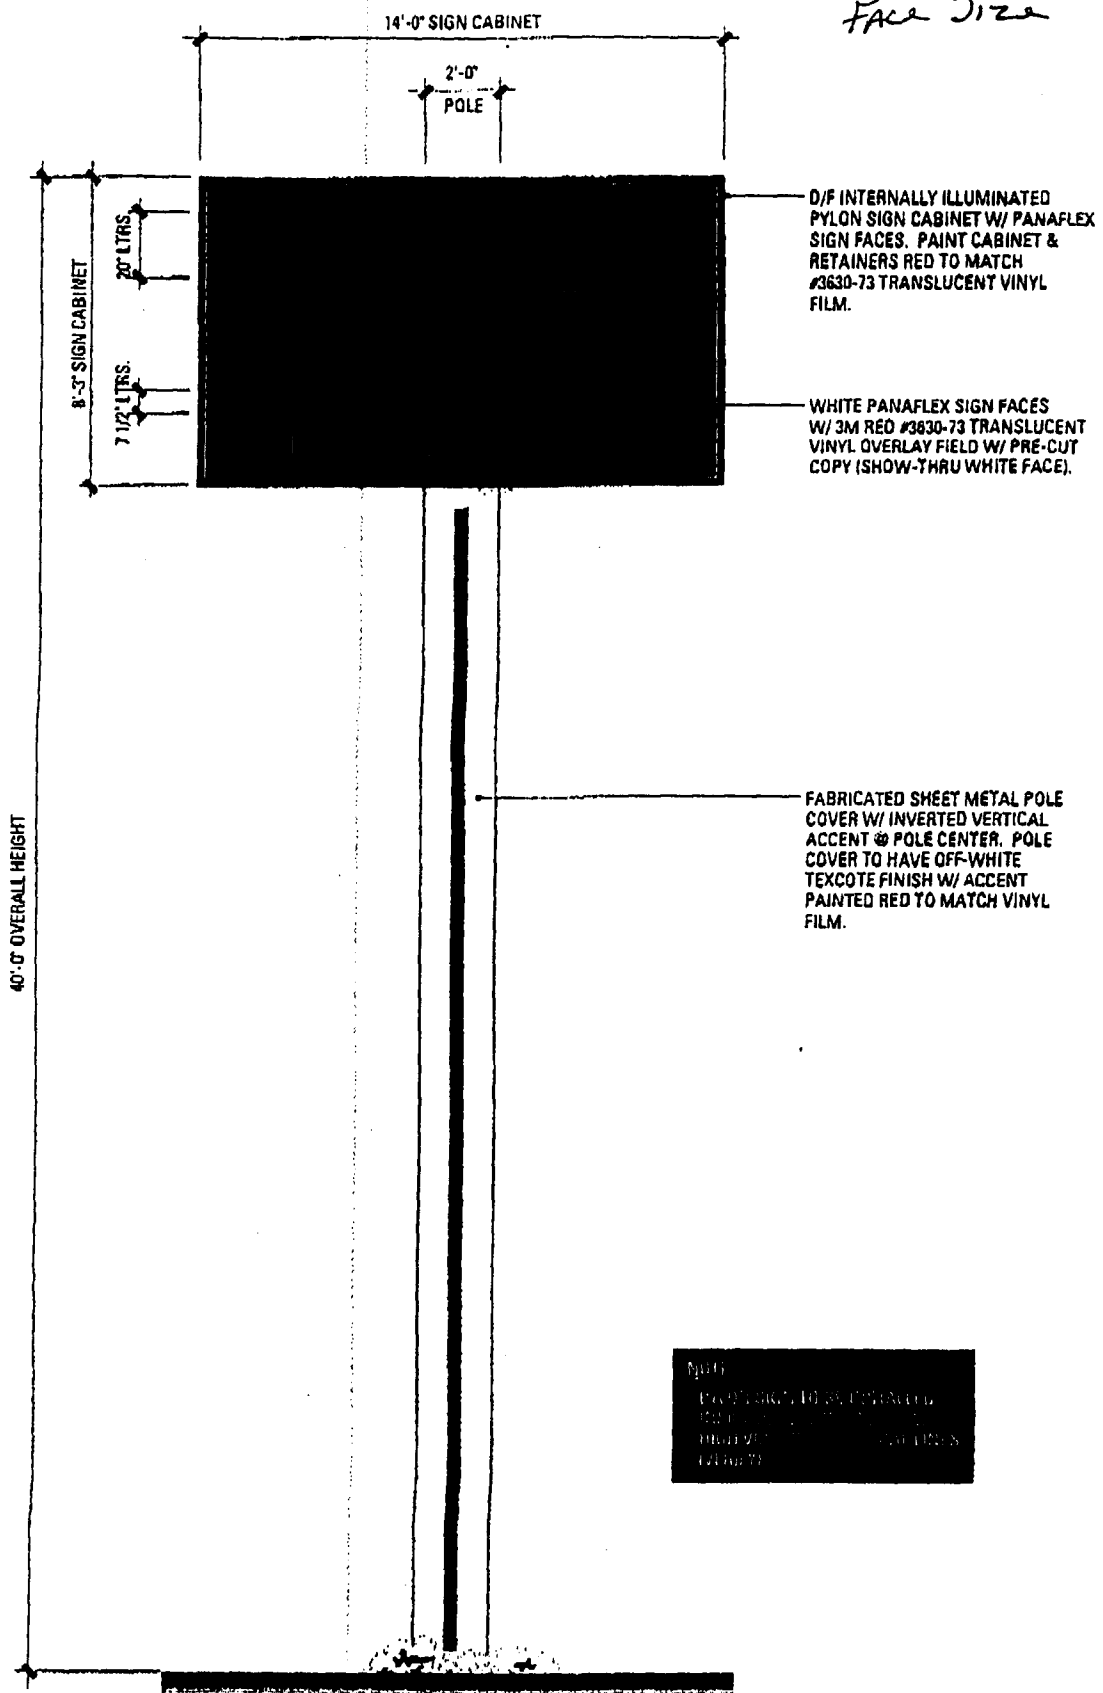

(A) NEW D/F PYLON SIGN
1/4" = 1'-0"

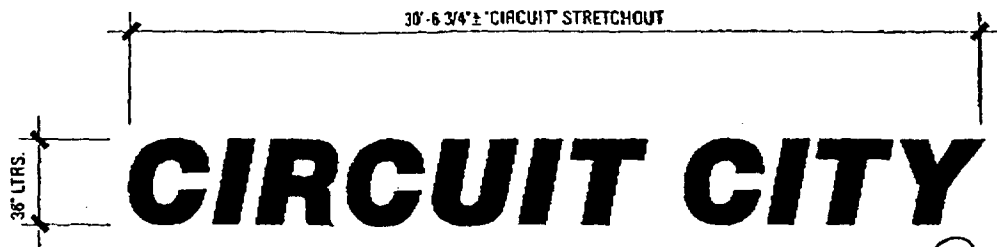


LETTERS:

SELF-CONTAINED INTERNALLY ILLUMINATED FABRICATED ALUMINUM CHANNEL LETTERS W/ .188" THK. RED #2793 ACRYLIC PLASTIC FACES & 3/4" SILVER TRIMCAP EDGES. 10" DP. RETURNS PAINTED TO MATCH SILVER MATTHEWS 41-342. 15MM CLEAR RED NEON ILLUMINATION.


ALUMINUM CHANNEL LETTERS ENLARGED LAYOUT

3/16" = 1'-0"

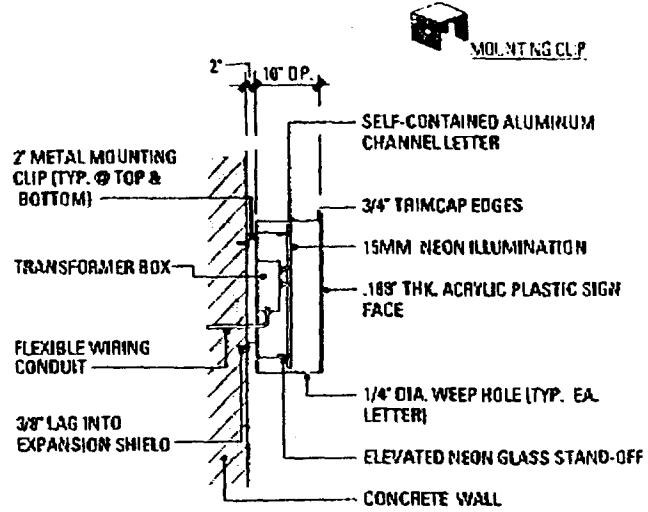

ALUMINUM CHANNEL LETTER DETAIL

1/2" = 1'-0"

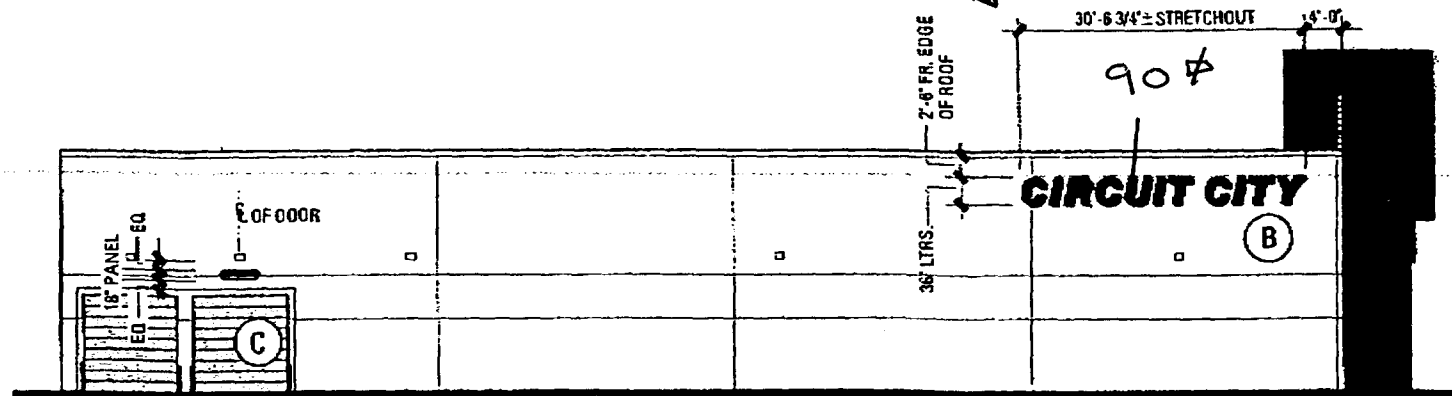


SIGN PANEL:

S/F NON-ILLUMINATED FABRICATED .090" ALUMINUM SIGN PANEL W 1 1/2" DP. RETURNS. FACE & RETURNS PAINTED TO MATCH DUPONT IMRON RED #1402. 3M SATIN ALUMINUM #7725-120 VINYL OVERLAY BORDER (5/8" WD.) & 3M #7725-10 WHITE VINYL OVERLAY COPY (TYPICAL).

NORTH ELEVATION

1/16" = 1'-0"

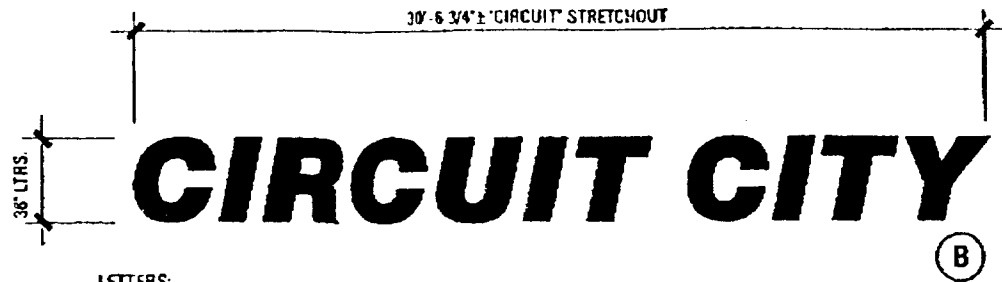


LETTERS:

SELF-CONTAINED INTERNALLY ILLUMINATED FABRICATED ALUMINUM CHANNEL LETTERS W/ .188" THK. RED #2793 ACRYLIC PLASTIC FACES & 3/4" SILVER TRIMCAP EDGES. 10" O.P. RETURNS PAINTED TO MATCH SILVER MATTHEWS 41-342. 15MM CLEAR RED NEON ILLUMINATION.


ALUMINUM CHANNEL LETTERS ENLARGED LAYOUT

3/16" = 1'-0"

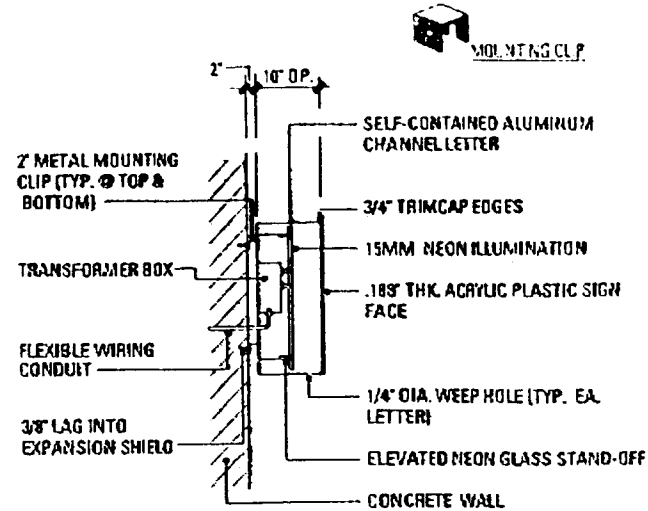

ALUMINUM CHANNEL LETTER DETAIL

1/2" = 1'-0"

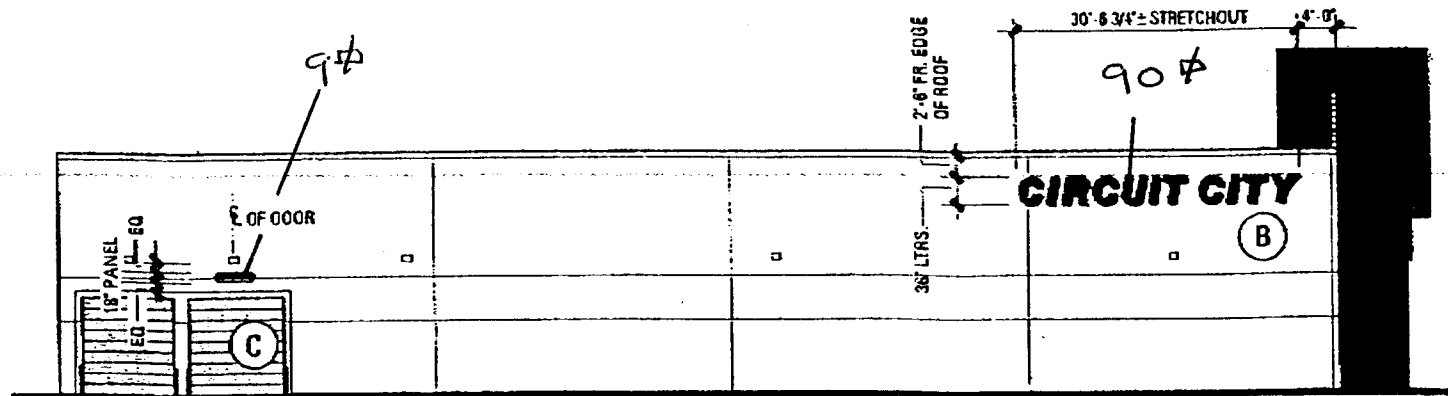


SIGN PANEL:



S/F NON-ILLUMINATED FABRICATED .030" ALUMINUM SIGN PANEL W 1 1/2" O.P. RETURNS. FACE & RETURNS PAINTED TO MATCH DUPONT IMRON RED #4402. 3M SATIN ALUMINUM #7725-120 VINYL OVERLAY BORDER (5/8" WD.) & 3M #7725-10 WHITE VINYL OVERLAY COPY (TYPICAL).

NORTH ELEVATION

1/16" = 1'-0"

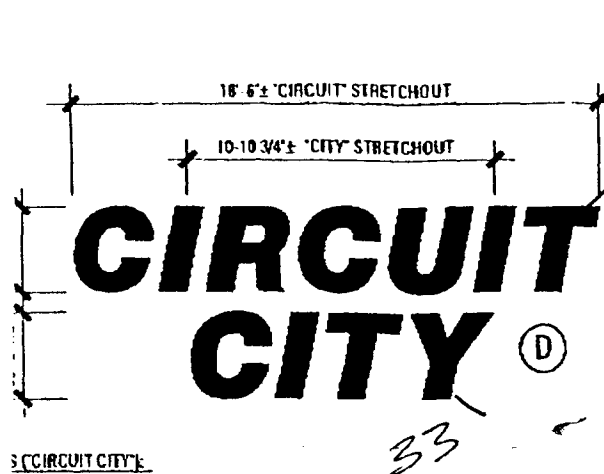

33.5


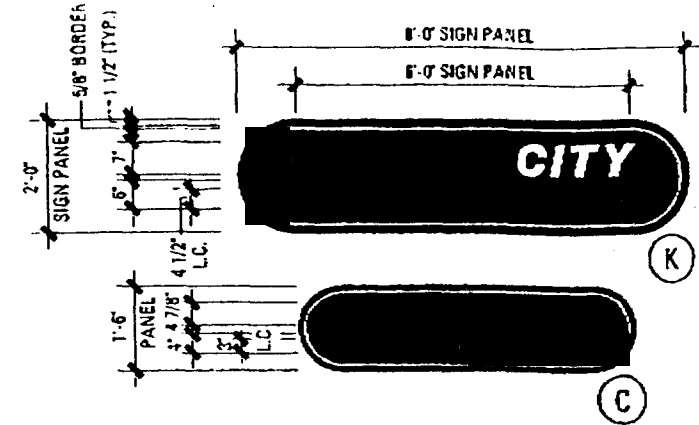
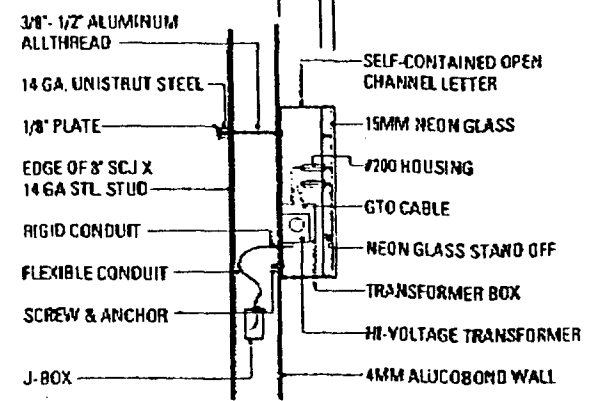


SIGN PANELS:
 S/F NON-ILLUMINATED FABRICATED .090" ALUMINUM SIGN PANEL W/ 1 1/2" DP. RETURNS. FACE & RETURNS PAINTED TO MATCH DUPONT IMRON RED #4402. 3M SATIN ALUMINUM #7725-120 VINYL OVERLAY B ORDER (5/8" WD.) & 3M #7725-10 WHITE VINYL OVERLAY COPY (TYPICAL).

OPEN CHANNEL LETTERS ENLARGED LAYOUT

OPEN CHANNEL LETTER DETAIL

S/F WALL SIGN PANELS

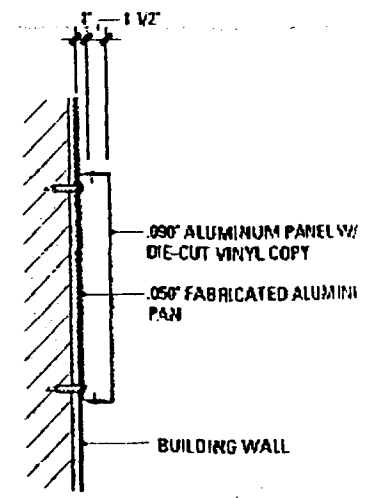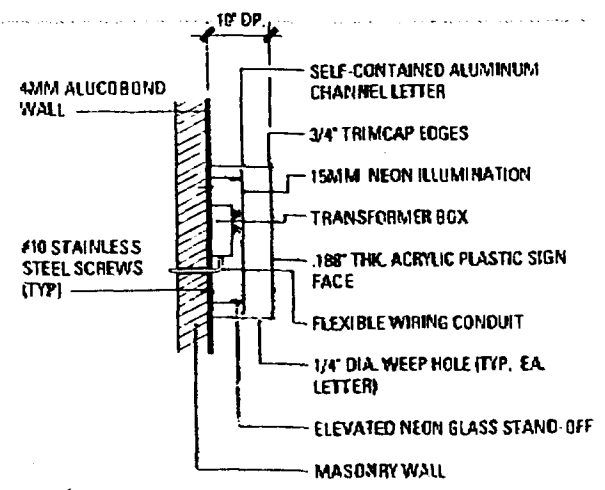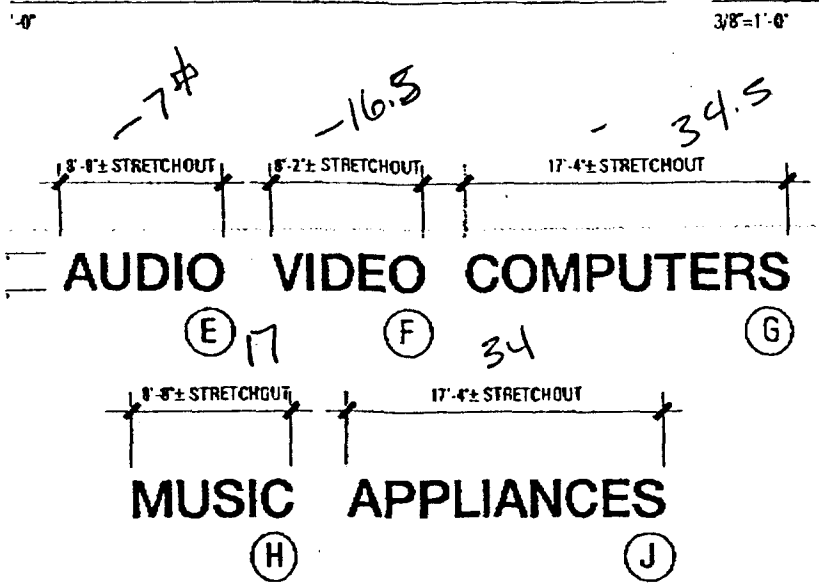

LETTERS:
 NEW SELF-CONTAINED INTERNALLY ILLUMINATED FABRICATED ALUMINUM CHANNEL LETTERS W/ .188" THK WHITE #7328 ACRYLIC PLASTIC FACES & 3/4" SILVER TRIMCAP EDGES. 15MM WHITE NEON ILLUMINATION. 10" DP. RETURNS PAINTED TO MATCH SILVER MATTHEWS 41-342. LETTERS TO BE SURFACE MOUNTED TO ALUCOBOND PANELS (AS PER DETAIL).


ALUMINUM CHANNEL LETTER DETAIL

SIGN PANEL DETAIL

1 1/2" = 1'-0"


NOT TO SCALE

ALUMINUM CHANNEL LETTERS ENLARGED LAYOUT

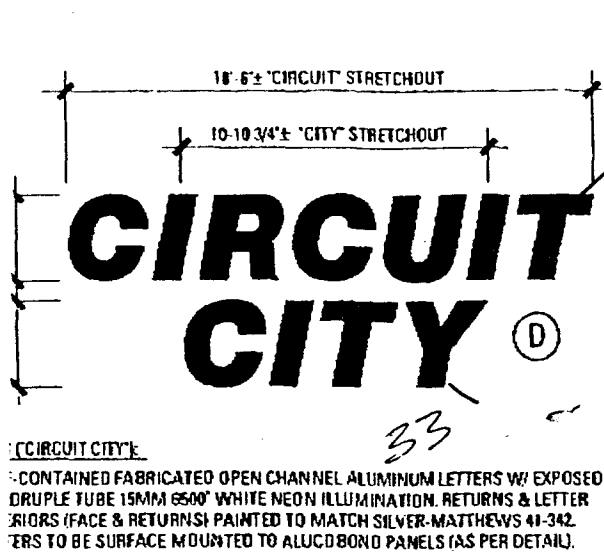


CIRCUIT CITY:
CONTAINED FABRICATED OPEN CHANNEL ALUMINUM LETTERS W/ EXPOSED DRUPLE TUBE 15MM Ø500° WHITE NEON ILLUMINATION. RETURNS & LETTER BORDERS (FACE & RETURNS) PAINTED TO MATCH SILVER-MATTHEWS 41-342. LETTERS TO BE SURFACE MOUNTED TO ALUCOBOND PANELS (AS PER DETAIL).

OPEN CHANNEL LETTERS ENLARGED LAYOUT

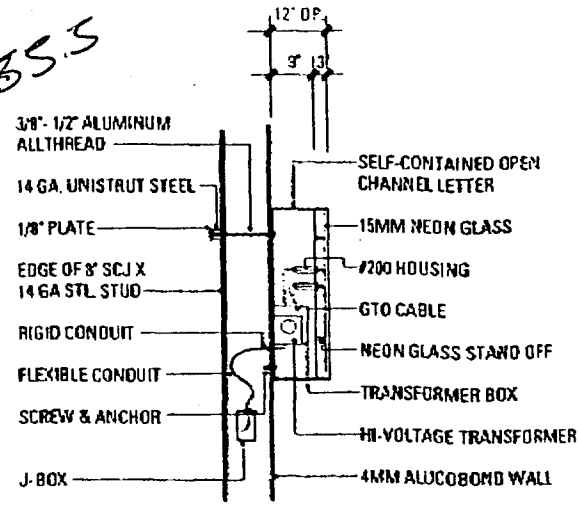

OPEN CHANNEL LETTER DETAIL


3/8"=1'-0"

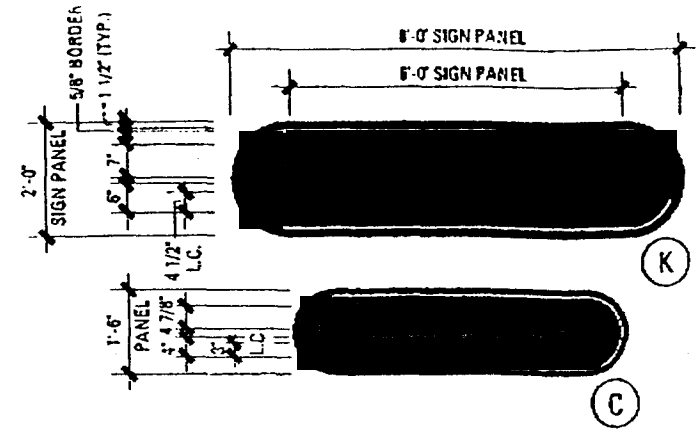

SIGN PANELS:
S/F NON-ILLUMINATED FABRICATED Ø90° ALUMINUM SIGN PANEL W 1 1/2" DP. RETURNS, FACE & RETURNS PAINTED TO MATCH DUPONT IMIRON RED #4402. 3M SATIN ALUMINUM #7725-120 VINYL OVERLAY BORDER (5/8" WD.) & 3M #7725-10 WHITE VINYL OVERLAY COPY (TYPICAL).


S/F WALL SIGN PANELS

3/8"=1'-0"

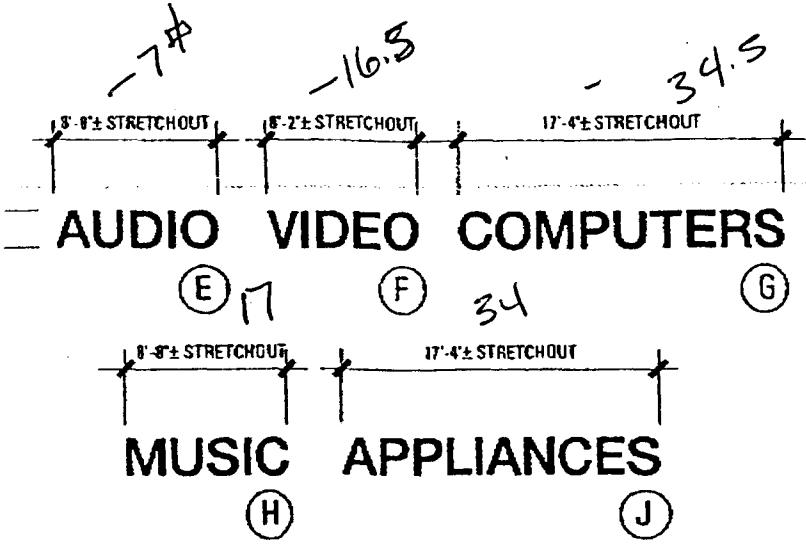


LETTERS:
NEW SELF-CONTAINED INTERNALLY ILLUMINATED FABRICATED ALUMINUM CHANNEL LETTERS W/ 188° THK WHITE #7328 ACRYLIC PLASTIC FACES & 3/4" SILVER TRIMCAP EDGES. 15MM WHITE NEON ILLUMINATION. 10" DP. RETURNS PAINTED TO MATCH SILVER MATTHEWS 41-342. LETTERS TO BE SURFACE MOUNTED TO ALUCOBOND PANELS (AS PER DETAIL).

ALUMINUM CHANNEL LETTERS ENLARGED LAYOUT

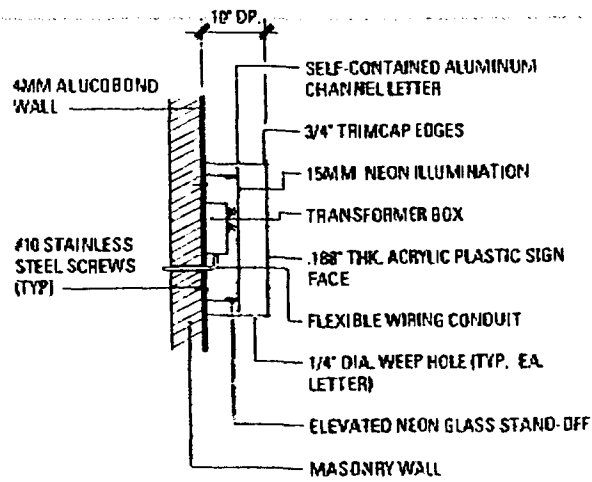

ALUMINUM CHANNEL LETTER DETAIL

1/2"=1'-0"

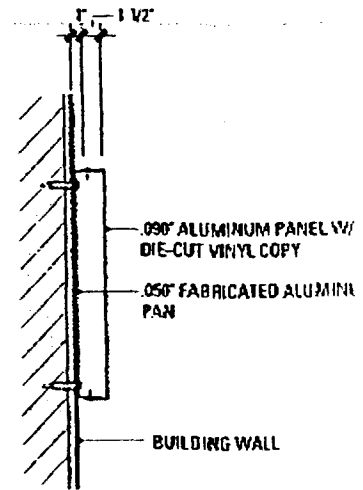


SIGN PANEL DETAIL

NOT TO SCALE

213.5 TOTAL FACADE

88.5 ϕ TOTAL

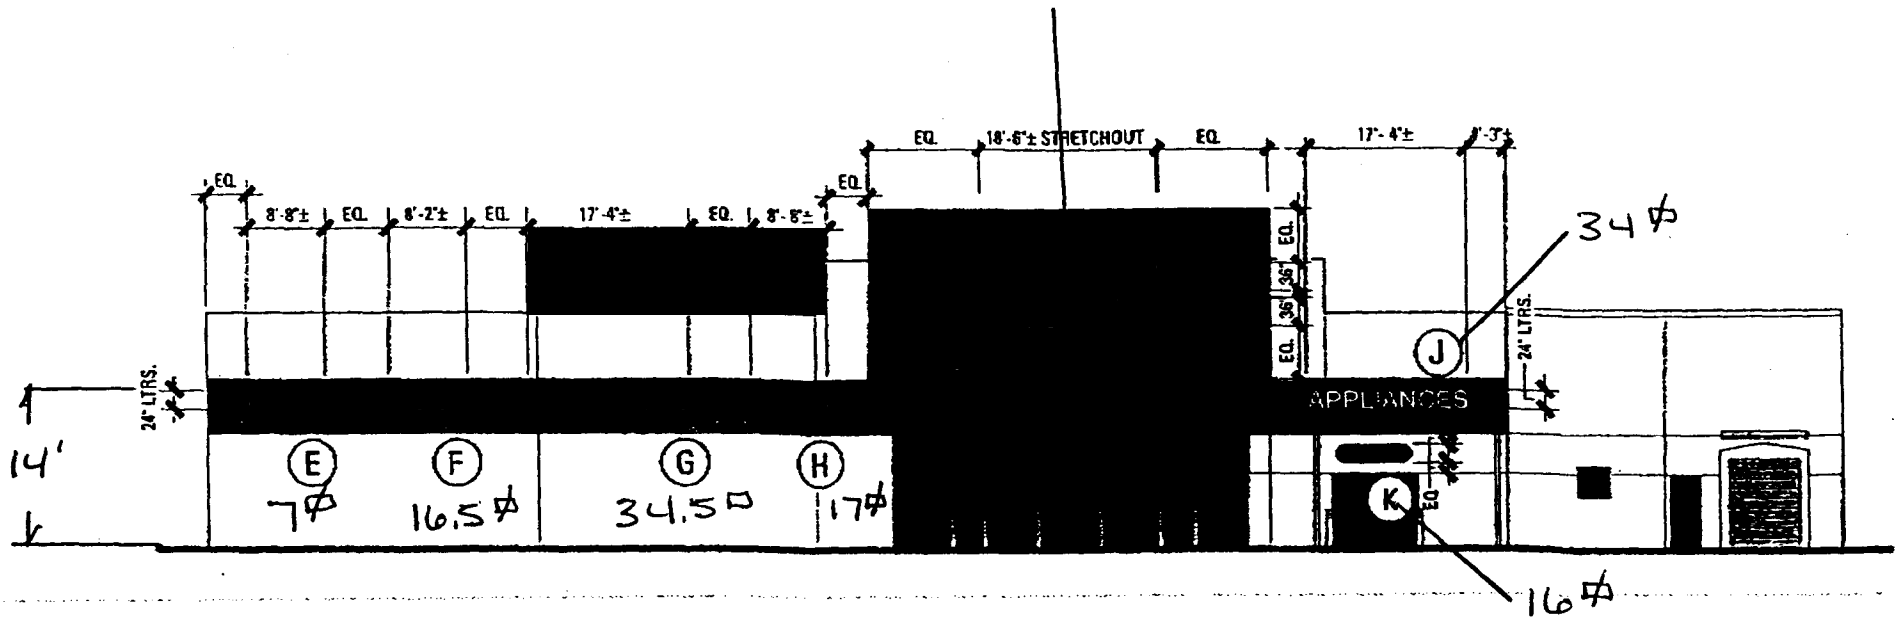

LETTERS [AUDIO, VIDEO, COMPUTERS, MUSIC, APPLIANCES]:

SELF-CONTAINED INTERNALLY ILLUMINATED FABRICATED ALUMINUM CHANNEL LETTERS W/ 1/8" THK. WHITE #7328 ACRYLIC PLASTIC FACES & 3/4" SILVER TRIMCAP EDGES. 15MM WHITE NEON ILLUMINATION. 10" DP. RETURNS PAINTED TO MATCH SILVER MATTHEWS 41-342. LETTERS TO BE SURFACE MOUNTED TO ALUCOBOND PANELS (AS PER DETAIL).

LETTERS [CIRCUIT CITY]:

SELF-CONTAINED FABRICATED OPEN ALUMINUM CHANNEL LETTERS W/ EXPOSED QUADRUPLE TUBE 15MM 6500° WHITE NEON ILLUMINATION. RETURNS & LETTER INTERIORS (FACE & RETURNS) PAINTED TO MATCH SILVER-MATTHEWS 41-342. LETTERS TO BE SURFACE MOUNTED TO ALUCOBOND PANELS.

SIGN PANEL:


S/F NON-ILLUMINATED FABRICATED .090" ALUMINUM SIGN PANEL W/ 1/2" DP. RETURNS. FACE & RETURNS PAINTED TO MATCH DUPONT IMRON RED #4402. 3M SATIN ALUMINUM #7725-120 VINYL OVERLAY BORDER (5/8" W/O.) & 3M #7725-10 WHITE VINYL OVERLAY COPY.

WEST ELEVATION

1/16" = 1'-0"

213.5 TOTAL FACADE

88.5 # TOTAL

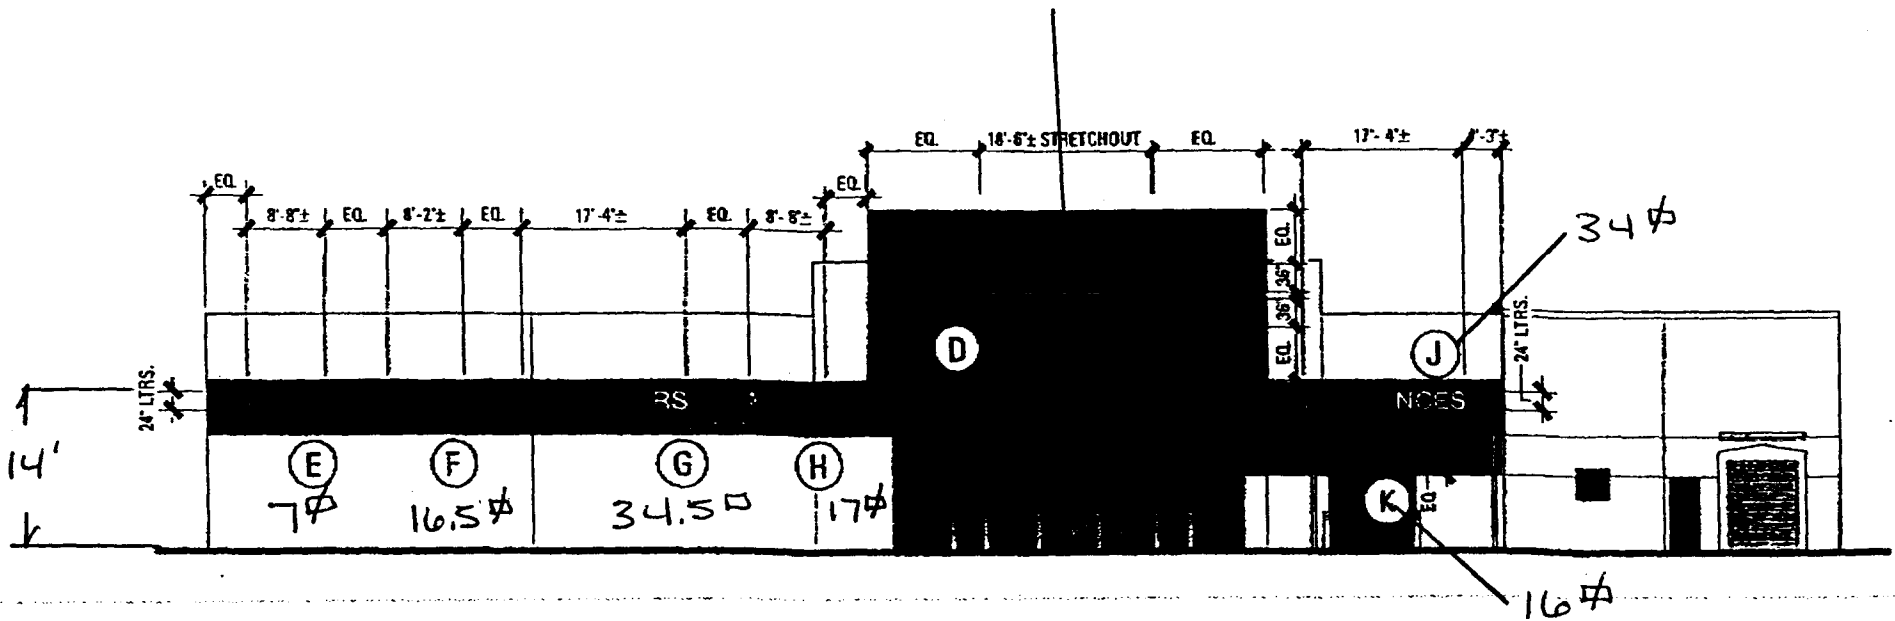

LETTERS ["AUDIO", "VIDEO", "COMPUTERS", "MUSIC", "APPLIANCES"]:

SELF-CONTAINED INTERNALLY ILLUMINATED FABRICATED ALUMINUM CHANNEL LETTERS W/ 1/8" THK. WHITE #7321 ACRYLIC PLASTIC FACES & 3/4" SILVER TRIMCAP EDGES. 15MM WHITE NEON ILLUMINATION. 16" DP. RETURNS PAINTED TO MATCH SILVER MATTHEWS 41-342. LETTERS TO BE SURFACE MOUNTED TO ALUCOBOND PANELS (AS PER DETAIL).

LETTERS ["CIRCUIT CITY"]:


SELF-CONTAINED FABRICATED OPEN ALUMINUM CHANNEL LETTERS W/ EXPOSED QUADRUPE TUBE 15MM 6500° WHITE NEON ILLUMINATION. RETURNS & LETTER INTERIORS (FACE & RETURNS) PAINTED TO MATCH SILVER-MATTHEWS 41-342. LETTERS TO BE SURFACE MOUNTED TO ALUCOBOND PANELS.

SIGN PANEL:

S/F NON-ILLUMINATED FABRICATED .090" ALUMINUM SIGN PANEL W/ 1 1/2" DP. RETURNS. FACE & RETURNS PAINTED TO MATCH DUPONT IMRON RED #4402. 3M SATIN ALUMINUM #7725-120 VINYL OVERLAY BORDER (5/8" WD.) & 3M #7725-10 WHITE VINYL OVERLAY COPY.

WEST ELEVATION

1/16" = 1'-0"

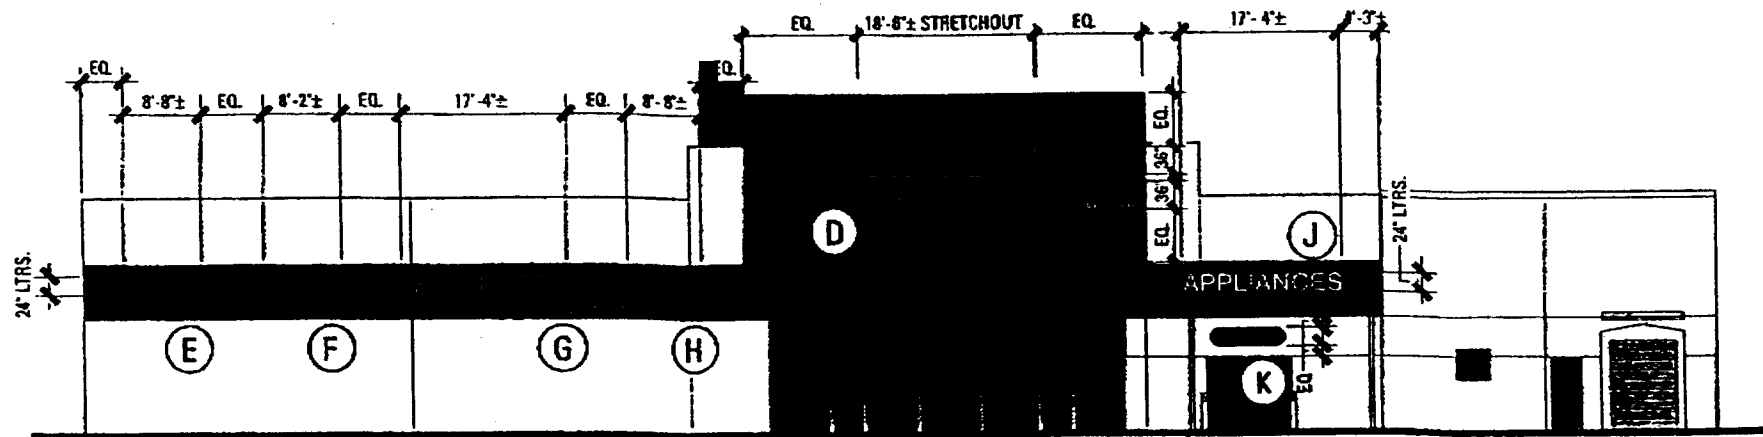

LETTERS ('AUDIO', 'VIDEO', 'COMPUTERS', 'MUSIC', 'APPLIANCES'):

SELF-CONTAINED INTERNALLY ILLUMINATED FABRICATED ALUMINUM CHANNEL LETTERS W/ 1/8" THK. WHITE #7328 ACRYLIC PLASTIC FACES & 3/4" SILVER TRIMCAP EDGES. 15MM WHITE NEON ILLUMINATION. 10" DP. RETURNS PAINTED TO MATCH SILVER MATTHEWS 41-342. LETTERS TO BE SURFACE MOUNTED TO ALUCOBOND PANELS (AS PER DETAIL).

LETTERS ('CIRCUIT CITY'):


SELF-CONTAINED FABRICATED OPEN ALUMINUM CHANNEL LETTERS W/ EXPOSED QUADRUPLE TUBE 15MM 6500" WHITE NEON ILLUMINATION. RETURNS & LETTER INTERIORS (FACE & RETURNS) PAINTED TO MATCH SILVER-MATTHEWS 41-342. LETTERS TO BE SURFACE MOUNTED TO ALUCOBOND PANELS.

SIGN PANEL:

5/8" NON-ILLUMINATED FABRICATED .090" ALUMINUM SIGN PANEL W/ 1 1/2" DP. RETURNS. FACE & RETURNS PAINTED TO MATCH DUPONT IMRON RED #4402 3M SATIN ALUMINUM #7725-120 VINYL OVERLAY BORDER (5/8" WD.) & 3M #7725-10 WHITE VINYL OVERLAY COPY.

WEST ELEVATION

1/16" = 1'-0"

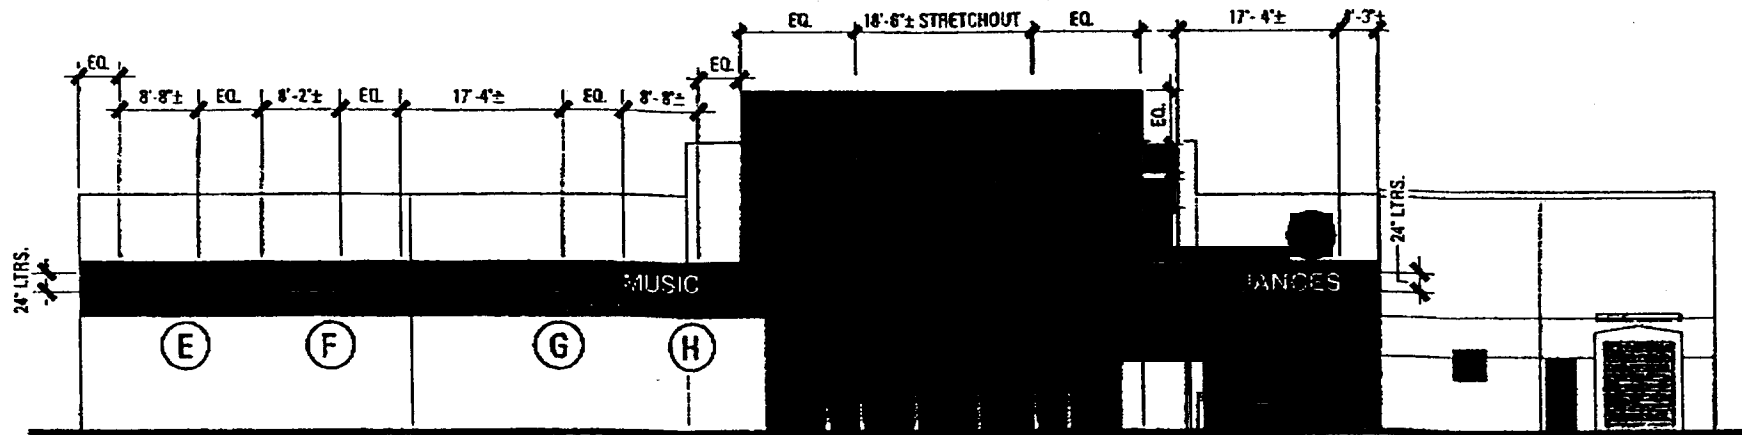

LETTERS ("AUDIO", "VIDEO", "COMPUTERS", "MUSIC", "APPLIANCES"):

SELF-CONTAINED INTERNALLY ILLUMINATED FABRICATED ALUMINUM CHANNEL LETTERS W/ 1/8" THK. WHITE #7328 ACRYLIC PLASTIC FACES & 3/4" SILVER TRIMCAP EDGES. 15MM WHITE NEON ILLUMINATION. 1/8" DP. RETURNS PAINTED TO MATCH SILVER MATTHEWS 41-342. LETTERS TO BE SURFACE MOUNTED TO ALUCOBOND PANELS (AS PER DETAIL).

LETTERS ("CIRCUIT CITY"):

SELF-CONTAINED FABRICATED OPEN ALUMINUM CHANNEL LETTERS W/ EXPOSED QUADRUPLE TUBE 15MM 6500° WHITE NEON ILLUMINATION. RETURNS & LETTER INTERIORS (FACE & RETURNS) PAINTED TO MATCH SILVER-MATTHEWS 41-342. LETTERS TO BE SURFACE MOUNTED TO ALUCOBOND PANELS.

SIGN PANEL:


S/F NON-ILLUMINATED FABRICATED .090" ALUMINUM SIGN PANEL W/ 1 1/2" DP. RETURNS. FACE & RETURNS PAINTED TO MATCH DUPONT IMIRON RED #4402. 3M SATIN ALUMINUM #7725-120 VINYL OVERLAY BORDER (5/8" W/O.) & 3M #7725-10 WHITE VINYL OVERLAY COPY.

WEST ELEVATION

1/16" = 1'-0"

213.5 TOTAL FACADE

88.5 # TOTAL

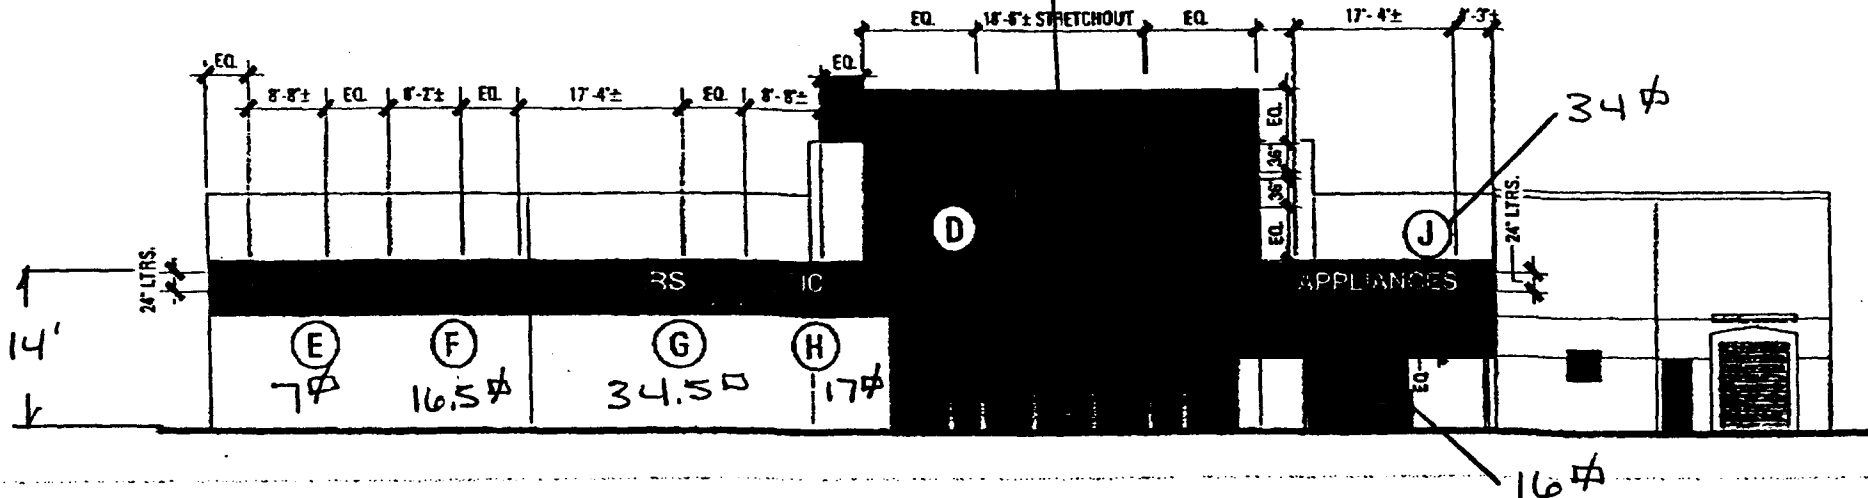

LETTERS 'AUDIO', 'VIDEO', 'COMPUTERS', 'MUSIC', 'APPLIANCES':

SELF-CONTAINED INTERNALLY ILLUMINATED FABRICATED ALUMINUM CHANNEL LETTERS W/ 1/8" THK WHITE #7321 ACRYLIC PLASTIC FACES & 3/4" SILVER TRIMCAP EDGES. 15MM WHITE NEON ILLUMINATION. 1/2" DP. RETURNS PAINTED TO MATCH SILVER-MATTHEWS 41-342. LETTERS TO BE SURFACE MOUNTED TO ALUCOBOND PANELS (AS PER DETAIL).

LETTERS ('CIRCUIT CITY'):

SELF-CONTAINED FABRICATED OPEN ALUMINUM CHANNEL LETTERS W/ EXPOSED QUADRUPLE TUBE 15MM 6500° WHITE NEON ILLUMINATION. RETURNS & LETTER INTERIORS (FACE & RETURNS) PAINTED TO MATCH SILVER-MATTHEWS 41-342. LETTERS TO BE SURFACE MOUNTED TO ALUCOBOND PANELS.

SIGN PANEL:


3/8" NON-ILLUMINATED FABRICATED .090" ALUMINUM SIGN PANEL W/ 1/2" DP. RETURNS. FACE & RETURNS PAINTED TO MATCH DUPONT IMRON RED #4402. 3M SATIN ALUMINUM #7725-128 VINYL OVERLAY BORDER (5/8" WD.) & 3M #7725-10 WHITE VINYL OVERLAY COPY.

WEST ELEVATION

1/16" = 1'-0"

213.5 TOTAL FACADE

88.5 # TOTAL

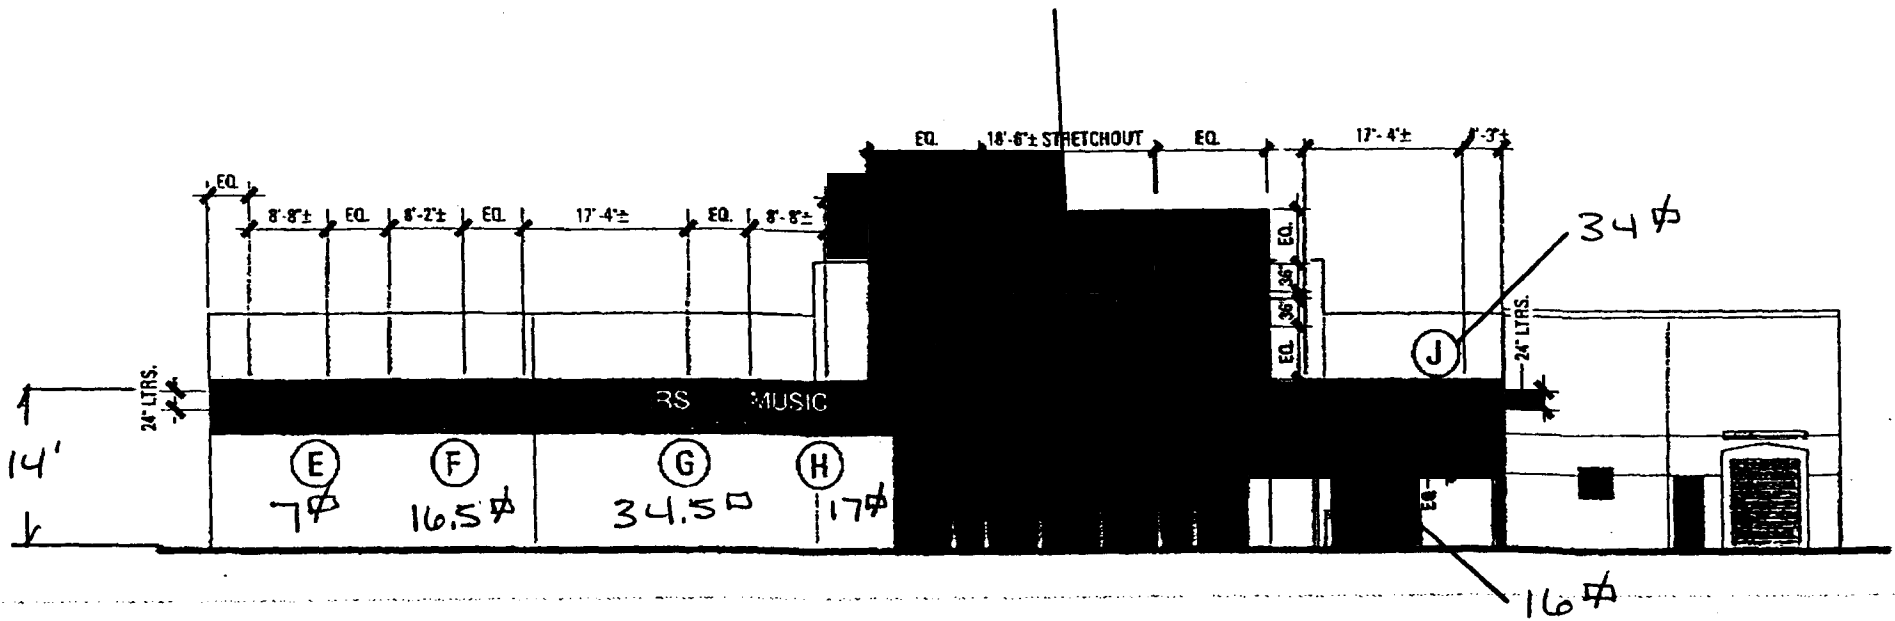

LETTERS [AUDIO, VIDEO, COMPUTERS, MUSIC, APPLIANCES]:

SELF-CONTAINED INTERNALLY ILLUMINATED FABRICATED ALUMINUM CHANNEL LETTERS W/ 1/8" THK. WHITE #321 ACRYLIC PLASTIC FACES & 3/4" SILVER TRIMCAP EDGES. 15MM WHITE NEON ILLUMINATION. 10" DP. RETURNS PAINTED TO MATCH SILVER MATTHEWS 41-342. LETTERS TO BE SURFACE MOUNTED TO ALUCOBOND PANELS (AS PER DETAIL).

LETTERS [CIRCUIT CITY]:

SELF-CONTAINED FABRICATED OPEN ALUMINUM CHANNEL LETTERS W/ EXPOSED QUADRUPLE TUBE 15MM 6500° WHITE NEON ILLUMINATION. RETURNS & LETTER INTERIORS (FACE & RETURNS) PAINTED TO MATCH SILVER-MATTHEWS 41-342. LETTERS TO BE SURFACE MOUNTED TO ALUCOBOND PANELS.

SIGN PANEL:


S/F NON-ILLUMINATED FABRICATED .090" ALUMINUM SIGN PANEL W/ 1 1/2" DP. RETURNS. FACE & RETURNS PAINTED TO MATCH DUPONT IMRON RED #4402 3M SATIN ALUMINUM #7725-120 VINYL OVERLAY BORDER (5/8" WD.) & 3M #7725-10 WHITE VINYL OVERLAY COPY.

WEST ELEVATION

1/16" = 1'-0"

213.5 TOTAL FACADE

88.5 # TOTAL

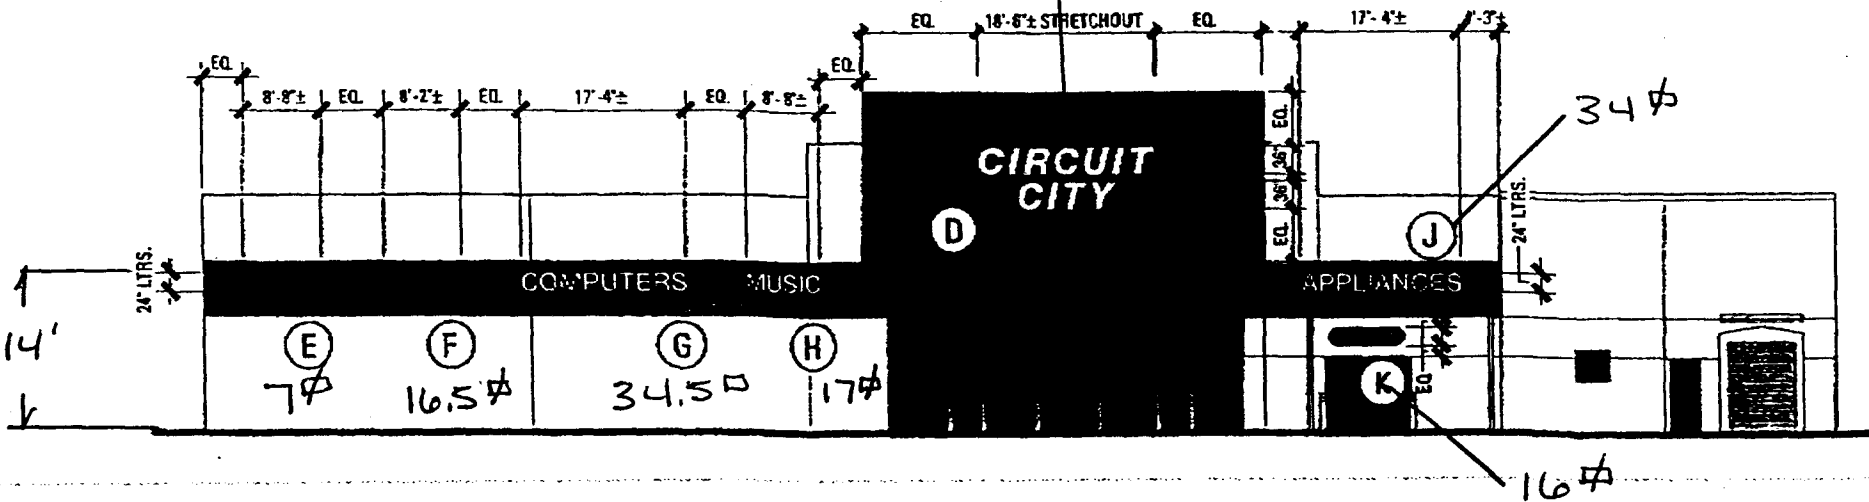

LETTERS (AUDIO, VIDEO, COMPUTERS, MUSIC, APPLIANCES):

SELF-CONTAINED INTERNALLY ILLUMINATED FABRICATED ALUMINUM CHANNEL LETTERS W/ 1/8" THK. WHITE #7328 ACRYLIC PLASTIC FACES & 3/4" SILVER TRIMCAP EDGES. 15MM WHITE NEON ILLUMINATION. 10" DP. RETURNS PAINTED TO MATCH SILVER MATTHEWS 41-342. LETTERS TO BE SURFACE MOUNTED TO ALUCOBOND PANELS (AS PER DETAIL).

LETTERS (CIRCUIT CITY):




SELF-CONTAINED FABRICATED OPEN ALUMINUM CHANNEL LETTERS W/ EXPOSED QUADRUPLE TUBE 15MM 6500" WHITE NEON ILLUMINATION. RETURNS & LETTER INTERIORS (FACE & RETURNS) PAINTED TO MATCH SILVER-MATTHEWS 41-342. LETTERS TO BE SURFACE MOUNTED TO ALUCOBOND PANELS.

SIGN PANEL:

5/8" NON-ILLUMINATED FABRICATED .090" ALUMINUM SIGN PANEL W/ 1 1/2" DP. RETURNS. FACE & RETURNS PAINTED TO MATCH DUPONT IMRON RED #4402. 3M SATIN ALUMINUM #7725-120 VINYL OVERLAY BORDER (5/8" WD.) & 3M #7725-10 WHITE VINYL OVERLAY COPY.

WEST ELEVATION

1/16" = 1'-0"

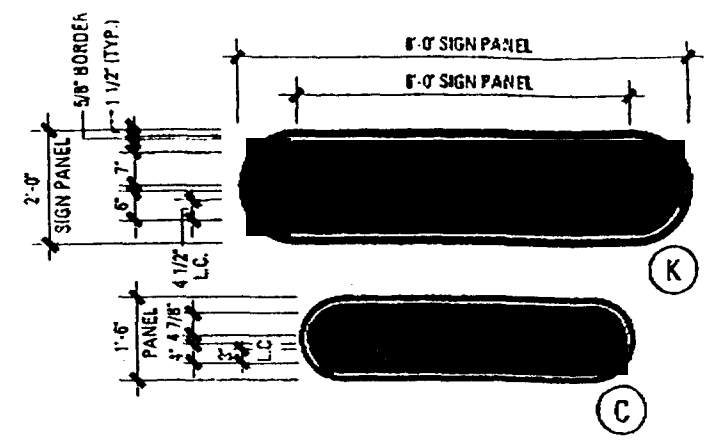
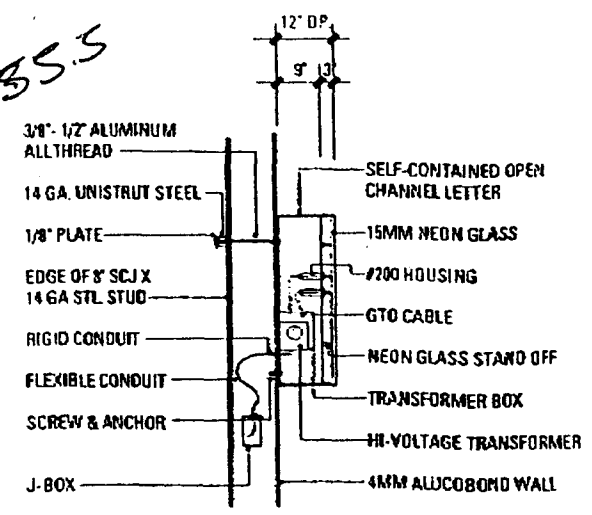
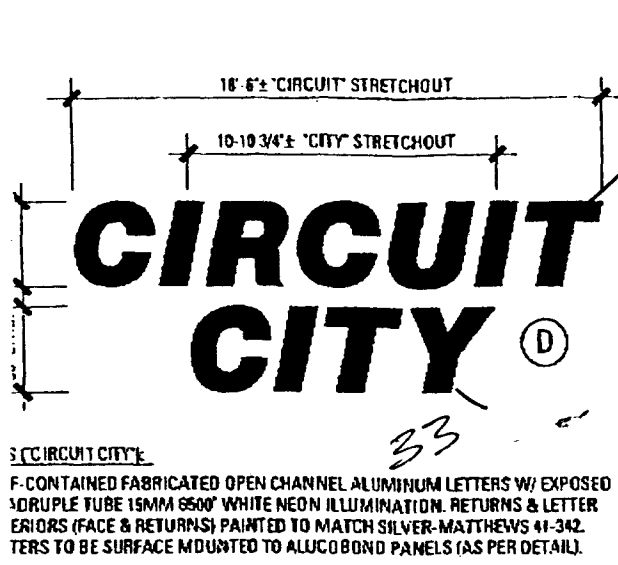


SIGN PANELS:
S/F NON-ILLUMINATED FABRICATED .090" ALUMINUM SIGN PANEL W/ 1 1/2" DP. RETURNS. FACE & RETURNS PAINTED TO MATCH DUPONT IMRON RED #4402, 3M SATIN ALUMINUM #7725-120 VINYL OVERLAY BORDER (5/8" WD.) & 3M #7725-10 WHITE VINYL OVERLAY COPY (TYPICAL).

CHANNEL LETTERS ENLARGED LAYOUT

OPEN CHANNEL LETTER DETAIL

S/F WALL SIGN PANELS

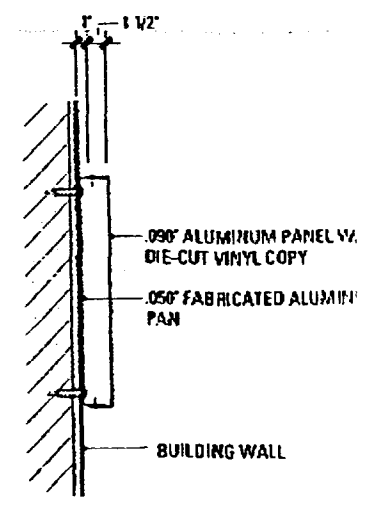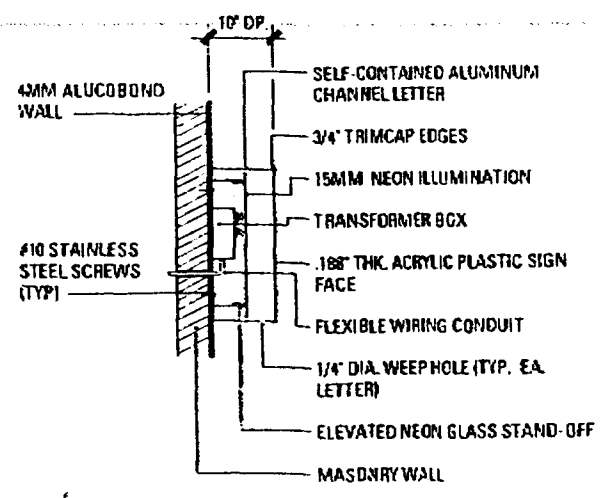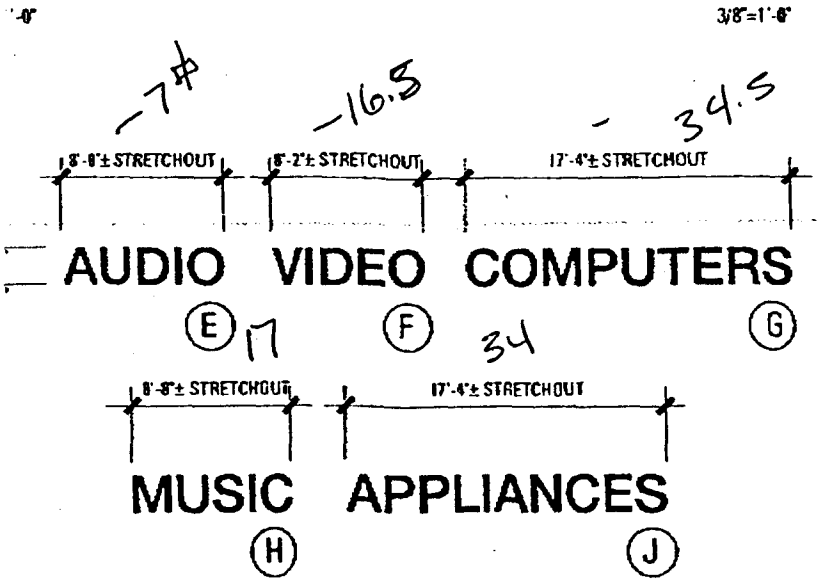

LETTERS:
NEW SELF-CONTAINED INTERNALLY ILLUMINATED FABRICATED ALUMINUM CHANNEL LETTERS W/ .188" THK. WHITE #7328 ACRYLIC PLASTIC FACES & 3/4" SILVER TRIMCAP EDGES. 15MM WHITE NEON ILLUMINATION. 10" DP. RETURNS PAINTED TO MATCH SILVER MATTHEWS 41-342. LETTERS TO BE SURFACE MOUNTED TO ALUCOBOND PANELS (AS PER DETAIL).

ALUMINUM CHANNEL LETTERS ENLARGED LAYOUT

ALUMINUM CHANNEL LETTER DETAIL

SIGN PANEL DETAIL

1/2" = 1'-0"

NOT TO SCALE