



SIGN PERMIT

284 EX (A)

Community Development Department
250 North 5th Street
Grand Junction, CO 81501
(970) 244-1430

Permit No. _____
Date Submitted 5-30-00
FEE \$ 2500
Tax Schedule 2943-073-00-214
Zone C-1

BUSINESS NAME WELLS FARGO
STREET ADDRESS 2808 NORTH AVE
PROPERTY OWNER SAME
OWNER ADDRESS _____

CONTRACTOR BUD'S SIGNS
LICENSE NO. 2200100
ADDRESS 1055 UTE
TELEPHONE NO. 245-7700

- 1. FLUSH WALL 2 Square Feet per Linear Foot of Building Facade
- Face Change Only (2,3 & 4):**
- 2. ROOF 2 Square Feet per Linear Foot of Building Facade
- 3. FREE-STANDING 2 Traffic Lanes - 0.75 Square Feet x Street Frontage
- 4 or more Traffic Lanes - 1.5 Square Feet x Street Frontage
- 4. PROJECTING 0.5 Square Feet per each Linear Foot of Building Facade

Existing Externally or Internally Illuminated - No Change in Electrical Service Non-Illuminated

(1 - 4) Area of Proposed Sign 60 Square Feet
(1,2,4) Building Facade 90 Linear Feet
(1 - 4) Street Frontage 448 Linear Feet COURT RD.
(2,3,4) Height to Top of Sign 38 Feet Clearance to Grade 35± Feet

Existing Signage/Type:	
	Sq. Ft.
	Sq. Ft.
	Sq. Ft.
Total Existing:	<u> </u> Sq. Ft.

● FOR OFFICE USE ONLY ●	
Signage Allowed on Parcel:	<u>300±</u>
Building	<u>216</u> Sq. Ft.
Free-Standing	<u>300±</u> <u>381</u> Sq. Ft.
Total Allowed:	Sq. Ft.

COMMENTS: _____

NOTE: No sign may exceed 300 square feet. A separate sign permit is required for each sign. Attach a sketch of proposed and existing signage including types, dimensions, lettering, abutting streets, alleys, easements, property lines, and locations. Roof signs shall be manufactured such that no guy wires, braces or supports shall be visible.

[Signature] 5-30-00 [Signature] 4/13/00
Applicant's Signature Date Community Development Approval Date

(White: Community Development) (Canary: Applicant) (Pink: Code Enforcement)



SIGN PERMIT

RBC (B)

Community Development Department
250 North 5th Street
Grand Junction, CO 81501
(970) 244-1430

Permit No. _____
Date Submitted 5-30-00
FEE \$ 5
Tax Schedule 2943-073-00-214
Zone C-1

BUSINESS NAME WELLS FARGO
STREET ADDRESS 2808 NORTH AVE
PROPERTY OWNER SAME
OWNER ADDRESS _____

CONTRACTOR BUD'S SIGNS
LICENSE NO. 2200100
ADDRESS 1055 UTE
TELEPHONE NO. 245-7700

- 1. FLUSH WALL 2 Square Feet per Linear Foot of Building Facade
- 2. ROOF 2 Square Feet per Linear Foot of Building Facade
- 3. FREE-STANDING 2 Traffic Lanes - 0.75 Square Feet x Street Frontage
4 or more Traffic Lanes - 1.5 Square Feet x Street Frontage
- 4. PROJECTING 0.5 Square Feet per each Linear Foot of Building Facade

Existing Externally or Internally Illuminated - No Change in Electrical Service Non-Illuminated


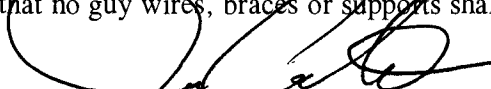
- (1 - 4) Area of Proposed Sign 60 Square Feet
- (1,2,4) Building Facade 108 Linear Feet
- (1 - 4) Street Frontage 284.44 Linear Feet > NORTH AVE.
- (2,3,4) Height to Top of Sign _____ Feet Clearance to Grade _____ Feet

Existing Signage/Type:	
	Sq. Ft.
	Sq. Ft.
	Sq. Ft.
Total Existing:	<u>0</u> Sq. Ft.

● FOR OFFICE USE ONLY ●	
Signage Allowed on Parcel:	<u>300</u> Sq. Ft.
Building	<u>216</u> Sq. Ft.
Free-Standing	<u>300</u> Sq. Ft.
Total Allowed:	


COMMENTS: _____

NOTE: No sign may exceed 300 square feet. A separate sign permit is required for each sign. Attach a sketch of proposed and existing signage including types, dimensions, lettering, abutting streets, alleys, easements, property lines, and locations. Roof signs shall be manufactured such that no guy wires, braces or supports shall be visible.

 5-30-00
  4/13/00
 Applicant's Signature Date Community Development Approval Date

(White: Community Development) (Canary: Applicant) (Pink: Code Enforcement)

2 SETS 60¢ EA. (A) (B)

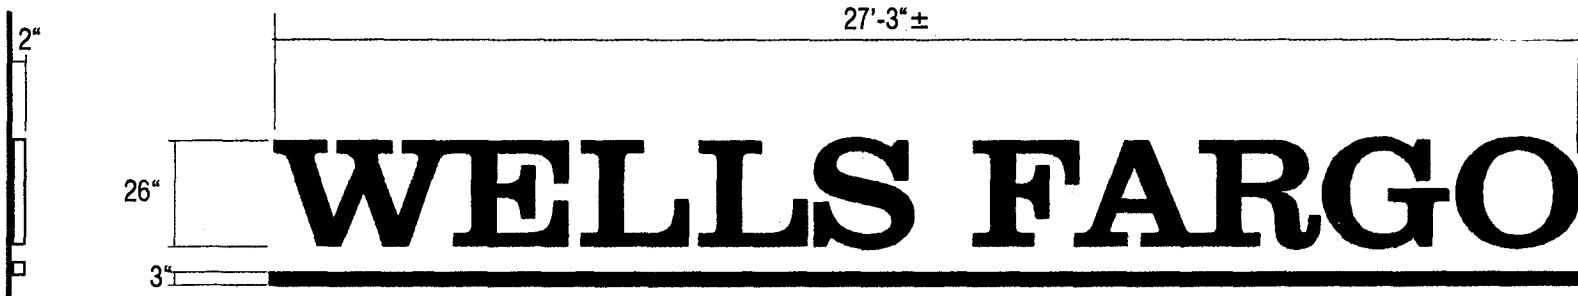


END VIEW

SINGLE FACED NON-ILLUMINATED DISPLAY

26" ALUMINUM REVERSE PAN CHANNEL LETTERS & UNDERLINE WITH
2" ALUMINUM RETURNS PAINTED DARK BRONZE #41-313 MATTHEWS POLYURETHANE.
STUD MOUNT FLUSH TO WALL.

NOTE: ONLY TWO (2) SETS REQUIRED. LOCATION TO FOLLOW.

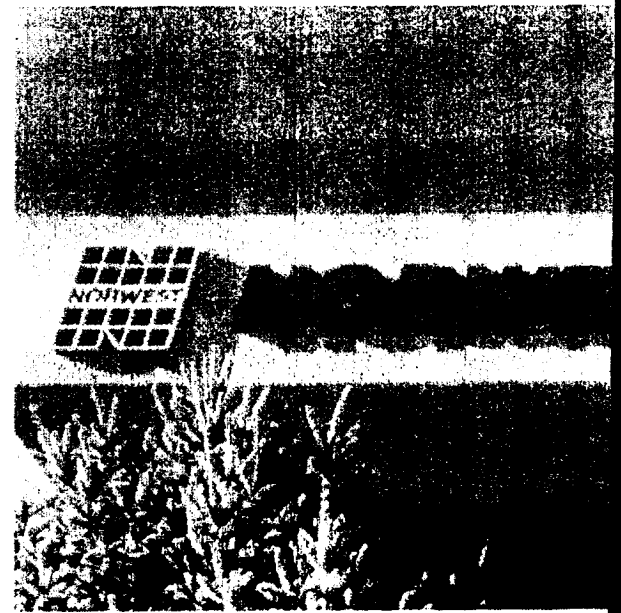

REMOVE TWO (2) "NORWEST" DISPLAYS AS PI



SIGN PERMIT

184 (C)

Community Development Department
250 North 5th Street
Grand Junction, CO 81501
(970) 244-1430

Permit No. _____
Date Submitted 5-30-00
FEE \$ 500
Tax Schedule 2943-073-00-214
Zone C-1

BUSINESS NAME WELLS FARGO
STREET ADDRESS 2808 N. AVE.
PROPERTY OWNER SAME
OWNER ADDRESS _____

CONTRACTOR Buo's SIGNS
LICENSE NO. 2200100
ADDRESS 1055 UTE
TELEPHONE NO. 245-7700

- 1. FLUSH WALL 2 Square Feet per Linear Foot of Building Facade
- Face Change Only (2,3 & 4):**
- 2. ROOF 2 Square Feet per Linear Foot of Building Facade
- 3. FREE-STANDING 2 Traffic Lanes - 0.75 Square Feet x Street Frontage
4 or more Traffic Lanes - 1.5 Square Feet x Street Frontage
- 4. PROJECTING 0.5 Square Feet per each Linear Foot of Building Facade

Existing Externally or Internally Illuminated - No Change in Electrical Service Non-Illuminated

(1 - 4) Area of Proposed Sign 17 Square Feet
(1,2,4) Building Facade 90 Linear Feet
(1 - 4) Street Frontage 200 Linear Feet > 28 RD.
(2,3,4) Height to Top of Sign _____ Feet Clearance to Grade _____ Feet

Existing Signage/Type:	
	Sq. Ft.
	Sq. Ft.
	Sq. Ft.
Total Existing:	<u>0</u> Sq. Ft.

● FOR OFFICE USE ONLY ●	
Signage Allowed on Parcel:	<u>180</u> Sq. Ft.
Building	<u>180</u> Sq. Ft.
Free-Standing	<u>150</u> Sq. Ft.
Total Allowed:	


COMMENTS: _____

NOTE: No sign may exceed 300 square feet. A separate sign permit is required for each sign. Attach a sketch of proposed and existing signage including types, dimensions, lettering, abutting streets, alleys, easements, property lines, and locations. Roof signs shall be manufactured such that no guy wires, braces or supports shall be visible.

[Signature] 5-30-00 [Signature] 4/13/00
Applicant's Signature Date Community Development Approval Date

(White: Community Development) (Canary: Applicant) (Pink: Code Enforcement)

1 SET

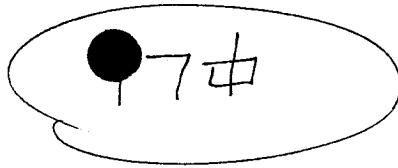

14'-7"±

1/4"

14"

1 3/4"


WELLS FARGO

END VIEW

SINGLE FACED NON-ILLUMINATED DISPLAY


~~SCALE: 1/2" = 1'-0"~~

14" X 1/4" THICK CUT OUT ALUMINUM LETTERS & UNDERLINE WITH
PAINTED DARK BRONZE #41-313 MATTHEWS POLYURETHANE.
STUD MOUNT FLUSH TO WALL.

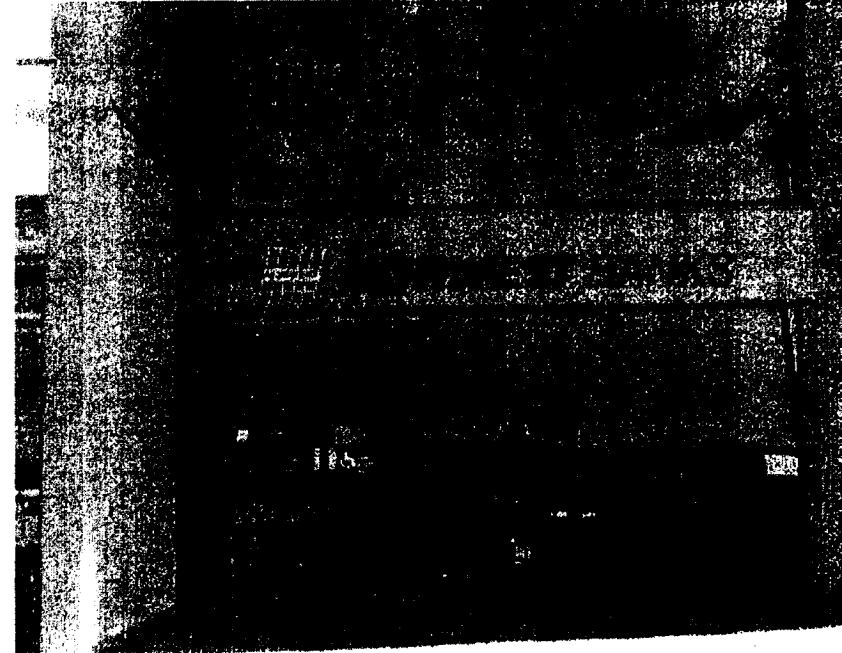

**REMOVE "NORWEST" DISPLAYS AS PICTURED ABOVE
INSTAL NEW "WELLS FARGO" DISPLAY IN ITS PLACE**

6'-6" STRUCTURE

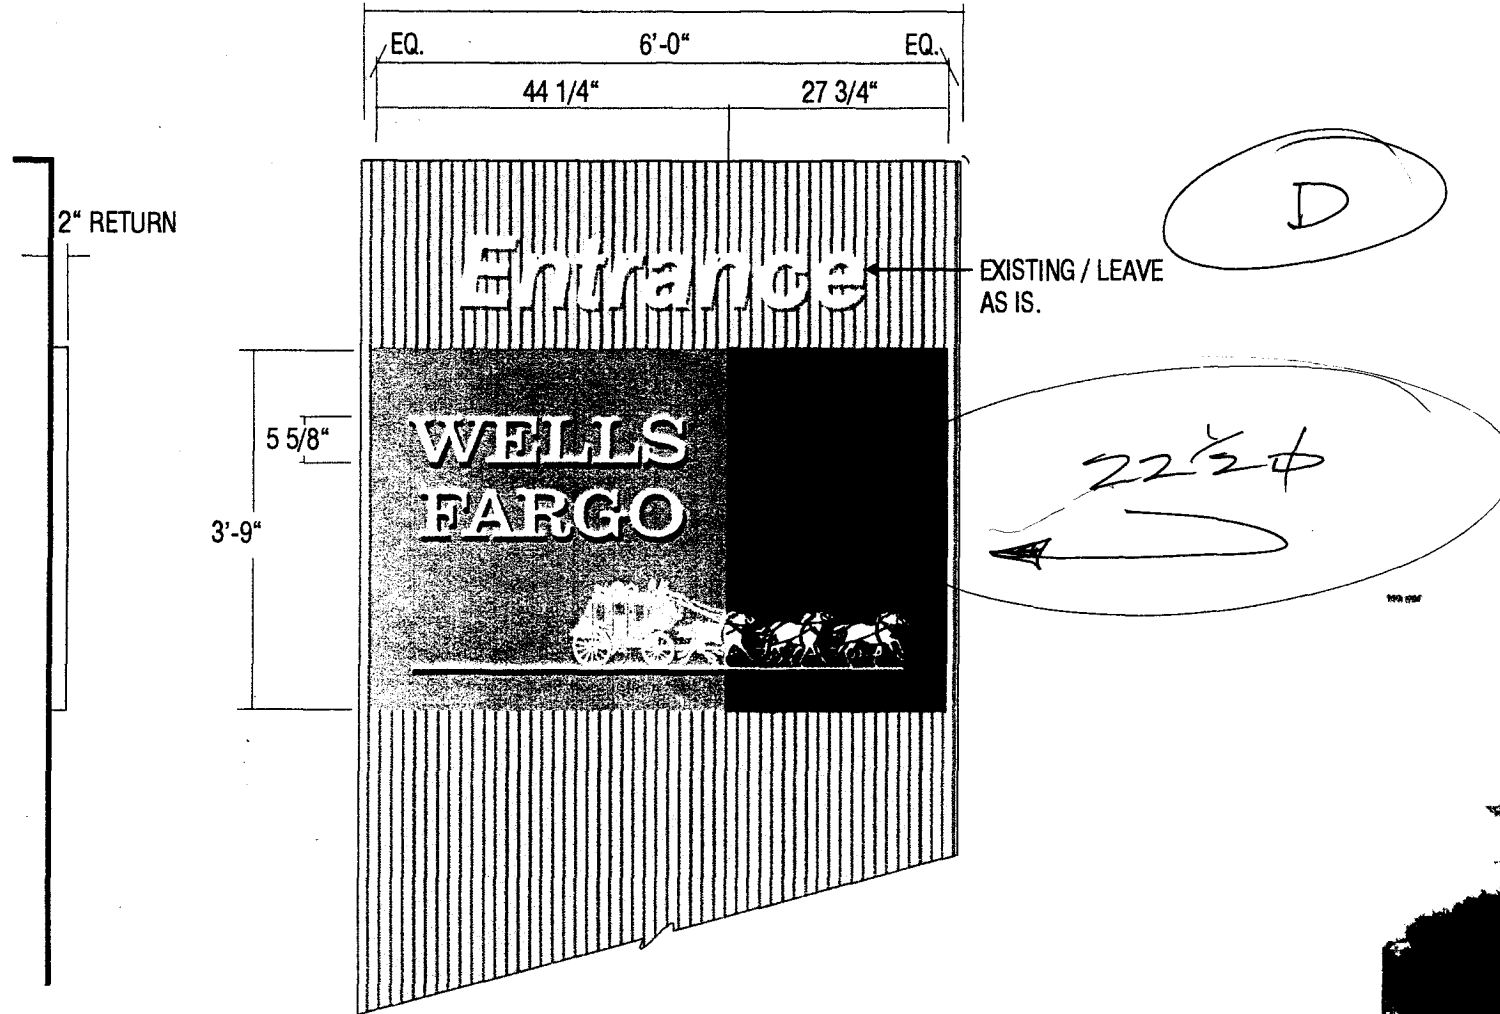

NEW (NON ILLUMINATED) PANELS FOR EXISTING "V" TYPE DISPLAY


SCALE: 1/2" = 1'-0"

(2 NEW PANELS REQUIRED)

REMOVE EXISTING "NORWEST" LETTERS & LOGOS.. FABRICATE & INSTALL NEW ALUMINUM REVERSE PAN WITH 1/8" ALUMINUM FACE OVER A 2" X 2" ALUMINUM ANGLE FRAME. PAINT THE LEFT 44 1/4" SECTION (OF BACKGROUND / RETURNS) TO MATCH #VQ 7701 RED. PAINT THE RIGHT 27 3/4" SECTION (OF BACKGROUND / RETURNS) BLACK MATCH #VQ 3580.


"WELLS FARGO" COPY & UNDERLINE #VQ 8900 YELLOW VINYL WITH A BLACK VINYL DROP SHADOW. "STAGECOACH" GRAPHIC WHITE (OPAQUE) VINYL. MOUNT TO EXISTING CONCRETE STRUCTURE WITH CONCEALED ANGLE CLIPS.

NOTE: LEAVE THE WORD "ENTRANCE" AS IS.

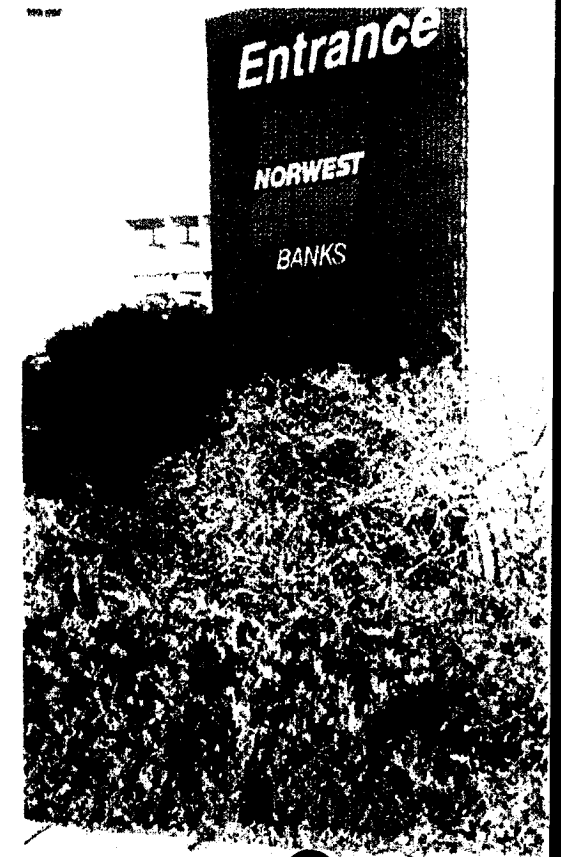

EXISTING DISPLAY

← 28 ROAD →

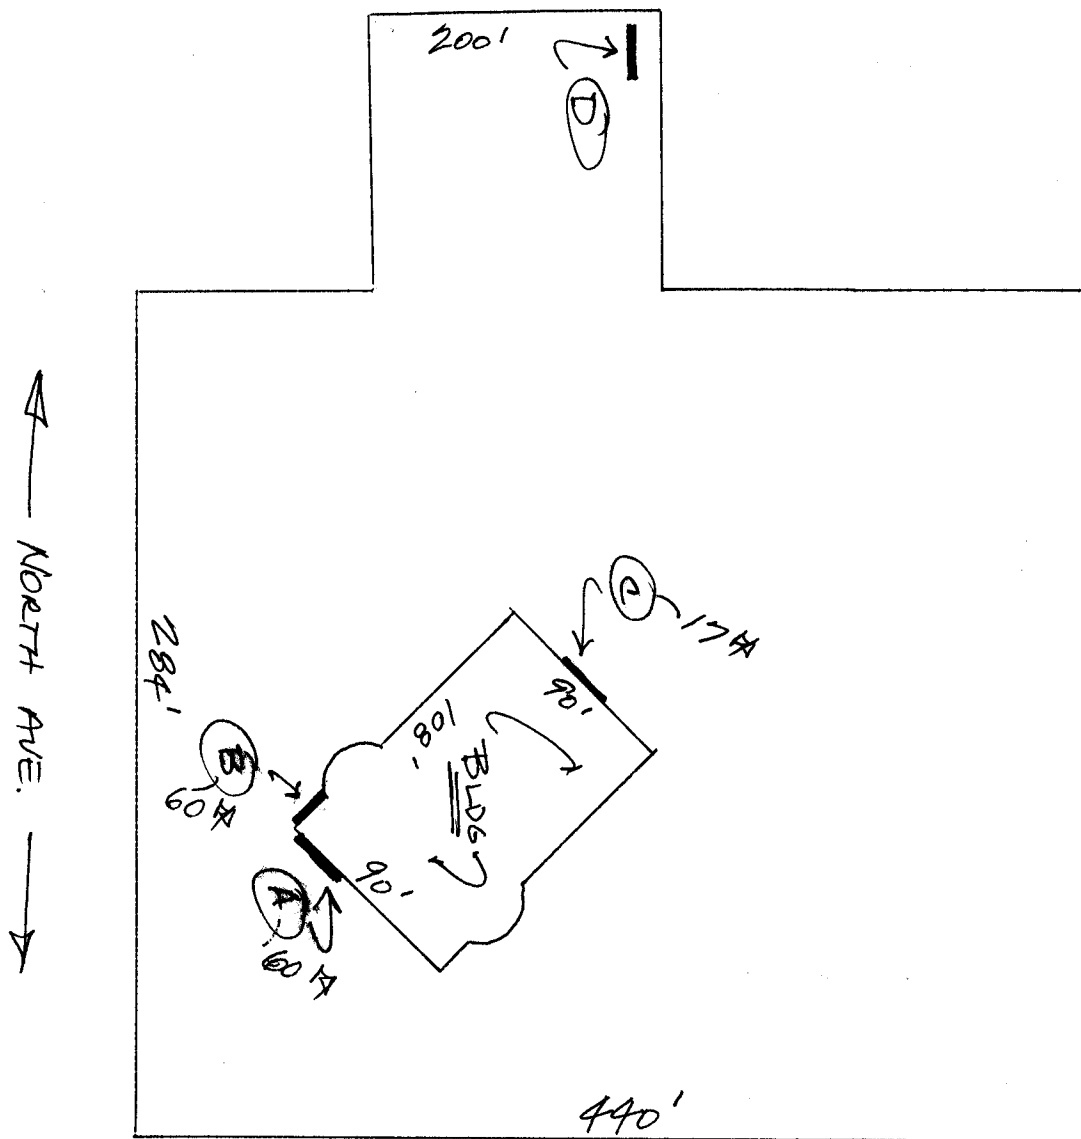

← COURT RD →