



Sign Permit

Community Development Department
250 North 5th Street
Grand Junction CO 81501
Phone: (970) 244-1430 FAX (970) 256-4031

(E)

Permit No.	<u>N/A</u>
Date Submitted	_____
Fee \$	<u>500</u>
Zone	<u>C-2</u>

TAX SCHEDULE	<u>2945-103-32-042</u>	CONTRACTOR	<u>Signs First</u>
BUSINESS NAME	<u>SAM'S CLUB</u>	LICENSE NO.	<u>2010281</u>
STREET ADDRESS	<u>1040 INDEPENDENT AVE</u>	ADDRESS	<u>950 NORTH AVE</u>
PROPERTY OWNER	<u>SAM'S CLUB</u>	TELEPHONE NO.	<u>256-1877</u>
OWNER ADDRESS	<u>1040 INDEPENDENT AVE.</u>	CONTACT PERSON	<u>BRIAN TAP</u>

<input checked="" type="checkbox"/> 1. FLUSH WALL	2 Square Feet per Linear Foot of Building Façade
<u>Face change only on items 2, 3 & 4</u>	
<input type="checkbox"/> 2. ROOF	2 Square Feet per Linear Foot of Building Façade
<input type="checkbox"/> 3. FREE-STANDING	2 Traffic Lanes - 0.75 Square Feet x Street Frontage 4 or more Traffic Lanes - 1.5 Square Feet x Street Frontage
<input type="checkbox"/> 4. PROJECTING	0.5 Square Feet per each Linear Foot of Building Façade

Existing Externally or Internally Illuminated - No Change in Electrical Service Non-Illuminated

(1 - 4) Area of Proposed Sign: 42 1/4 Square Feet
 (1,2,4) Building Façade: 390 Linear Feet - INDEPENDENT
 (1 - 4) Street Frontage: 340 Linear Feet - INDEPENDENT
 (2 - 4) Height to Top of Sign: 18'6" Feet Clearance to Grade: 12' Feet

EXISTING SIGNAGE/TYPE:

F/S - (A)	<u>99</u> Sq. Ft.
F/W - (B)	<u>210</u> Sq. Ft.
F/W - (C)	<u>172</u> Sq. Ft.
F/W - (D)	<u>552</u> Sq. Ft.
Total Existing: <u>536.2</u> Sq. Ft.	

FOR OFFICE USE ONLY

Signage Allowed on Parcel:

Building	<u>780</u> Sq. Ft.
Free-Standing	<u>255</u> Sq. Ft.
Total Allowed:	<u>780</u> Sq. Ft.


COMMENTS: ALL EXISTING SIGNAGE REMOVED

NOTE: No sign may exceed 300 square feet. A separate sign permit is required for each sign. Attach a sketch, to scale, of proposed and existing signage including types, dimensions and lettering. Attach a plot plan, to scale, showing: abutting streets, alleys, easements, driveways, encroachments, property lines, distances from existing buildings to proposed signs and required setbacks. Roof signs shall be manufactured such that no guy wires, braces or supports shall be visible.

I hereby attest that the information on this form and the attached sketches are true and accurate.

	<u>10/30/01</u>		<u>10.31.01</u>
Applicant's Signature	Date	Community Development Approval	Date

(White: Community Development) (Canary: Applicant) (Pink: Code Enforcement)

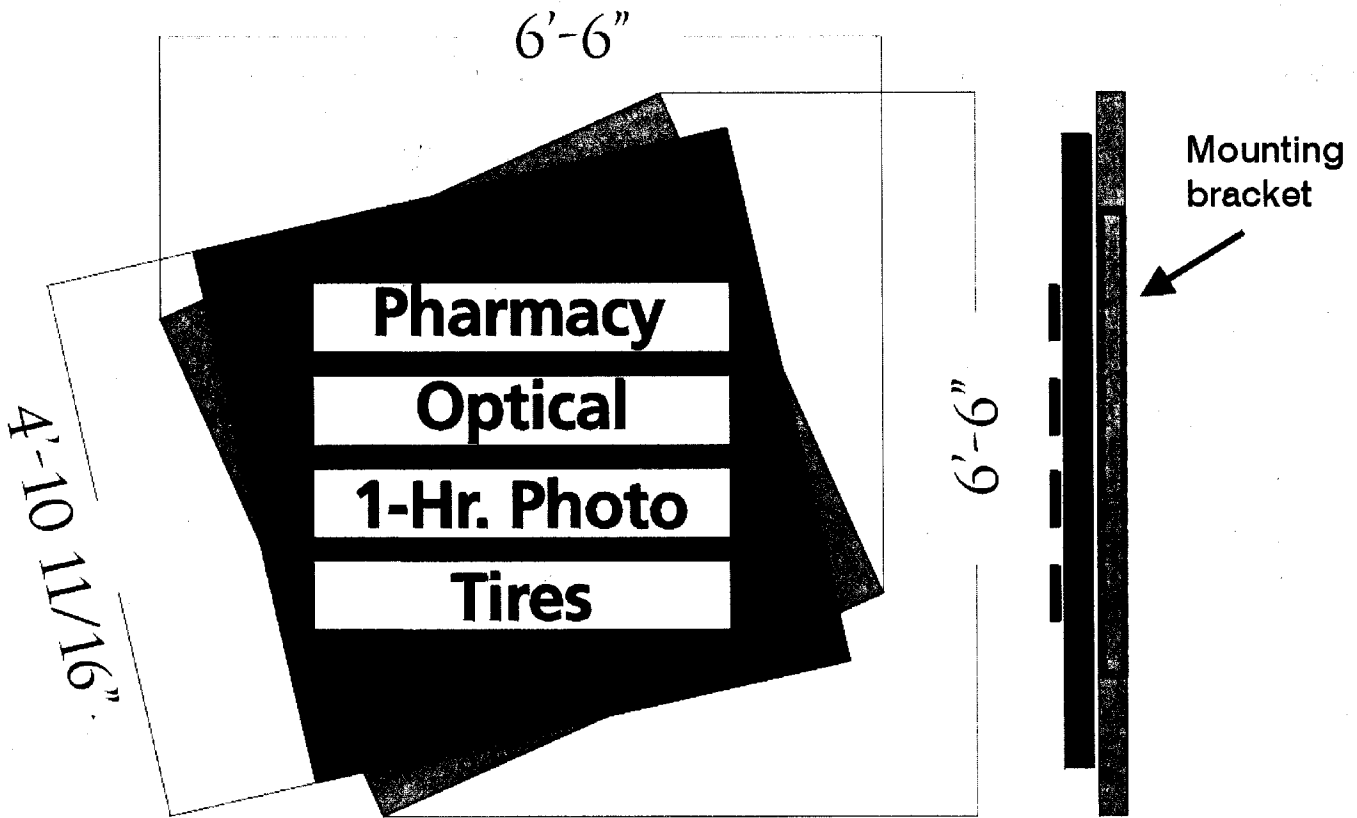

Sign Type: wall ancillary sign

Mounting: hidden bracket mounted at designated side locations with recessed screws.

Structure: .080 aluminum panels versilock to a 2x2x1/8" tubular frames made in (2) separate sections and then assembled prior to shipping.

Graphics: back triangle and returns painted to match green PMS 583 front triangle and returns painted to match blue PMS 286 rectangles on front painted white, with black (gemini 3/4" thick 5" height, molded ltrs.) Stud Mounted.

Part number:

6'-6" sf wall treat 4 line vc # STS-304-00006

NAME: SAM'S CLUB	LOCATION: _____
DWG.# STS-304-00006G	SALES ORDER # _____ CUSTOMER APPROVAL: _____
DATE: 08/15/01	CUSTOMER CHANGES: _____

NOTE: FOR ILLUSTRATION USE ONLY


REVISIONS: 1- 2- 3- 4- 5



This Product is Listed by
UNDERWRITERS LABORATORIES INC.
And Bears the Mark:



08 15 01 P.O. Box 278, Shpps Bend Industrial Park, Centerville, Tennessee 37033 (931) 729-9212

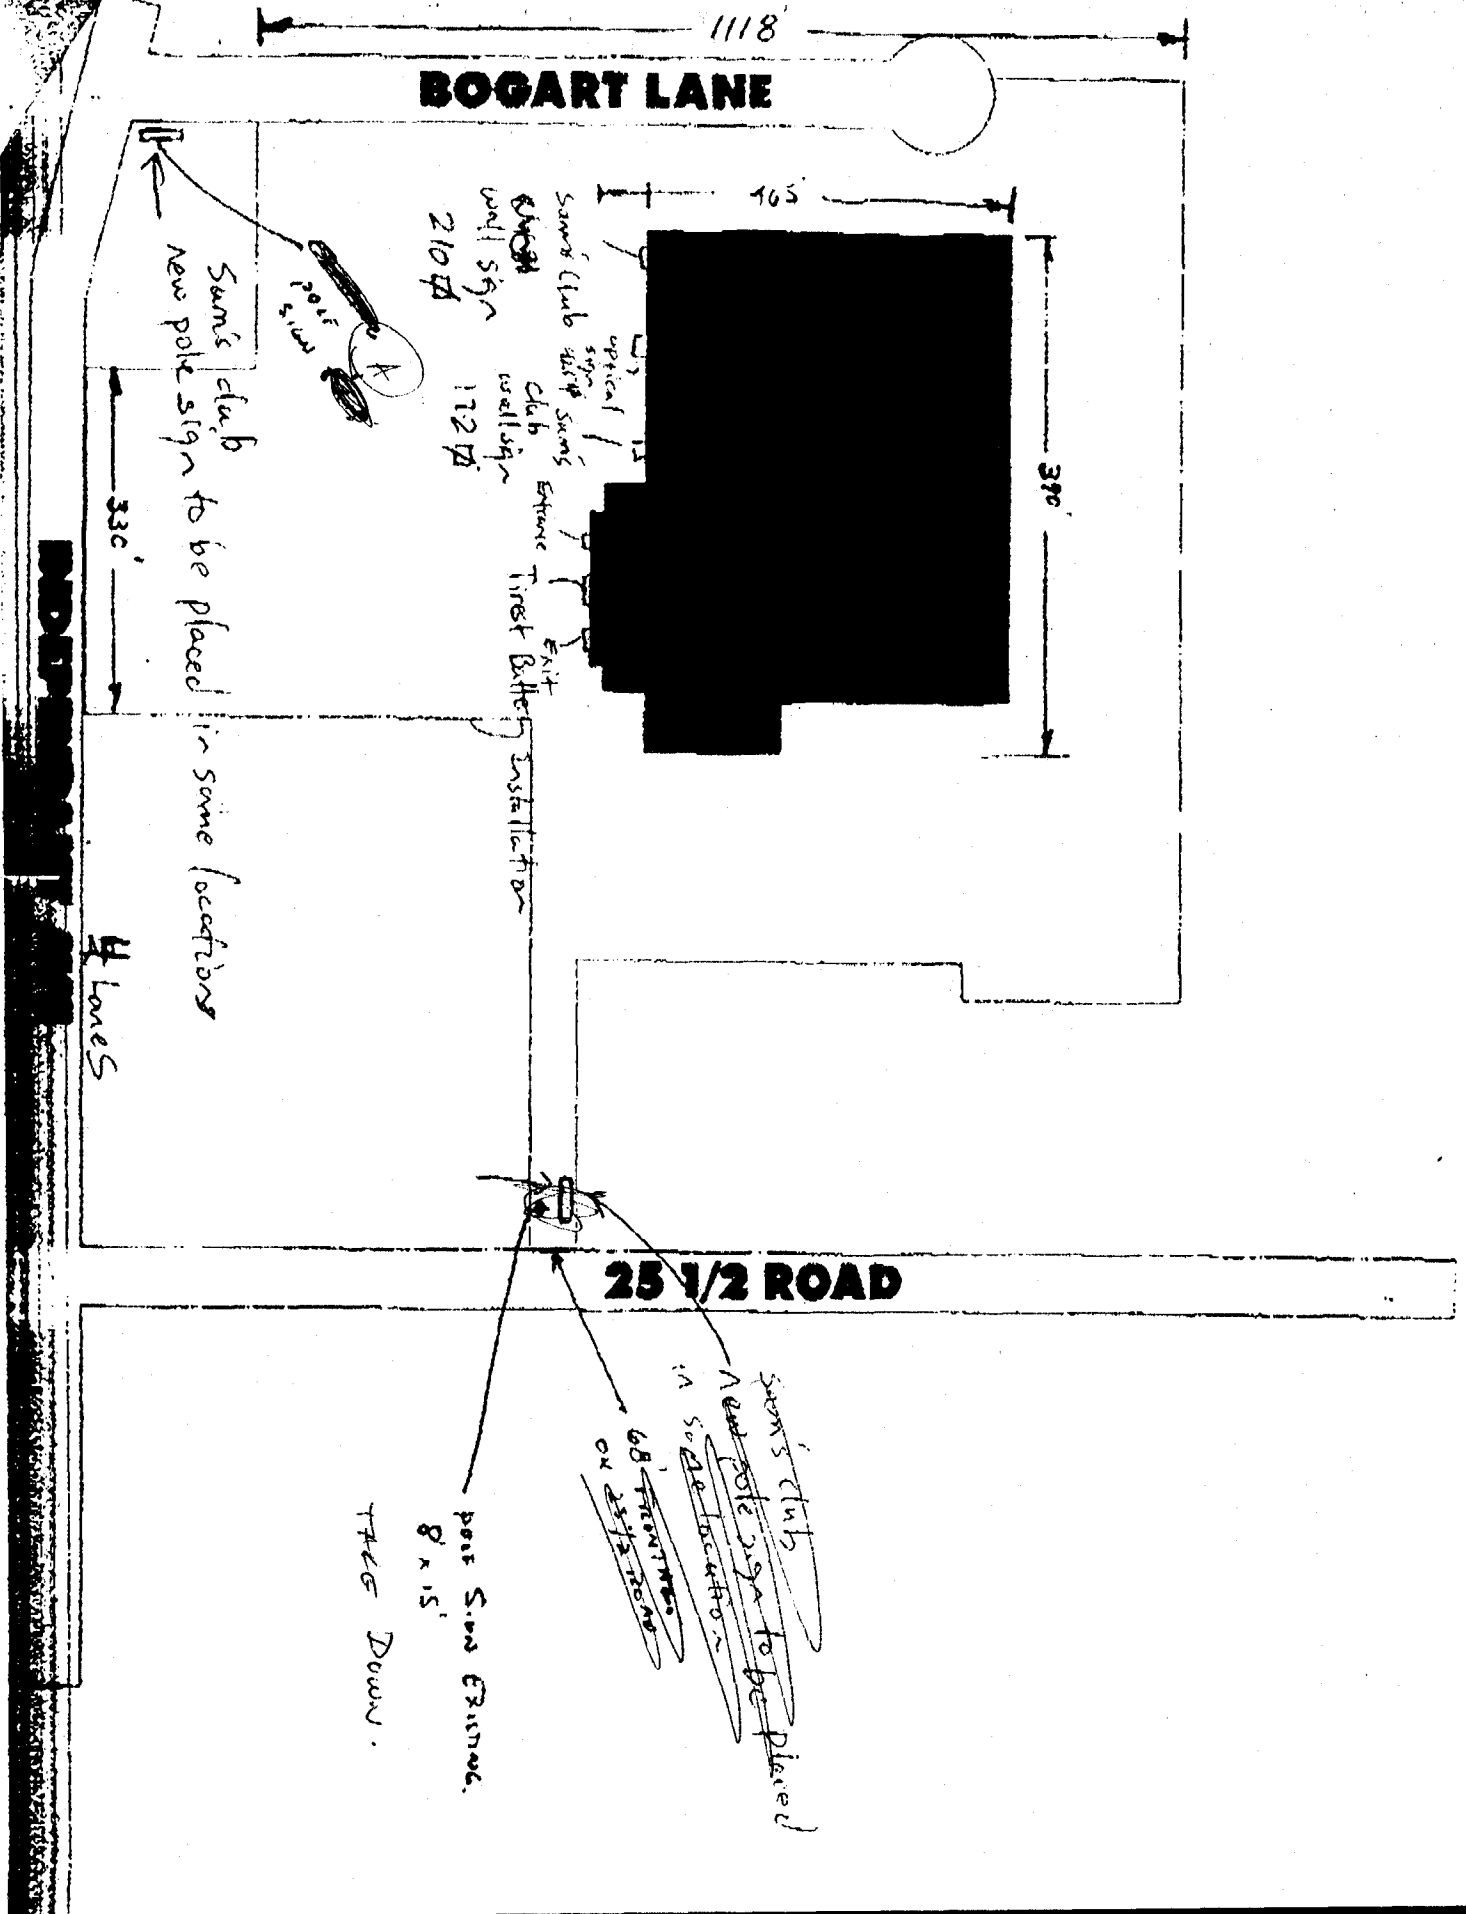

SAM'S CLUB
1040 INDEPENDENT
BUILDING FRONT
ELEVATION.

