



# SIGN CLEARANCE

Community Development Department  
250 North 5<sup>th</sup> Street  
Grand Junction CO 81501  
(970) 244-1430

Clearance No.	<u>785004</u>
Date Submitted	<u>2-1-01</u>
Fee \$	<u>25.00</u>
Zone	<u>C-1</u>

A

TAX SCHEDULE	<u>2945-124-10-033</u>	CONTRACTOR	<u>Platinum Sign Co</u>
BUSINESS NAME	<u>Castle Creek Plaza</u>	LICENSE NO.	<u>2200 696</u>
STREET ADDRESS	<u>2500 North Ave.</u>	ADDRESS	<u>2916 Hwy 6 + 29 (T-70 B)</u>
PROPERTY OWNER	<u>Bob Lovelass</u>	TELEPHONE NO.	<u>288 9677</u>
OWNER ADDRESS		CONTACT PERSON	<u>Deon</u>

- |                                     |                  |   |
|-------------------------------------|------------------|---|
| <input type="checkbox"/>            | 1. FLUSH WALL    | 2 Square Feet per Linear Foot of Building Facade  |
| <input type="checkbox"/>            | 2. ROOF          | 2 Square Feet per Linear Foot of Building Facade  |
| <input checked="" type="checkbox"/> | 3. FREE-STANDING | 2 Traffic Lanes - 0.75 Square Feet x Street Frontage<br>4 or more Traffic Lanes - 1.5 Square Feet x Street Frontage |
| <input type="checkbox"/>            | 4. PROJECTING    | 0.5 Square Feet per each Linear Foot of Building Facade   |
| <input type="checkbox"/>            | 5. OFF-PREMISE   | See #3 Spacing Requirements; Not > 300 Square Feet or < 15 Square Feet  |

Externally Illuminated       Internally Illuminated       Non-Illuminated

(1 - 5) Area of Proposed Sign: ~~665~~ <sup>704</sup> Square Feet

(1,2,4) Building Façade: ~~452~~ Linear Feet <sup>? 88'</sup>

(1 - 4) Street Frontage: ~~77~~ Linear Feet <sup>? 106'</sup>

(2 - 5) Height to Top of Sign: 18 Feet      Clearance to Grade: 8.0 Feet

(5) Distance from all Existing Off-Premise Signs within 600 Feet: \_\_\_\_\_ Feet

*North Ave*

**EXISTING SIGNAGE/TYPE:**

_____	_____	Sq. Ft.
_____	_____	Sq. Ft.
_____	_____	Sq. Ft.
Total Existing: <u>None</u>		Sq. Ft.

**● FOR OFFICE USE ONLY ●**

Signage Allowed on Parcel:

Building	<u>176</u>	Sq. Ft.
Free-Standing	<u>159</u>	Sq. Ft.
Total Allowed:	<u>176</u>	Sq. Ft.

COMMENTS: Going with Existing Poles

**NOTE:** No sign may exceed 300 square feet. A separate sign clearance is required for each sign. Attach a sketch, to scale, of proposed and existing signage including types, dimensions and lettering. Attach a plot plan, to scale, showing: abutting streets, alleys, easements, driveways, encroachments, property lines, distances from existing buildings to proposed signs and required setbacks. **A SEPARATE PERMIT FROM THE BUILDING DEPARTMENT IS ALSO REQUIRED.**

I hereby attest that the information on this form and the attached sketches are true and accurate.


*[Signature]*  
 Applicant's Signature      Date 2/2/01

*[Signature]*  
 Community Development Approval      Date 2/1/01

(White: Community Development)      (Canary: Applicant)      (Pink: Building Dept)      (Gold: Code Enforcement)

*[Signature]*  
 2/13/01 (revised)

15' To back of curb  
to sign

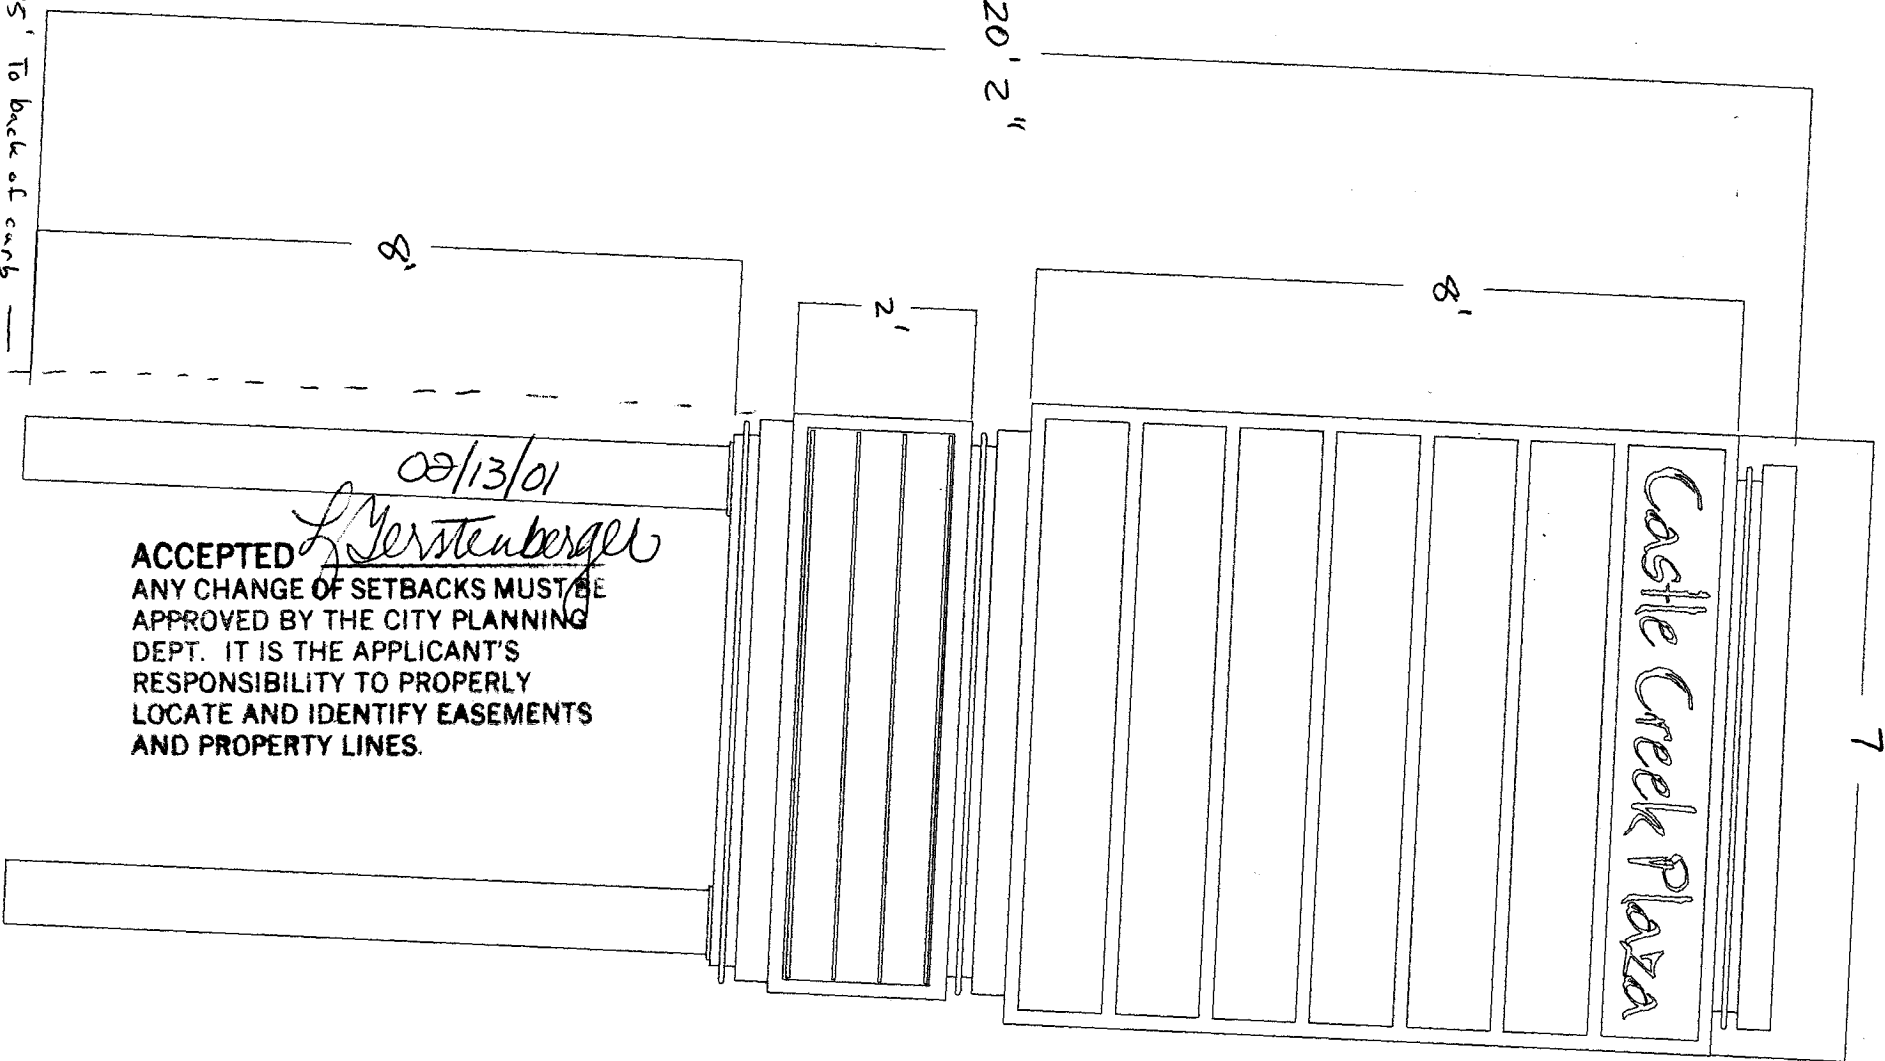

02/13/01


*L. Yervstenbergel*

**ACCEPTED**  
ANY CHANGE OF SETBACKS MUST BE  
APPROVED BY THE CITY PLANNING  
DEPT. IT IS THE APPLICANT'S  
RESPONSIBILITY TO PROPERLY  
LOCATE AND IDENTIFY EASEMENTS  
AND PROPERTY LINES.

Castle Creek Plaza

10x7=70#

North Ave.

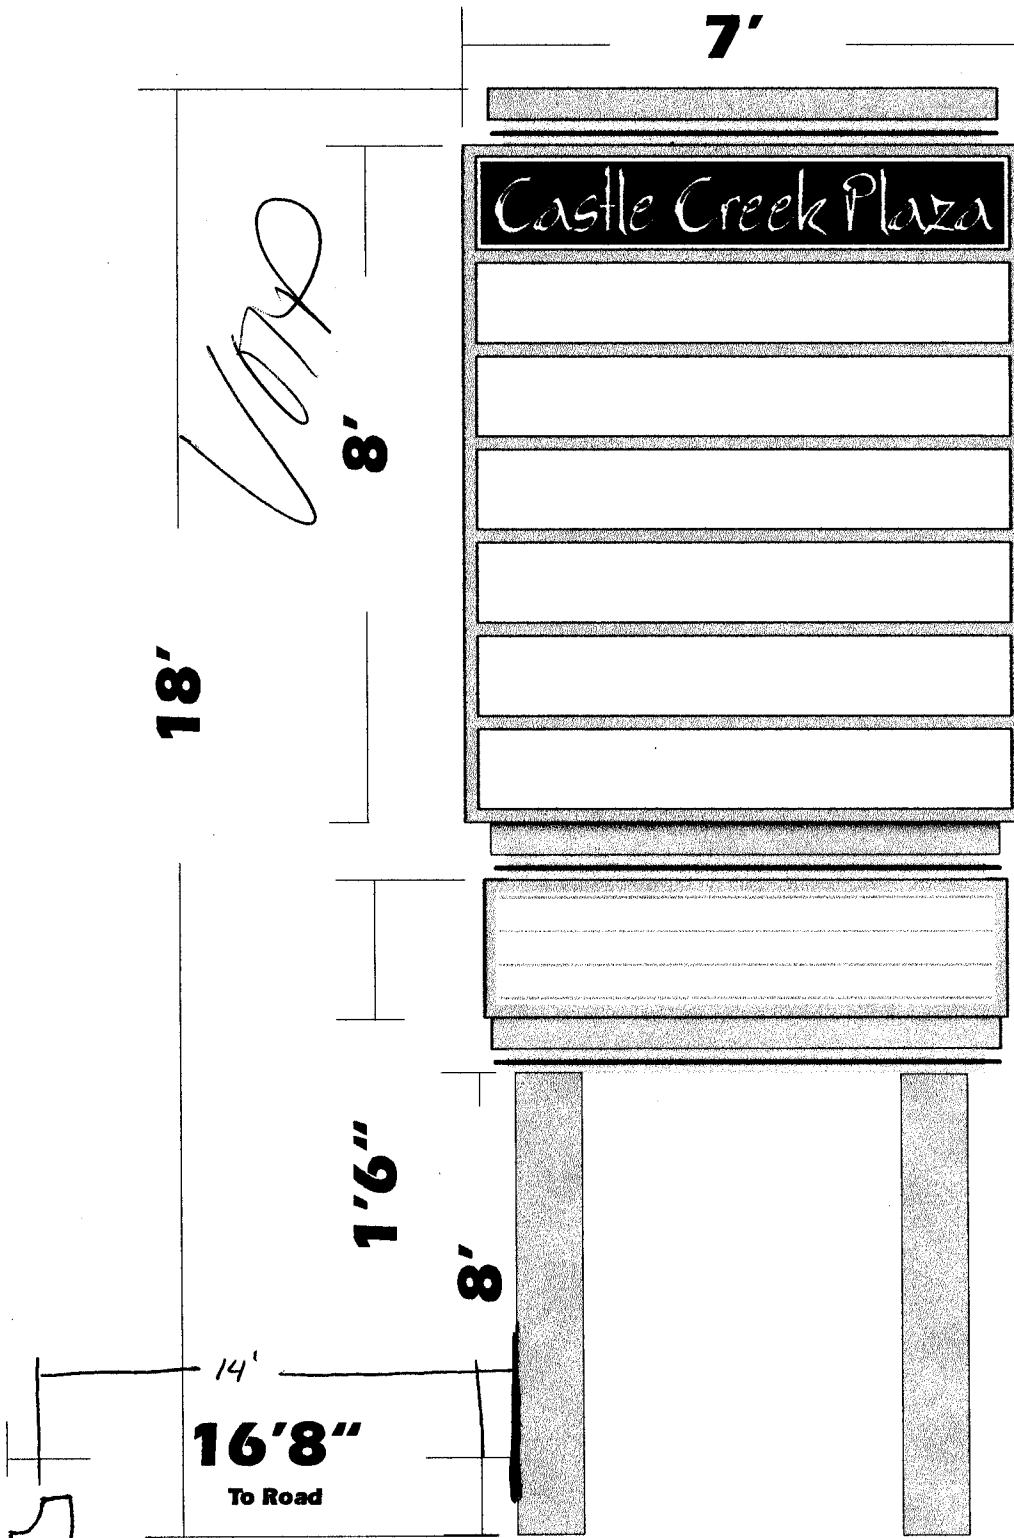

**Platinum Sign Co.**  
Lighted Sign Professionals  
"A FAMILY TRADE SINCE 1915"

2916 I-70B  
Grand Junction,  
CO 81504  
Tel: 970-248-9677  
Fax: 970-248-5444  
www.platinumsign.com

This design is the exclusive property of platinum sign co. All rights reserved. No copy or reproduction in whole or part may be done without the expressed written approval of platinum sign co.

Date: \_\_\_\_\_  
Computer File: \_\_\_\_\_  
 Approved

Client Approval \_\_\_\_\_  
Project Location: \_\_\_\_\_

\_\_\_\_\_  
\_\_\_\_\_  
Note: \_\_\_\_\_  
\_\_\_\_\_  
\_\_\_\_\_  
\_\_\_\_\_  
\_\_\_\_\_



NORTH AVE. 110'

to street

24'

16' 8"

10'

OUT

12'

2500 NORTH



Platinum Sign Co.  
Lighted Sign Professionals  
"A FAMILY TRADE SINCE 1915"

2916 I-70B  
Grand Junction,  
CO 81504  
Tel: 970-248-9677  
Fax: 970-248-6444  
www.platinumsign.com

This design is the  
exclusive property  
of platinum sign co.  
All rights reserved.  
No copy or reproduction  
in whole or part may  
be done without the  
expressed written approval  
of platinum sign co.

25TH STREET 165'

Date: \_\_\_\_\_  
Computer File: \_\_\_\_\_  
 Approved

Client Approval \_\_\_\_\_  
Project Location: \_\_\_\_\_

Notes: \_\_\_\_\_  
\_\_\_\_\_  
\_\_\_\_\_  
\_\_\_\_\_






file://C:\TEMP\bob & jan's 1.jpg

2/1/01



# City of Grand Junction GIS Map

- Parcels
- ▣ Air Photos
- Highways
- Streets 2

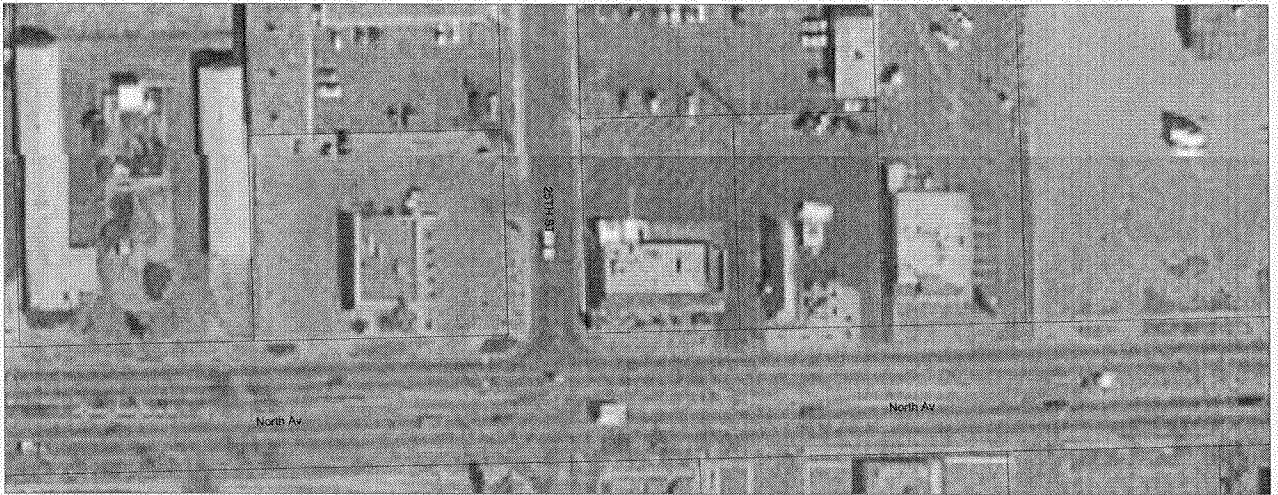


SCALE 1 : 1,600



# City of Grand Junction GIS Map

- Parcels
- ▣ Air Photos
- Highways
- Streets 2

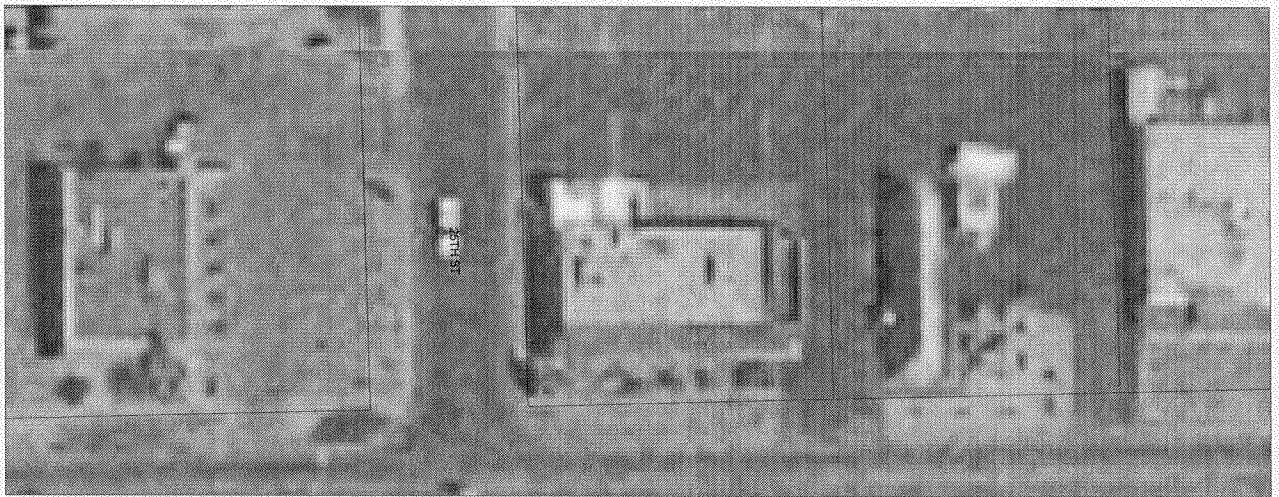

SCALE 1 : 800

