	:				,				
S CR AND VIE	0 0								
	SIGN CLEAR	ANCE		an a					
COLORADO			Clearance	No. None					
	Community Development D	epartment		mitted 3/18/03	· · · · · · · · · · · · · · · · · · ·				
	250 North 5th Street			FEE\$ <u>25.00</u>					
	Grand Junction, CO 81501		Tax Schedule 2945 054 09 003						
	(970) 244-1430		Zone <u>C</u>	-2					
· · · ·	- 15 18:811 - hakalar								
BUSINESS NA		- A		ACTOR CWOA, Inc.	»				
STREET ADD		LICENSE NO. 2030186 ADDRESS P.O. Box 2906 Grand Jct., CO 81502							
PROPERTY OV OWNER ADDI		en, CO 810		$\frac{255 \text{ P.0. } 858 2906 \text{ G}}{100000000000000000000000000000000000$		<u>0 8150</u> 2			
				none no. <u>910 212 9</u>					
[] 1. FLU [] 2. ROC				Building Facade					
	1	-		Building Facade t x Street Frontage					
			-	are Feet x Street Frontage					
	-			t > 300 Square Feet or <	15 Square Feet				
	rnally Illuminated		ally Illumina	-	[] Non-Illumin				
(1,2,4) Build	of Proposed Sign <u>300</u> Squ ling Facade <u>Linear Fee</u> et Frontage <u>Linear Fee</u>								
	· · · · · · · · · · · · · · · · · · ·	Clearance to		Feet					
	ance from all Existing Off-Premise	Signs within 60	00 Feet	00+ Feet					
Existing Signa	age/Type:	·		● FOR OFFIC	E USE ONLY				
			Sq. Ft.	Signage Allowed on Pa	ircel:	····			
			Sq. Ft.	Building		Sq. Ft.			
			Sq. Ft.	Free-Standing	300	Sq. Ft.			
Tota	l Existing:		Sq. Ft.	Total Allowed:	300	Sq. Ft.			
comments Blad	NO "V" of su	ipi al	lowed), must	be				
proposed and	sign may exceed 300 square fee existing signage including types <u>A SEPARATE PERMIT FR</u>	, dimensions,	lettering, a	butting streets, alleys, ea	sements, proper	sketch of rty lines,			
HATEn		<u>3/18/03</u>	1 du	p. Sibon) 3h	03			
·· /	ignature Da nunity Development) (Canary:	te (<i>Applicant</i>)	•	7 D evelopment Approva Building Dept) (Golde	I Date nrod: Code Enfo	orcement)			

.

-

.

Sent	By:	Bra	y Commercial; 09/14/1995_05:25 978	970 2	2412309; JEEL SAK	Feb-12-03	10:23; PAGE 01	Paga 2/2
			бант Ву: Шпау Сожнологал); 82/11/2003 89/16 — 9/020		24729693 Feb 1 Gwon Outwoor Adve	२-C3 ∆:38; २न्ट्र	PAGE 2/2 FAGE U-	
		ţ		C. C. V.	VOA.)			
					56 NG P ¹ 62		an say is a	

• !

- LANDOWNEN CONSENT FORM


.

.

Signed this. 13th day of Tebrusiy Property Thomas: All Just , 19(2001 2/11/03 Û

44

Page 2/2

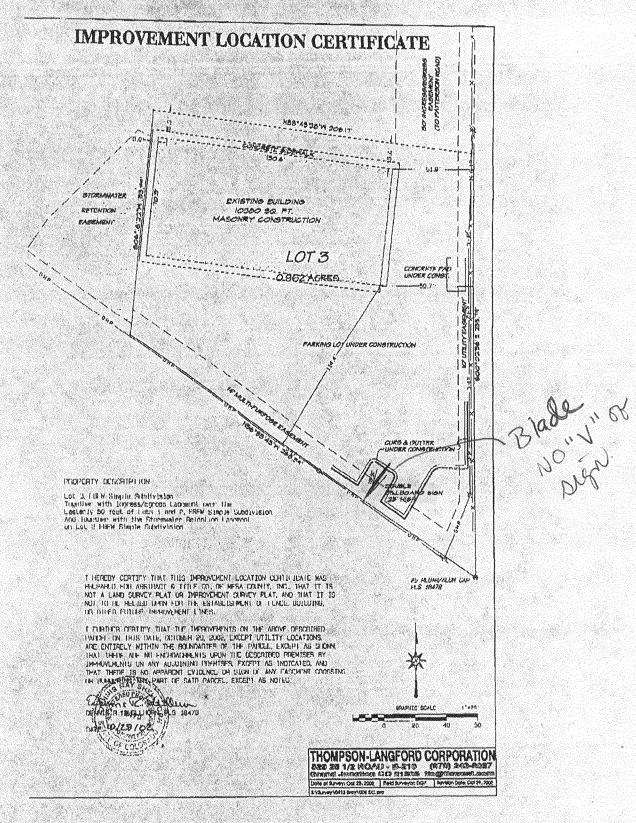

2387 F Rel. Gland Junchin Co

