



SIGN CLEARANCE

Community Development Department
250 North 5th Street
Grand Junction CO 81501
(970) 244-1430

Clearance No.	_____
Date Submitted	5/19/04
Fee \$	25.00
Zone	C-1

①

TAX SCHEDULE	2701-364-28-008	CONTRACTOR	CWOA, Inc.
BUSINESS NAME	Adam's Mark	LICENSE NO.	2040269
STREET ADDRESS	743 Horizon Drive	ADDRESS	P.O. Box 2906
PROPERTY OWNER	Morgan Stanley	TELEPHONE NO.	970-242-5248
OWNER ADDRESS	1585 Broadway 37th Floor New York, NY 10036	CONTACT PERSON	Mark Gamble

- 1. FLUSH WALL 2 Square Feet per Linear Foot of Building Facade
- 2. ROOF 2 Square Feet per Linear Foot of Building Facade
- 3. FREE-STANDING 2 Traffic Lanes - 0.75 Square Feet x Street Frontage
4 or more Traffic Lanes - 1.5 Square Feet x Street Frontage
- 4. PROJECTING 0.5 Square Feet per each Linear Foot of Building Facade
- 5. OFF-PREMISE See #3 Spacing Requirements; Not > 300 Square Feet or < 15 Square Feet

Externally Illuminated Internally Illuminated Non-Illuminated

(1 - 5) Area of Proposed Sign: 300 Square Feet
 (1,2,4) Building Façade: ~~N/A~~ Linear Feet 275
 (1 - 4) Street Frontage: 1220 Linear Feet
 (2 - 5) Height to Top of Sign: 40 Feet Clearance to Grade: 28 Feet
 (5) Distance from all Existing Off-Premise Signs within 600 Feet: N/A Feet

EXISTING SIGNAGE/TYPE:

Free Standing (Horizon Dr.)	<u>201</u>	Sq. Ft.
Flush wall (Horizon Dr.)	<u>286</u>	Sq. Ft.
Flush wall (I-70 Frontage)	<u>286</u>	Sq. Ft.
Total Existing:	<u>773</u>	Sq. Ft.

● FOR OFFICE USE ONLY ●

Signage Allowed on Parcel:	<u>I-70 Bus Loop</u>	
Building	<u>550</u>	Sq. Ft.
Free-Standing	<u>1830</u>	Sq. Ft.
Total Allowed:	<u>550</u>	<u>1830</u> Sq. Ft.

COMMENTS: This is an existing sign. We are raising it 16 feet.
Sign face can not change without a new permit

NOTE: No sign may exceed 300 square feet. A separate sign clearance is required for each sign. Attach a sketch, to scale, of proposed and existing signage including types, dimensions and lettering. Attach a plot plan, to scale, showing: abutting streets, alleys, easements, driveways, encroachments, property lines, distances from existing buildings to proposed signs and required setbacks. **A SEPARATE PERMIT FROM THE BUILDING DEPARTMENT IS ALSO REQUIRED.**

I hereby attest that the information on this form and the attached sketches are true and accurate.


_____	5/19/04	<u>Misha Magan</u>	5/21/04
Applicant's Signature	Date	Community Development Approval	Date

(White: Community Development) (Canary: Applicant) (Pink: Building Dept) (Goldenrod: Code Enforcement)

FIL. NO. THREE REPLAT (RECPTN. NO. 1587047)

LOT A-017 LOT B-018 LOT C-019

AN IND. 1/3 INT. TO EACH TOWNHOME IN ASPEN HEIGHTS IN LOT C. FIL. NO. 4 & LOT B THREE REPLAT B OPEN SPACE FIL. 5

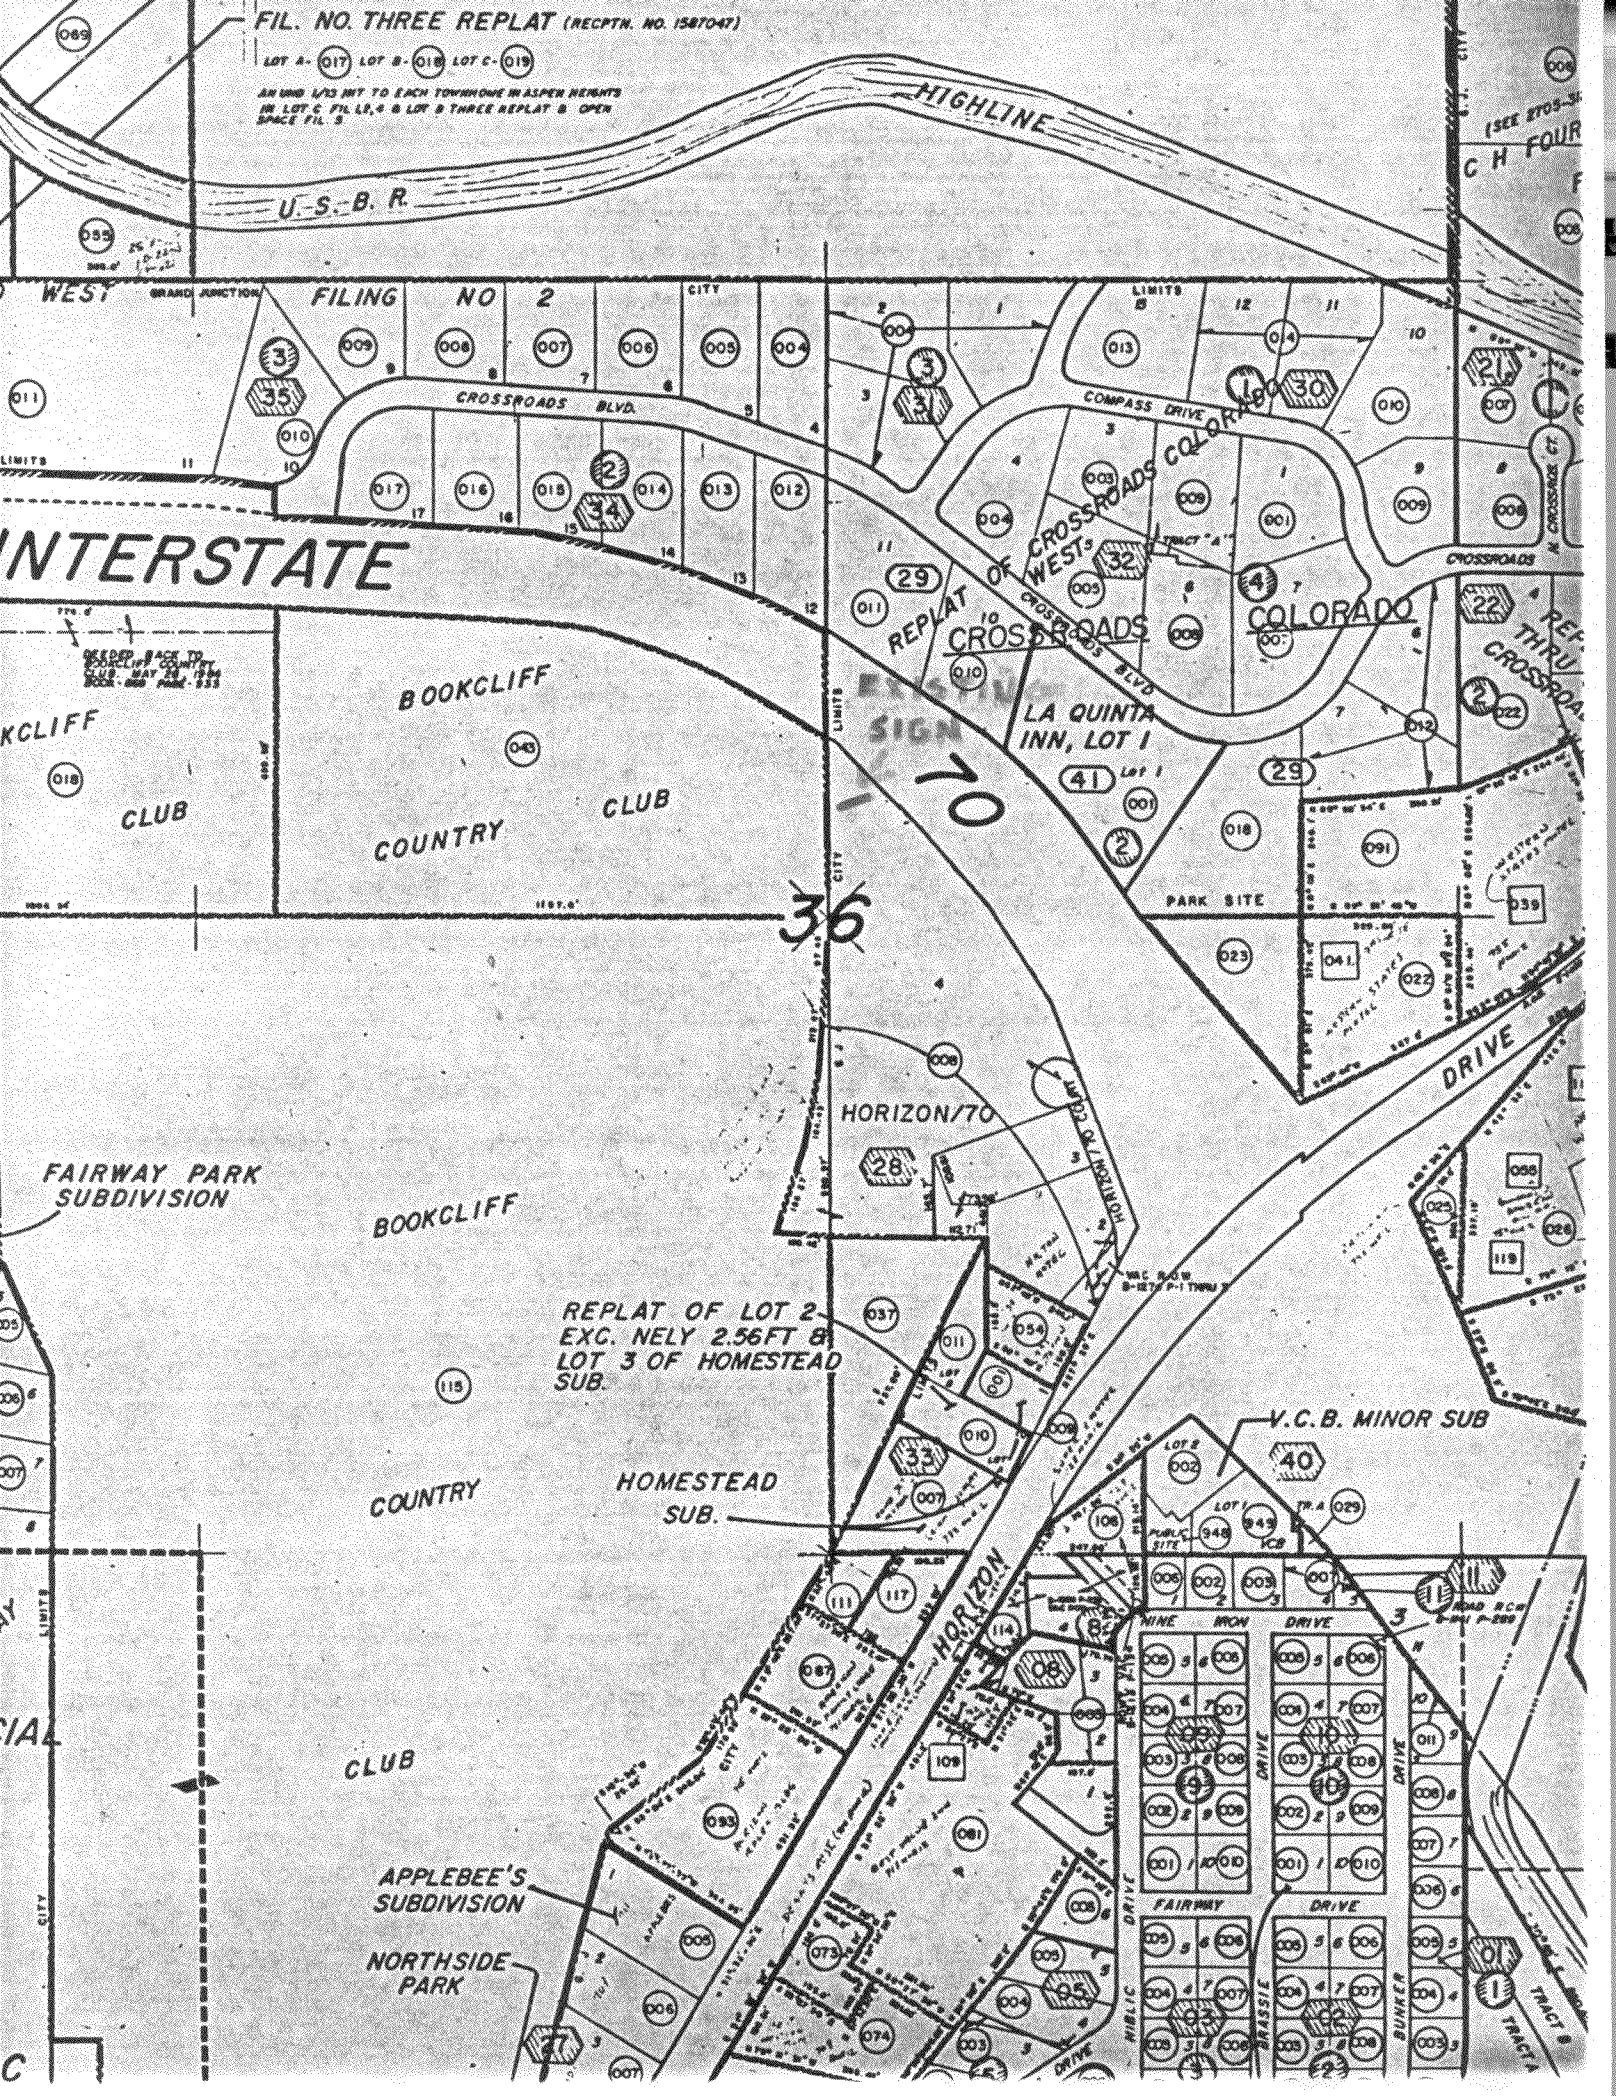

U.S. B. R.

HIGHLINE

WEST GRAND JUNCTION

FILING NO 2

CITY

LIMITS

12

11

CROSSROADS BLVD.

COMPASS DRIVE

INTERSTATE

BOOKCLIFF CLUB

COUNTRY CLUB

REPLAT OF WEST CROSSROADS COLORADO

LA QUINTA INN, LOT 1

CROSSROADS COLORADO

36

HORIZON/70

FAIRWAY PARK SUBDIVISION

BOOKCLIFF

REPLAT OF LOT 2 EXC. NELY 2.56 FT & LOT 3 OF HOMESTEAD SUB.

COUNTRY

HOMESTEAD SUB.

V.C.B. MINOR SUB

CLUB

APPLEBEE'S SUBDIVISION

NORTHSIDE PARK

HORIZON

NINE IRON DRIVE

FAIRWAY DRIVE

BRASSIE DRIVE

SUNKER DRIVE

DRIVE

DRIVE


DRIVE

SIGN FACE WITH TRIM: 147" X 294" = 300 SQ. FT.



28 ft 40 ft

Ground Level

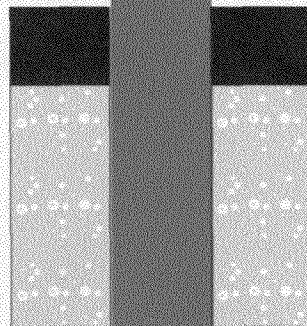

2 ft

6 ft

7-8 ft

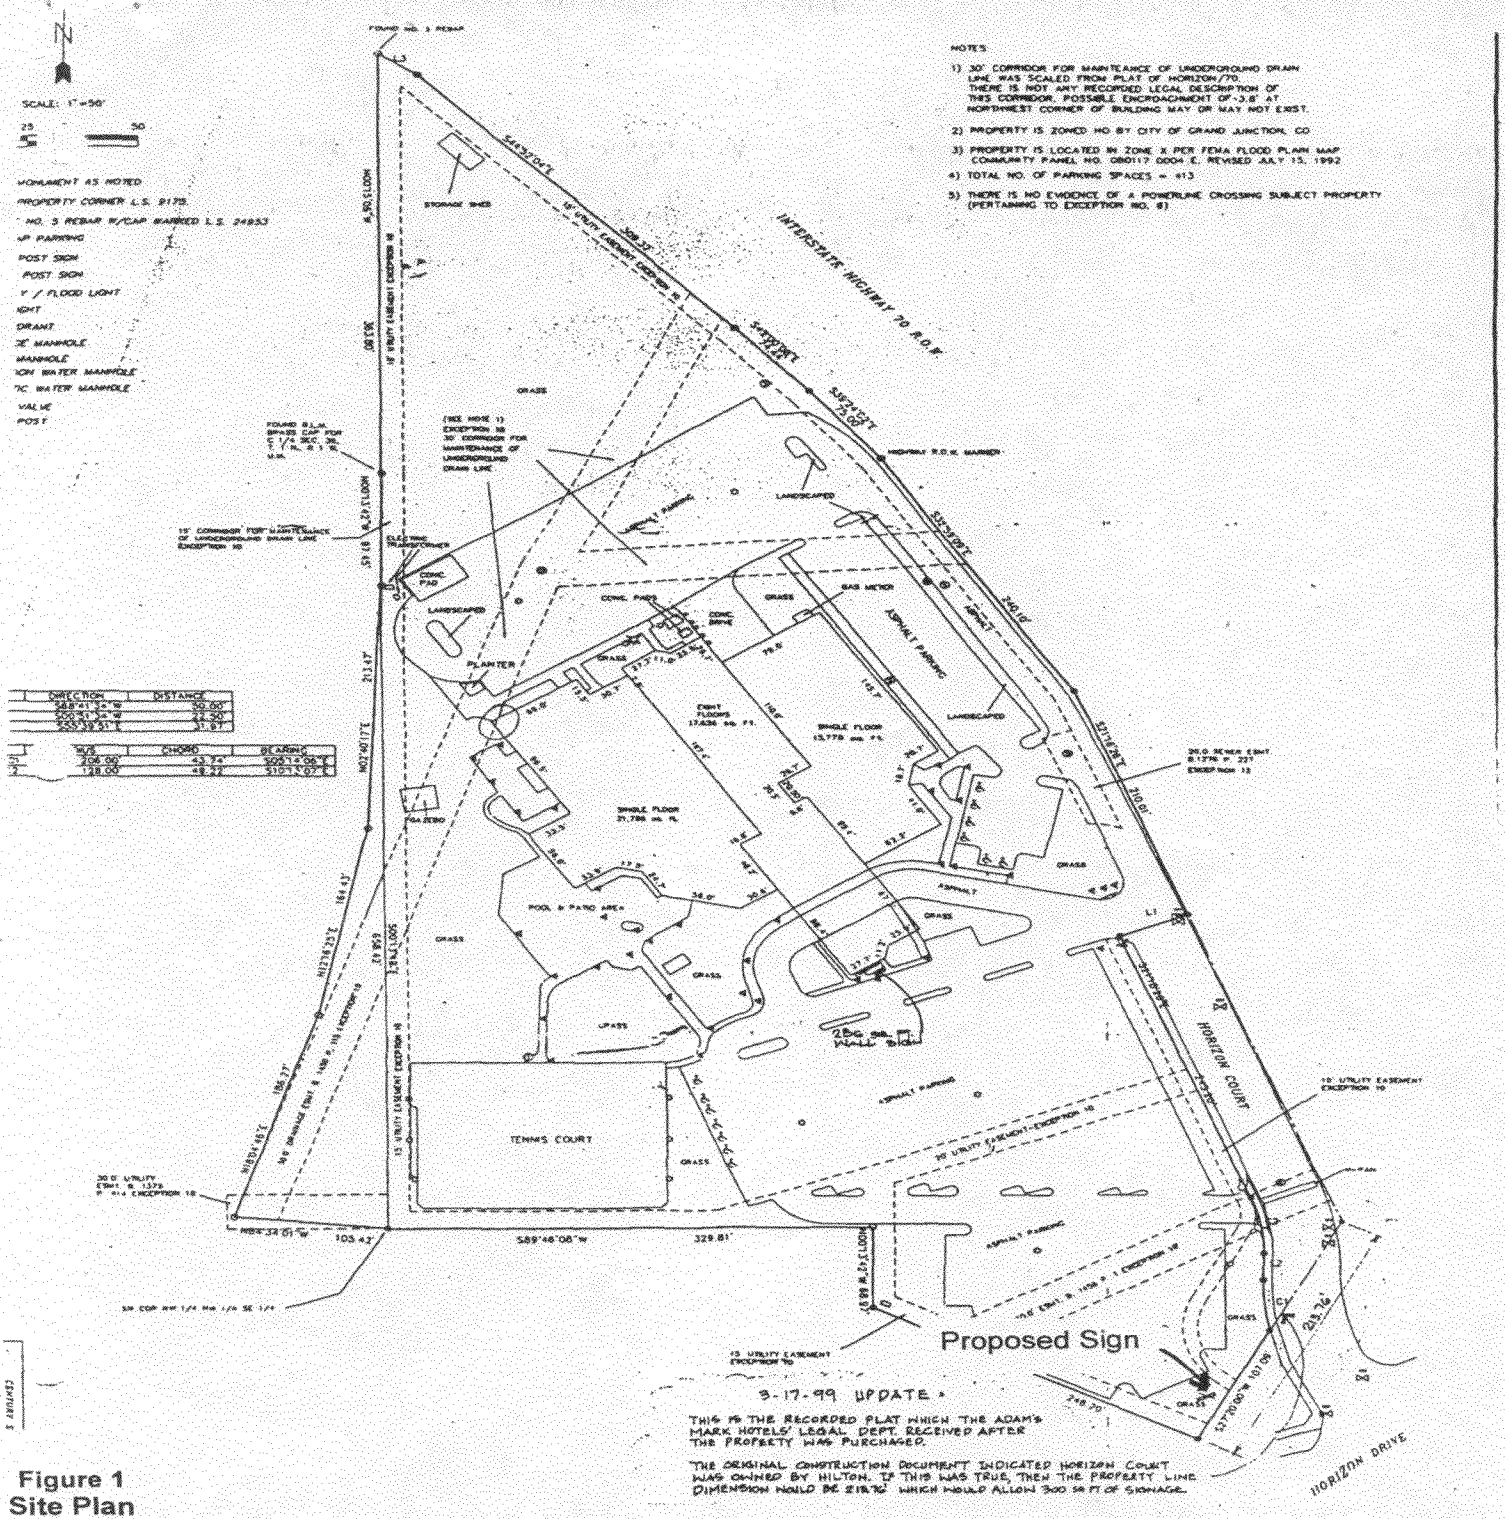


Figure 1
Site Plan
 Adam's Mark Hotel
 Horizon Drive