



# SIGN Permit

Community Development Department  
 250 North 5<sup>th</sup> Street  
 Grand Junction CO 81501  
 Phone: (970) 244-1430 FAX (970) 256-4031

(A)  
(C)

Permit No. \_\_\_\_\_  
 Date Submitted 11-28-04  
 Fee \$ 25.00  
 Zone C-1

TAX SCHEDULE 2761-364-28-008 CONTRACTOR Western Moon Sign Co  
 BUSINESS NAME Double Tree Hotel LICENSE NO. 2040561  
 STREET ADDRESS 743 Horizon Dr ADDRESS 3183 Hall Ave Grand Jct  
 PROPERTY OWNER Morgan Stanley Real Estate TELEPHONE NO. 523 4045  
 OWNER ADDRESS 1585 Broadway 37 Fl CONTACT PERSON Ray McManus  
New York NY 10036 241-9661

1. FLUSH WALL 2 Square Feet per Linear Foot of Building Façade  
Face change only on items 2, 3 & 4  
 2. ROOF 2 Square Feet per Linear Foot of Building Façade  
 3. FREE-STANDING 2 Traffic Lanes - 0.75 Square Feet x Street Frontage  
 4 or more Traffic Lanes - 1.5 Square Feet x Street Frontage  
 4. PROJECTING 0.5 Square Feet per each Linear Foot of Building Façade

Existing Externally or Internally Illuminated - No Change in Electrical Service  Non-Illuminated

(1 - 4) Area of Proposed Sign: 200 Square Feet  
 (1,2,4) Building Façade: 135 Linear Feet (Horizon)  
 (1 - 4) Street Frontage: 135 Linear Feet (Horizon)  
 (2 - 4) Height to Top of Sign: 40 Feet Clearance to Grade: 27.25 Feet

EXISTING SIGNAGE/TYPE:

(B) Bld. Canopy signs 41.25 Sq. Ft.  
 (C) Bld FW sign 225.05 Sq. Ft.  
 \_\_\_\_\_ Sq. Ft.  
 Total Existing: 266.3 Sq. Ft.

● FOR OFFICE USE ONLY ●

Signage Allowed on Parcel: Horizon Dr.  
 Building 550 Sq. Ft.  
 Free-Standing 202.5 Sq. Ft.  
 Total Allowed: 550 Sq. Ft.

COMMENTS: \_\_\_\_\_

NOTE: No sign may exceed 300 square feet. A separate sign permit is required for each sign. Attach a sketch, to scale, of proposed and existing signage including types, dimensions and lettering. Attach a plot plan, to scale, showing: abutting streets, alleys, easements, driveways, encroachments, property lines, distances from existing buildings to proposed signs and required setbacks. Roof signs shall be manufactured such that no guy wires, braces or supports shall be visible.

I hereby attest that the information on this form and the attached sketches are true and accurate.

Ray McManus 10/28/04 Y. Hsu 11/2/04  
 Applicant's Signature Date Community Development Approval Date

(B) 5c



# SIGN Permit

Community Development Department  
250 North 5<sup>th</sup> Street  
Grand Junction CO 81501  
Phone: (970) 244-1430 FAX (970) 256-4031

Permit No.	_____
Date Submitted	<u>10-28-04</u>
Fee \$	<u>5.00</u>
Zone	<u>C-1</u>

TAX SCHEDULE	<u>2701-364-28-008</u>	CONTRACTOR	<u>Western Neon Sign Co</u>
BUSINESS NAME	<u>Double Tree Hotel</u>	LICENSE NO.	<u>204 0561</u>
STREET ADDRESS	<u>743 Horizon Dr</u>	ADDRESS	<u>3183 Hall Ave Grand Jct</u>
PROPERTY OWNER	<u>Morgan Stanley Real Estate Funds</u>	TELEPHONE NO.	<u>923-4045</u>
OWNER ADDRESS	<u>1555 Broadway 37 FL</u> <u>New York NY 10036</u>	CONTACT PERSON	<u>Ray McManus 241-9461</u>

<input checked="" type="checkbox"/> 1. FLUSH WALL	2 Square Feet per Linear Foot of Building Façade
<input type="checkbox"/> 2. ROOF	2 Square Feet per Linear Foot of Building Façade
<input type="checkbox"/> 3. FREE-STANDING	2 Traffic Lanes - 0.75 Square Feet x Street Frontage
<input type="checkbox"/> 4. PROJECTING	4 or more Traffic Lanes - 1.5 Square Feet x Street Frontage
	0.5 Square Feet per each Linear Foot of Building Façade

Existing Externally or Internally Illuminated - No Change in Electrical Service       Non-Illuminated

(1 - 4) Area of Proposed Sign: 41.25 Square Feet  
 (1,2,4) Building Façade: 275 Linear Feet (Horizon Dr)  
 (1 - 4) Street Frontage: 135 Linear Feet (Horizon)  
 (2 - 4) Height to Top of Sign: \_\_\_\_\_ Feet      Clearance to Grade: \_\_\_\_\_ Feet

EXISTING SIGNAGE/TYPE:

<u>Free standing</u>	<u>200</u> Sq. Ft.
<u>Bld FW sign</u>	<u>225.05</u> Sq. Ft.
_____	_____ Sq. Ft.
Total Existing:	<u>425.05</u> Sq. Ft.

● FOR OFFICE USE ONLY ●

Signage Allowed on Parcel: Horizon

Building	<u>550</u> Sq. Ft.
Free-Standing	<u>202.5</u> Sq. Ft.
Total Allowed:	<u>550</u> Sq. Ft.

COMMENTS: \_\_\_\_\_

NOTE: No sign may exceed 300 square feet. A separate sign permit is required for each sign. Attach a sketch, to scale, of proposed and existing signage including types, dimensions and lettering. Attach a plot plan, to scale, showing: abutting streets, alleys, easements, driveways, encroachments, property lines, distances from existing buildings to proposed signs and required setbacks. Roof signs shall be manufactured such that no guy wires, braces or supports shall be visible.

I hereby attest that the information on this form and the attached sketches are true and accurate.

Ray McManus      10/28/04      [Signature]      11/2/04  
 Applicant's Signature      Date      Community Development Approval      Date



# SIGN PERMIT

(B) N

Community Development Department  
250 North 5th Street  
Grand Junction, CO 81501  
(970) 244-1430

Permit No. \_\_\_\_\_  
Date Submitted 10-28-04  
FEE \$ 5.00  
Tax Schedule 2701-364-28-008  
Zone C-1

BUSINESS NAME Double Tree Hotel CONTRACTOR Western Neon Sign Co  
STREET ADDRESS 743 Horizon Dr LICENSE NO. 2040568  
PROPERTY OWNER Morgan Stanley Real Estate Funds ADDRESS 3183 Hall Ave Grand Jct CO  
OWNER ADDRESS 1585 Broadway FL 37 TELEPHONE NO. 923 4045 - Home 241-9661  
New York NY 10036

- 1. FLUSH WALL 2 Square Feet per Linear Foot of Building Facade
- Face Change Only (2,3 & 4):**
- 2. ROOF 2 Square Feet per Linear Foot of Building Facade
- 3. FREE-STANDING 2 Traffic Lanes - 0.75 Square Feet x Street Frontage  
4 or more Traffic Lanes - 1.5 Square Feet x Street Frontage
- 4. PROJECTING 0.5 Square Feet per each Linear Foot of Building Facade

Existing Externally or Internally Illuminated - No Change in Electrical Service  Non-Illuminated

(1 - 4) Area of Proposed Sign 41.25 Square Feet  
(1,2,4) Building Facade 275 Linear Feet (Horizon)  
(1 - 4) Street Frontage 135 Linear Feet (Horizon)  
(2,3,4) Height to Top of Sign \_\_\_\_\_ Feet Clearance to Grade \_\_\_\_\_ Feet

Existing Signage/Type:	
	Sq. Ft.
	Sq. Ft.
	Sq. Ft.
Total Existing:	Sq. Ft.

● FOR OFFICE USE ONLY ●	
Signage Allowed on Parcel: <u>Horizon Dr.</u>	
Building	<u>550</u> Sq. Ft.
Free-Standing	<u>202.5</u> Sq. Ft.
Total Allowed:	<u>550</u> Sq. Ft.

COMMENTS: \_\_\_\_\_

**NOTE:** No sign may exceed 300 square feet. A separate sign permit is required for each sign. Attach a sketch of proposed and existing signage including types, dimensions, lettering, abutting streets, alleys, easements, property lines, and locations. Roof signs shall be manufactured such that no guy wires, braces or supports shall be visible.

Ray McManis  
Applicant's Signature

10/28/04  
Date

Y. Hsieh  
Community Development Approval

11/2/04  
Date

(White: Community Development)

(Canary: Applicant)

(Pink: Code Enforcement)

West



# SIGN Permit

Community Development Department  
250 North 5<sup>th</sup> Street  
Grand Junction CO 81501  
Phone: (970) 244-1430 FAX (970) 256-4031

Permit No.	_____
Date Submitted	<u>10-28-04</u>
Fee \$	<u>5.00</u>
Zone	<u>C-1</u>

TAX SCHEDULE <u>2701-364-28-008</u>	CONTRACTOR <u>Western neon sign Co</u>
BUSINESS NAME <u>Double Tree Hotel</u>	LICENSE NO. <u>2040561</u>
STREET ADDRESS <u>743 Horizon Dr</u>	ADDRESS <u>3183 Hall Ave Grand Jct</u>
PROPERTY OWNER <u>Morgan Stanley Real Estate Funds</u>	TELEPHONE NO. <u>523 4045</u>
OWNER ADDRESS <u>158 E Broadway 31 E</u> <u>New York NY 10036</u>	CONTACT PERSON <u>Ray McManus</u> <u>241-9661</u>

<input checked="" type="checkbox"/> 1. FLUSH WALL	2 Square Feet per Linear Foot of Building Façade
<u>Face change only on items 2, 3 &amp; 4</u>	
<input type="checkbox"/> 2. ROOF	2 Square Feet per Linear Foot of Building Façade
<input type="checkbox"/> 3. FREE-STANDING	2 Traffic Lanes - 0.75 Square Feet x Street Frontage
	4 or more Traffic Lanes - 1.5 Square Feet x Street Frontage
<input type="checkbox"/> 4. PROJECTING	0.5 Square Feet per each Linear Foot of Building Façade

Existing Externally or Internally Illuminated - No Change in Electrical Service       Non-Illuminated

(1 - 4) Area of Proposed Sign: 225.05 Square Feet  
 (1,2,4) Building Façade: 275 Linear Feet  
 (1 - 4) Street Frontage: 1220 Linear Feet  
 (2 - 4) Height to Top of Sign: \_\_\_\_\_ Feet      Clearance to Grade: \_\_\_\_\_ Feet

<b>EXISTING SIGNAGE/TYPE:</b>	
_____	_____ Sq. Ft.
_____	_____ Sq. Ft.
_____	_____ Sq. Ft.
Total Existing:	_____ Sq. Ft.

● FOR OFFICE USE ONLY ●	
Signage Allowed on Parcel:	<u>I-70</u>
Building	<u>550</u> Sq. Ft.
Free-Standing	<u>1830</u> Sq. Ft.
Total Allowed:	<u>1,830</u> Sq. Ft.

COMMENTS: \_\_\_\_\_

**NOTE:** No sign may exceed 300 square feet. A separate sign permit is required for each sign. Attach a sketch, to scale, of proposed and existing signage including types, dimensions and lettering. Attach a plot plan, to scale, showing: abutting streets, alleys, easements, driveways, encroachments, property lines, distances from existing buildings to proposed signs and required setbacks. Roof signs shall be manufactured such that no guy wires, braces or supports shall be visible.

I hereby attest that the information on this form and the attached sketches are true and accurate.

<u>Ray McManus</u>	<u>10/28/04</u>	<u>Misha Magan</u>	<u>11/2/04</u>
Applicant's Signature	Date	Community Development Approval	Date

(White: Community Development)      (Canary: Applicant)      (Pink: Code Enforcement)

East



# SIGN Permit

Community Development Department  
250 North 5<sup>th</sup> Street  
Grand Junction CO 81501  
Phone: (970) 244-1430 FAX (970) 256-4031

Permit No.	_____
Date Submitted	<u>10-28-04</u>
Fee \$	<u>5.00</u>
Zone	<u>C-1</u>

TAX SCHEDULE	<u>2761-364-28-008</u>	CONTRACTOR	<u>Western Neon Sign Co</u>
BUSINESS NAME	<u>Double Tree Hotel</u>	LICENSE NO.	<u>2040561</u>
STREET ADDRESS	<u>743 Horizon Dr</u>	ADDRESS	<u>3183 Hall Ave Grand Jct.</u>
PROPERTY OWNER	<u>MSPA Acquisition II LP</u>	TELEPHONE NO.	<u>523 4045</u>
OWNER ADDRESS	<u>96 Morgan Stanley Real Estate Fund 1555 Broadway 37 Fl New York New York 10036</u>	CONTACT PERSON	<u>Ray McManus 241-9661</u>

<input checked="" type="checkbox"/> 1. FLUSH WALL	2 Square Feet per Linear Foot of Building Façade
<input type="checkbox"/> 2. ROOF	2 Square Feet per Linear Foot of Building Façade
<input checked="" type="checkbox"/> 3. FREE-STANDING	2 Traffic Lanes - 0.75 Square Feet x Street Frontage
<input type="checkbox"/> 4. PROJECTING	4 or more Traffic Lanes - 1.5 Square Feet x Street Frontage
	0.5 Square Feet per each Linear Foot of Building Façade

Existing Externally or Internally Illuminated - No Change in Electrical Service       Non-Illuminated

(1 - 4) Area of Proposed Sign: 225.05 Square Feet  
 (1,2,4) Building Façade: 275 Linear Feet (HORIZON)  
 (1 - 4) Street Frontage: 135 Linear Feet  
 (2 - 4) Height to Top of Sign: 40 Feet      Clearance to Grade: 20 Feet

EXISTING SIGNAGE/TYPE:	
<del>Free Standing</del>	_____ Sq. Ft.
<u>Free Standing</u>	<u>200</u> Sq. Ft.
<u>FW canopy</u>	<u>41.25</u> Sq. Ft.
Total Existing:	<u>241.25</u> Sq. Ft.

● FOR OFFICE USE ONLY ●	
Signage Allowed on Parcel:	<u>HORIZON</u>
Building	<u>550</u> Sq. Ft.
Free-Standing	<u>202.5</u> Sq. Ft.
Total Allowed:	<u>550</u> Sq. Ft.

COMMENTS: \_\_\_\_\_

NOTE: No sign may exceed 300 square feet. A separate sign permit is required for each sign. Attach a sketch, to scale, of proposed and existing signage including types, dimensions and lettering. Attach a plot plan, to scale, showing: abutting streets, alleys, easements, driveways, encroachments, property lines, distances from existing buildings to proposed signs and required setbacks. Roof signs shall be manufactured such that no guy wires, braces or supports shall be visible.

I hereby attest that the information on this form and the attached sketches are true and accurate.

Ray McManus      10/28/04      Asli Aragon      11/2/04  
 Applicant's Signature      Date      Community Development Approval      Date

20'-0"

12"  
9"

# DOUBLE TREE HOTEL

## A ALUMINUM REPLACEMENT FACE


SCALE: 1/2" = 1'-0"

### SIGN SPECIFICATIONS:


EXISTING ALUMINUM CABINET SIGN w/ NEW ALUMINUM REPLACEMENT FACE PAINTED TO MATCH EXISTING CANOPY COLOR.

NEW ALUMINUM FACE TO HAVE ROUTED-OUT LETTERS w/ WHITE PLASTIC SHOW-THRU LETTERS.

**277 VOLTS**

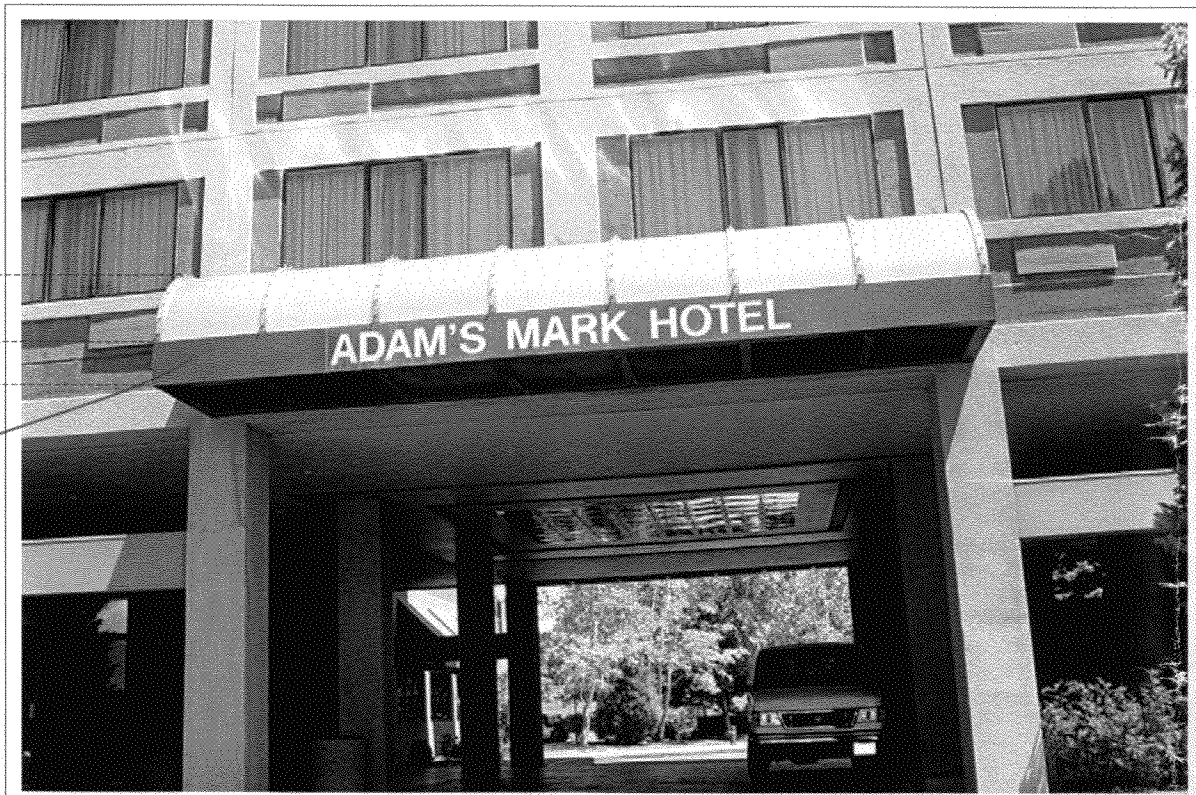

BEFORE

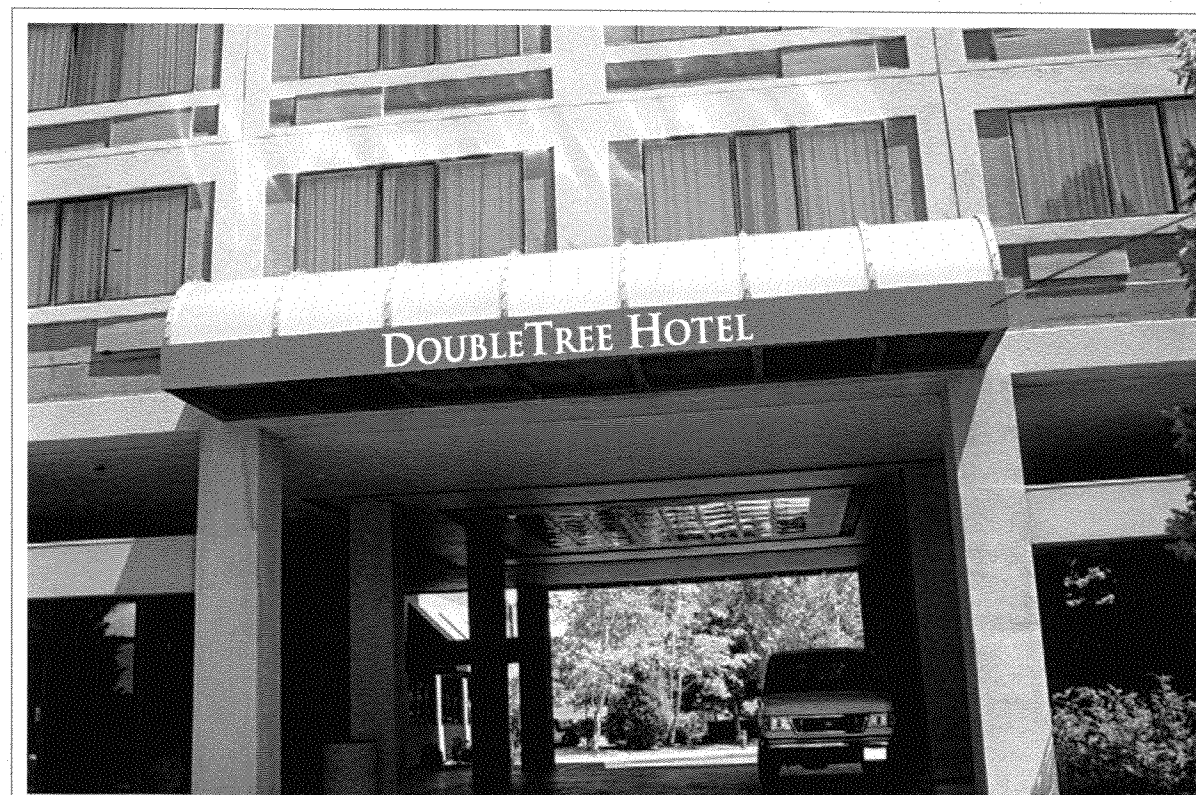

AFTER

## A PHOTO LAYOUT @ CANOPY

NO SCALE

PHOTO LAYOUT FOR PRESENTATION PURPOSES. VERIFY ACTUAL INSTALLATION & DIMENSIONS.

**Chandler Signs**  
www.chandler signs.com

3201 Manor Way  
Dallas, TX 75235  
12106 Yalliant Drive  
San Antonio, TX 78216  
P.O. Box 43123  
Louisville, KY 40253

214-902-2000  
Fax 214-902-2044  
210-349-3804  
Fax 210-349-8724  
502-489-3660  
Fax 502-254-3843

750 E. Hwy. 24 - Bldg. 2, Ste. 200  
Woodland Park, CO 80863  
2420 Vista Way - Ste. 200  
Oceanside, CA 92054  
719-687-2507  
Fax 719-687-2506  
760-967-7003  
Fax 760-967-7033  
This drawing is the property of Chandler Signs, L.P. and all rights to its use for reproduction are reserved by Chandler Signs, L.P.

R1:10/25/04:JC: DELETED SIGN ©

Client \_\_\_\_\_  
Sales \_\_\_\_\_  
Estimating \_\_\_\_\_  
Art \_\_\_\_\_  
Engineering \_\_\_\_\_  
Landlord \_\_\_\_\_


Design # C45158R2 Sheet 1 of 6  
Sales/Coordinator R. HANSON / J. LEE  
Designer J. CASTILLO Date 10/25/04




Client DOUBLETREE HOTEL  
Street 743 HORIZON  
City / State GRAND JUNCTION, CO

**FINAL ELECTRICAL CONNECTION BY CUSTOMER**



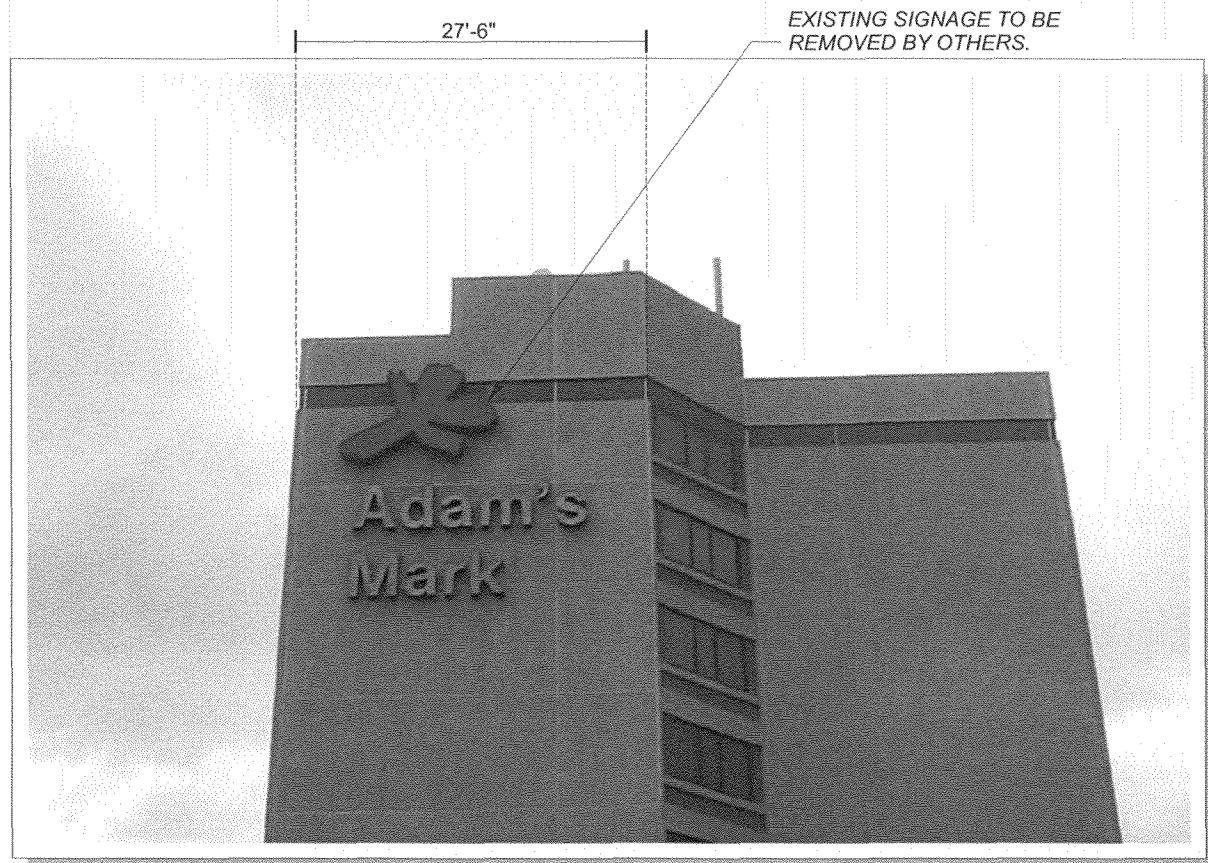

BEFORE

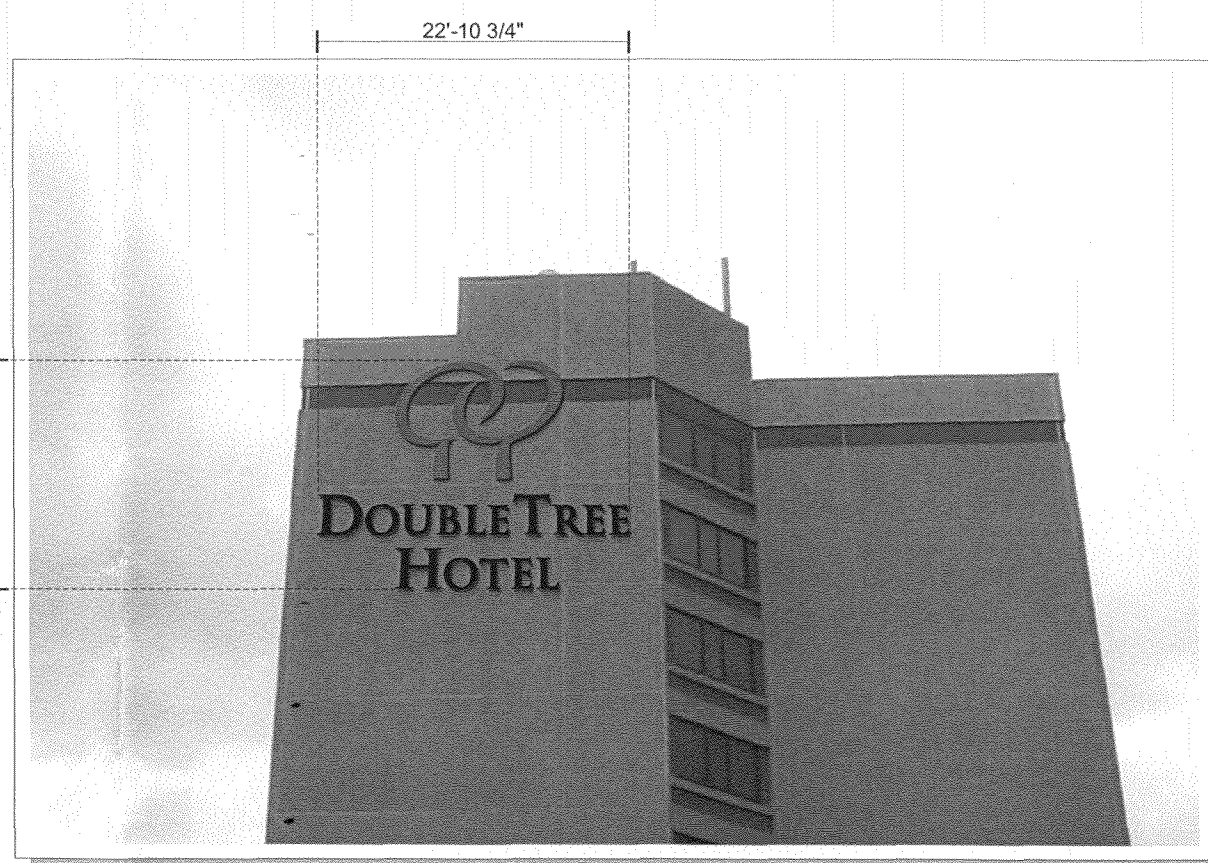

AFTER

EXISTING SIGNAGE TO BE REMOVED BY OTHERS.

17'-10 1/4"

**B PHOTO LAYOUT @ ELEVATION**  
NO SCALE

PHOTO LAYOUT FOR PRESENTATION PURPOSES.  
VERIFY ACTUAL INSTALLATION & DIMENSIONS.

Work Order  
XXXXXXXX  
Engineer  
XXXXXX

**Chandler Signs**  
www.chandlersigns.com

3201 Manor Way  
Dallas, TX 75235  
12104 Yalliant Drive  
San Antonio, TX 78216  
P.O. Box 43123  
Louisville, KY 40253


214-902-2000  
Fax 214-902-2044  
210-349-3804  
Fax 210-349-8724  
502-489-3660  
Fax 502-254-3843

750 E. Hwy. 24 - Bldg. 2, Ste. 200  
Woodland Park, CO 80863  
2420 Vista Way - Ste. 200  
Oceanside, CA 92054  
719-687-2507  
Fax 719-687-2506  
760-967-7003  
Fax 760-967-7033  
This drawing is the property of Chandler Signs, L.P. and all rights to its use for reproduction are reserved by Chandler Signs, L.P.

R1:10/25/04:JC: DELETED SIGN


Client	
Sales	
Estimating	
Art	
Engineering	
Landlord	

Design # C45158R2 Sheet 2 of 6  
Sales/Coordinator R. HANSON / J. LEE  
Designer J. CASTILLO Date 10/25/04

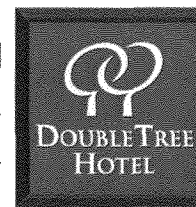

Client DOUBLETREE HOTEL  
Street 743 HORIZON  
City / State GRAND JUNCTION, CO

**FINAL ELECTRICAL CONNECTION BY CUSTOMER**  
UL SIGN(S) TO BE MANUFACTURED TO U.L. SPECIFICATIONS AND WILL BEAR THE U.L. LABEL(S). INSTALL IN ACCORDANCE WITH NATIONAL ELECTRIC CODES

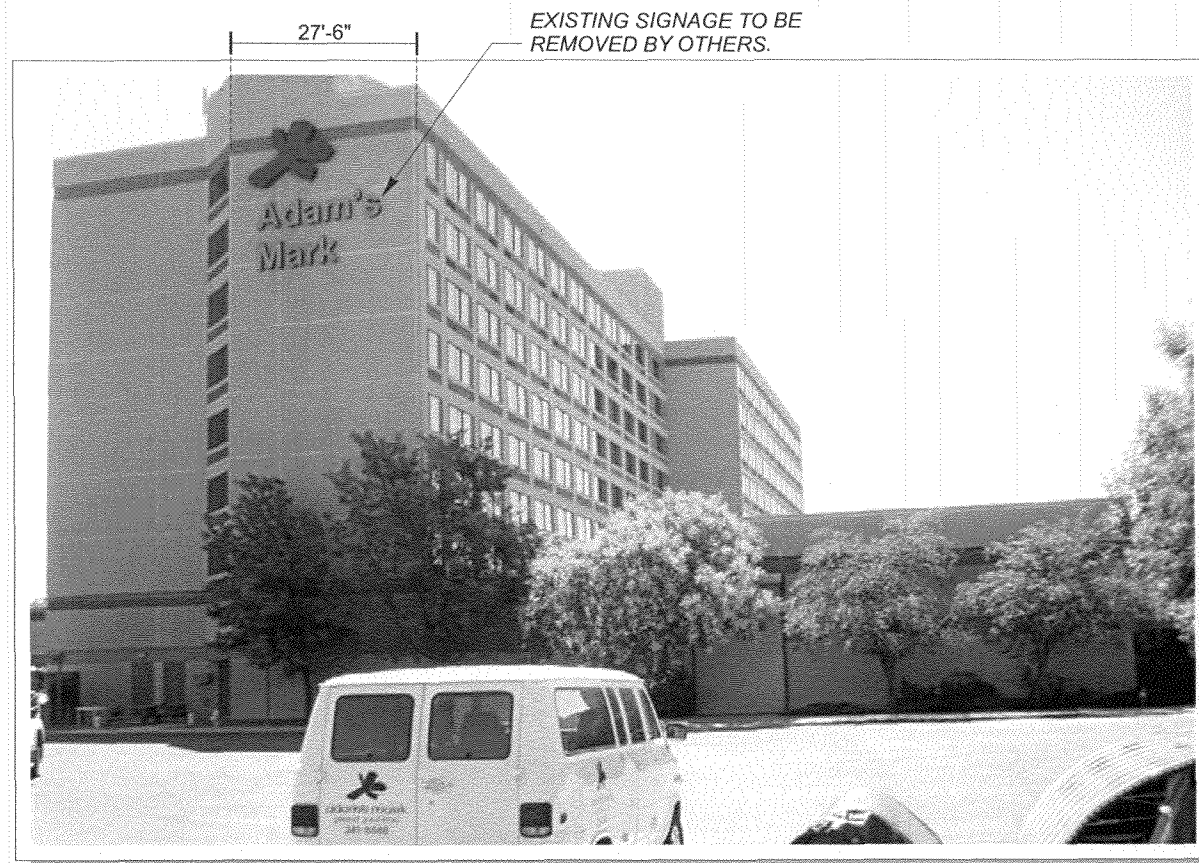

BEFORE

EXISTING SIGNAGE TO BE REMOVED BY OTHERS.



AFTER

**PHOTO LAYOUT @ ELEVATION**

NO SCALE

PHOTO LAYOUT FOR PRESENTATION PURPOSES. VERIFY ACTUAL INSTALLATION & DIMENSIONS.

**Chandler Signs**  
www.chandler signs.com

3201 Manor Way  
Dallas, TX 75235  
12106 Valliant Drive  
San Antonio, TX 78216  
P.O. Box 43123  
Louisville, KY 40253


214-902-2000  
Fax 214-902-2044  
210-349-3804  
Fax 210-349-8724  
502-489-3660  
Fax 502-254-3843

750 E. Hwy. 24 - Bldg. 2, Ste. 200  
Woodland Park, CO 80863  
2420 Vista Way - Ste. 200  
Oceanside, CA 92054  
719-687-2507  
Fax 719-687-2506  
760-967-7003  
Fax 760-967-7033  
This drawing is the property of Chandler Signs, L.P. and all rights to its use for reproduction are reserved by Chandler Signs, L.P.

R1:10/25/04:JC: DELETED SIGN

Client	
Sales	
Estimating	
Art	
Engineering	
Landlord	

Design # C45158R2 Sheet 3 of 6  
Sales/Coordinator R. HANSON / J. LEE  
Designer J. CASTILLO Date 10/25/04


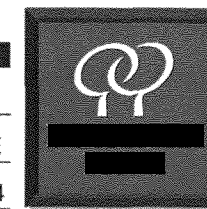


Client DOUBLETREE HOTEL  
Street 743 HORIZON  
City / State GRAND JUNCTION, CO

**FINAL ELECTRICAL CONNECTION BY CUSTOMER**

Work Order  
XXXXXXXX  
Engineer  
XXXXXXXX



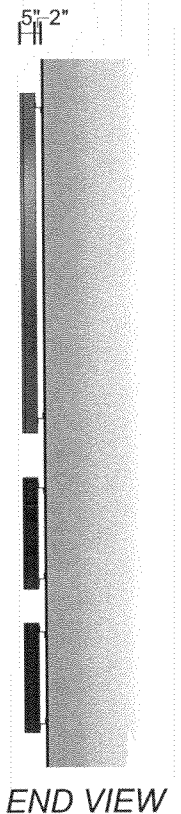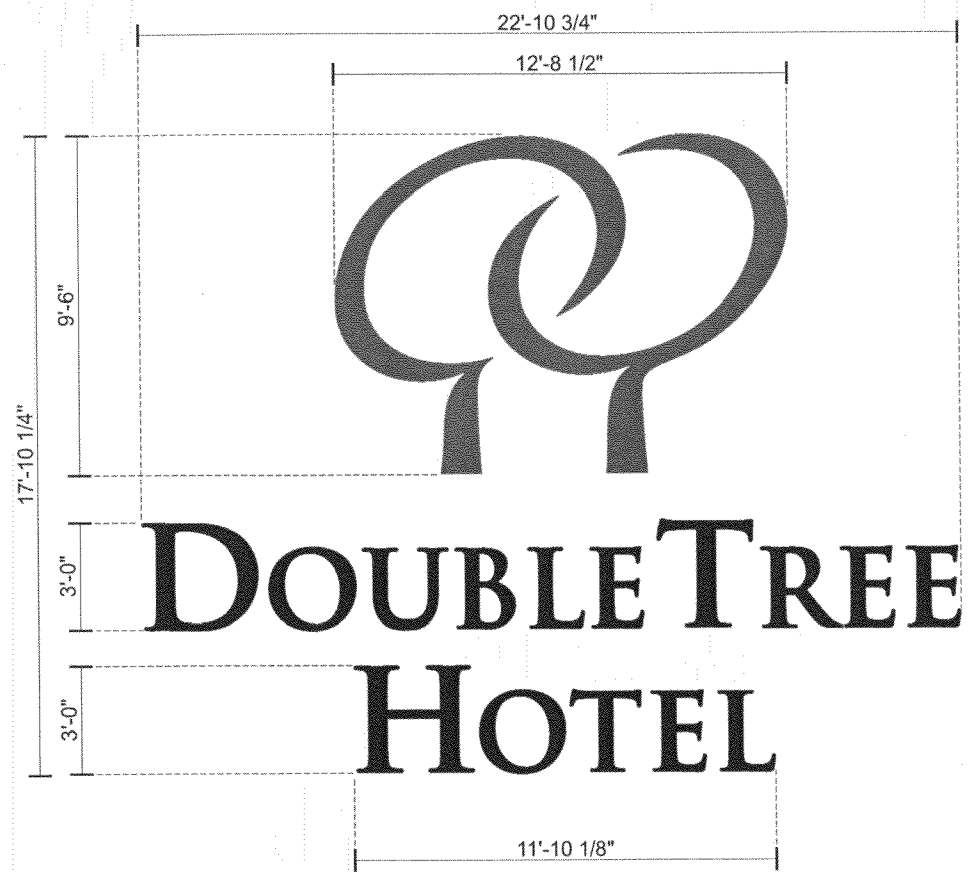

- COLOR SPECIFICATIONS:**  
**LIGHT-COLORED BUILDING:**  
**LETTERS:**
- .040" THK. ALUMINUM RETURNS PAINTED TO MATCH #313 DARK BRONZE, SEMI-GLOSS FINISH.
  - .063" THK. ALUMINUM CAD CUT LETTER BACKS.
  - LETTER INTERIORS PAINTED STARBRIGHT LIGHT ENHANCING PAINT.
  - .150" THK. WHITE LEXAN FACES w/ 1st SURFACE VT-8094 DARK RED VINYL.
  - 1" THK. BRONZE JEWELITE RETAINERS.
  - RED GELCORE L.E.D. ILLUMINATION.
  - REMOTE POWER SUPPLIES.
  - LETTERS TO BE CLIP-MOUNTED TO BUILDING WALL.

- LOGO:**
- .040" THK. ALUMINUM RETURNS PAINTED TO MATCH PMS 323 TEAL, SEMI-GLOSS FINISH.
  - .063" THK. ALUMINUM CAD CUT LETTER BACKS.
  - LOGO INTERIOR PAINTED STARBRIGHT LIGHT ENHANCING PAINT.
  - .150" THK. WHITE LEXAN FACES w/ 1st SURFACE #DN00113 3M TEAL DUAL FILM (TEAL BY DAY / WHITE BY NIGHT).
  - .050" THK. ALUMINUM RETAINERS PAINTED TO MATCH PMS 323 TEAL.
  - WHITE L.E.D. ILLUMINATION.
  - REMOTE POWER SUPPLIES.
  - LOGO TO BE CLIP-MOUNTED TO BUILDING WALL.

**277 VOLTS**

**B C CHANNEL LETTER & LOGO LAYOUT (L.E.D.)**  
 SCALE: 3/16" = 1'-0"

*225.05 sq ft*

**Chandler Signs**  
 www.chandlersigns.com

3201 Manor Way  
 Dallas, TX 75235  
 214-902-2000  
 Fax 214-902-2044  
 12106 Valliant Drive  
 San Antonio, TX 78216  
 210-349-3804  
 Fax 210-349-8724  
 P.O. Box 43123  
 Louisville, KY 40253  
 502-489-3660  
 Fax 502-254-3843


750 E. Hwy. 24 - Bldg. 2, Ste. 200  
 Woodland Park, CO 80863  
 719-687-2507  
 Fax 719-687-2506  
 2420 Vista Way - Ste. 200  
 Oceanside, CA 92054  
 760-967-7003  
 Fax 760-967-7033

This drawing is the property of Chandler Signs, L.P. and all rights to its use for reproduction are reserved by Chandler Signs, L.P.

R1:10/25/04:JC: DELETED SIGN

Client	
Sales	
Estimating	
Art	
Engineering	
Landlord	

Design # C45158R2 Sheet 4 of 6  
 Sales/Coordinator R. HANSON / J. LEE  
 Designer J. CASTILLO Date 10/25/04

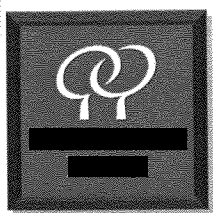


Client DOUBLETREE HOTEL  
 Street 743 HORIZON  
 City / State GRAND JUNCTION, CO

**FINAL ELECTRICAL CONNECTION BY CUSTOMER**

Work Order  
 XXXXXXXX  
 Engineer  
 DATE

A

EXISTING SIGNAGE TO BE REMOVED BY OTHERS.

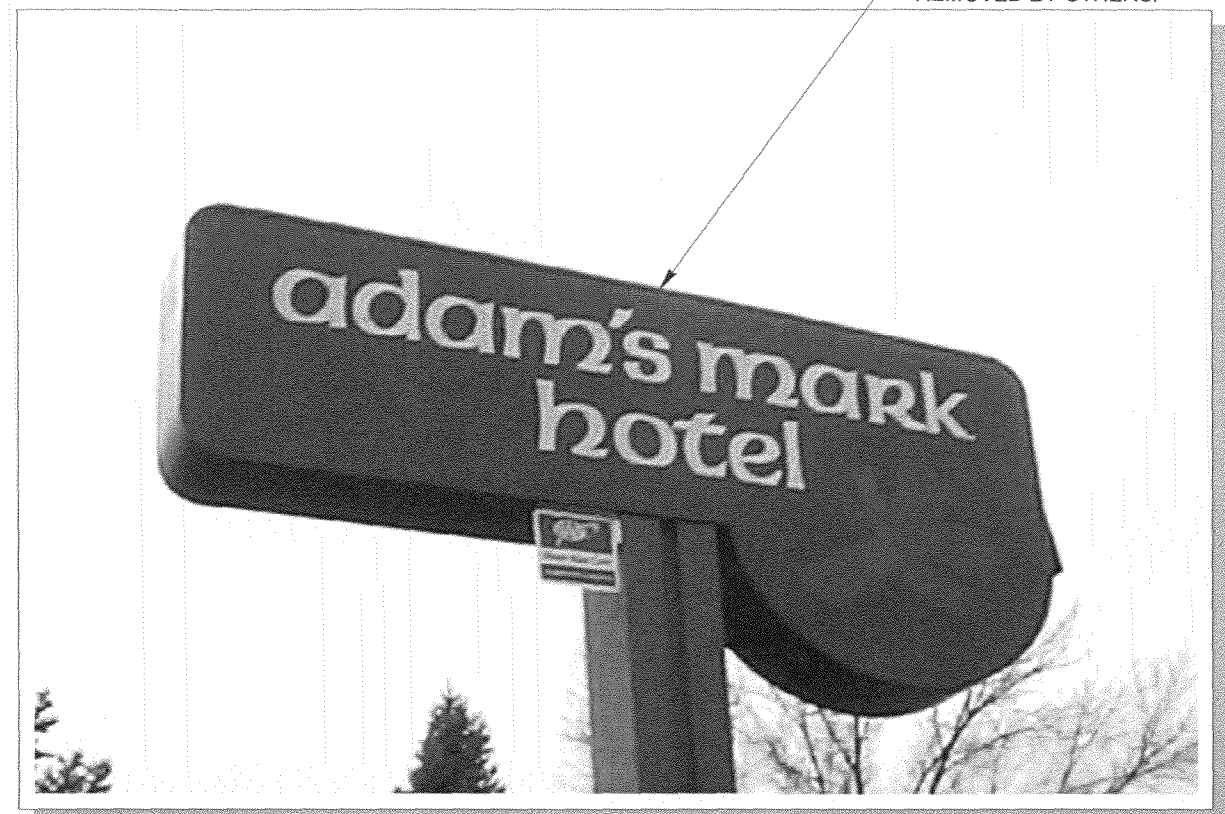

BEFORE

AFTER

**D PHOTO LAYOUT @ D/F PYLON SIGN**  
NO SCALE

PHOTO LAYOUT FOR PRESENTATION PURPOSES.  
VERIFY ACTUAL INSTALLATION & DIMENSIONS.

**Chandler Signs**  
www.chandler signs.com


3201 Manor Way  
Dallas, TX 75235  
214-902-2000  
Fax 214-902-2044  
12106 Valliant Drive  
San Antonio, TX 78216  
210-349-3804  
Fax 210-349-8724  
P.O. Box 43123  
Louisville, KY 40253  
502-489-3660  
Fax 502-254-3843

750 E. Hwy. 24 - Bldg. 2, Ste. 200  
Woodland Park, CO 80863  
719-687-2507  
Fax 719-687-2506  
2420 Vista Way - Ste. 200  
Oceanside, CA 92054  
760-967-7003  
Fax 760-967-7033  
This drawing is the property of Chandler Signs, L.P. and all rights to its use for reproduction are reserved by Chandler Signs, L.P.

REVISION / DATE
R1:10/25/04:JC: DELETED SIGN ©



APPROVAL / DATE
Client
Sales
Estimating
Art
Engineering
Landlord

Design # C45158R2 Sheet 5 of 6  
Sales/Coordinator R. HANSON / J. LEE  
Designer J. CASTILLO Date 10/25/04

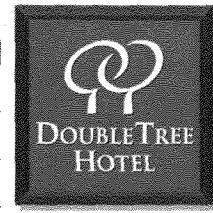

Client DOUBLETREE HOTEL  
Street 743 HORIZON  
City / State GRAND JUNCTION, CO

**FINAL ELECTRICAL CONNECTION BY CUSTOMER**

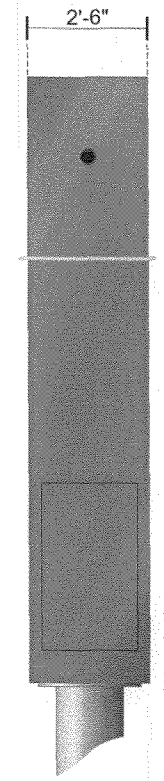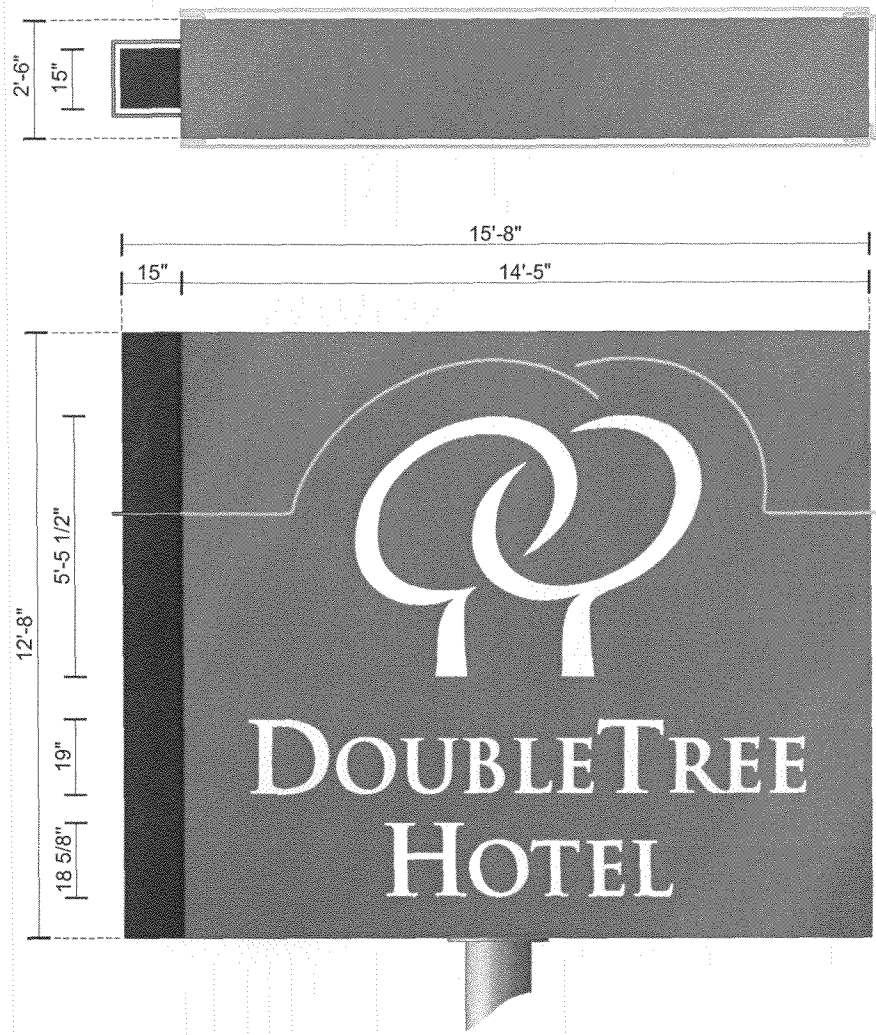

END VIEW

**SIGN SPECIFICATIONS:**

D/F INTERNALLY-ILLUMINATED ALUMINUM PYLON SIGN CABINET PAINTED TO MATCH PMS 323 TEAL. SIDE ACCENT TO BE PAINTED TO MATCH PMS 194 RED.

ALUMINUM FACES TO HAVE ROUTED & BACKED-UP WHITE POLYCARBONATE GRAPHICS.

EXPOSED SINGLE STROKE 15mm RUBY RED NEON WRAPS AROUND SIDE ACCENT BAND. EXPOSED SINGLE STROKE 15mm EMERALD GREEN NEON FOLLOWS CURVES OF LOGO AND WRAPS AROUND END OF PYLON CABINET.

SIGN INTERNALLY-ILLUMINATED w/ HIGH-OUTPUT FLUORESCENT LAMPS (TYPICAL).

EXISTING STEEL POLE SUPPORT TO BE PAINTED PMS COOL GRAY 10.



**D/F PYLON SIGN CABINET**

SCALE: 1/4" = 1'-0"

200 59 ft

