



SIGN PERMIT

2

Community Development Department
250 North 5th Street
Grand Junction, CO 81501
(970) 244-1430

Permit No. _____
Date Submitted 10-26-04
FEE \$ 25.00
Tax Schedule 2945-044-17-017
Zone C-1

BUSINESS NAME Computer Ambulance Service CONTRACTOR Soudough Signs
STREET ADDRESS 2478 Patterson Unit 16 LICENSE NO. 2041015
PROPERTY OWNER Tom + Debra Scott Jr LLC ADDRESS 2223 H. Rd
OWNER ADDRESS _____ TELEPHONE NO. 243-1383

- 1. FLUSH WALL 2 Square Feet per Linear Foot of Building Facade
- Face Change Only (2,3 & 4):
- 2. ROOF 2 Square Feet per Linear Foot of Building Facade
- 3. FREE-STANDING 2 Traffic Lanes - 0.75 Square Feet x Street Frontage
4 or more Traffic Lanes - 1.5 Square Feet x Street Frontage
- 4. PROJECTING 0.5 Square Feet per each Linear Foot of Building Facade

Existing Externally or Internally Illuminated - No Change in Electrical Service Non-Illuminated

(1 - 4) Area of Proposed Sign 25 Square Feet
(1,2,4) Building Facade 102 Linear Feet
(1 - 4) Street Frontage 330 Linear Feet
(2,3,4) Height to Top of Sign _____ Feet Clearance to Grade _____ Feet

| Existing Signage/Type: | Sq. Ft. |
|------------------------|---------|
| | |
| | |
| | |
| Total Existing: | |


| ● FOR OFFICE USE ONLY ● | |
|----------------------------|---------------------|
| Signage Allowed on Parcel: | <u>Patterson Rd</u> |
| Building | <u>1396</u> Sq. Ft. |
| Free-Standing | <u>495</u> Sq. Ft. |
| Total Allowed: | <u>1396</u> Sq. Ft. |

COMMENTS: _____

NOTE: No sign may exceed 300 square feet. A separate sign permit is required for each sign. Attach a sketch of proposed and existing signage including types, dimensions, lettering, abutting streets, alleys, easements, property lines, and locations. Roof signs shall be manufactured such that no guy wires, braces or supports shall be visible.

Sandra M. Holloway 10/26/04 Y. Ishii 10/27/04
Applicant's Signature Date Community Development Approval Date

(White: Community Development) (Canary: Applicant) (Pink: Code Enforcement)


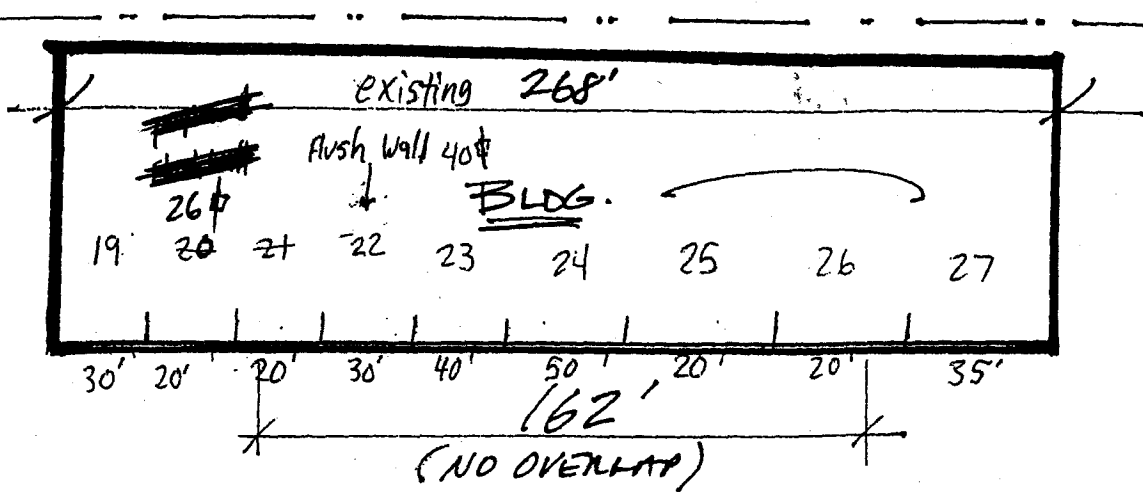


ST. FRONTAGE


$330' \times 1.5 = 495\phi$

Bldg. FRONTAGE

$698' \times 2 = 1396\phi$

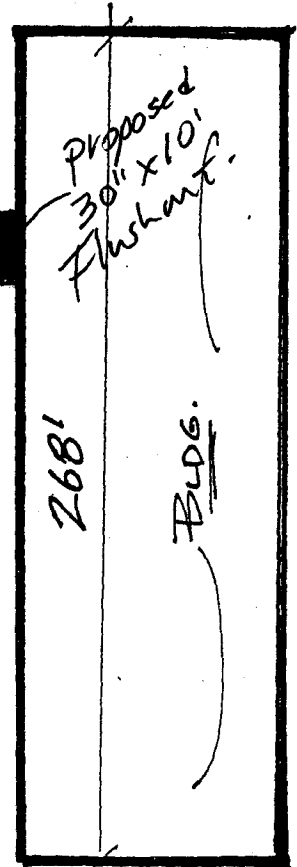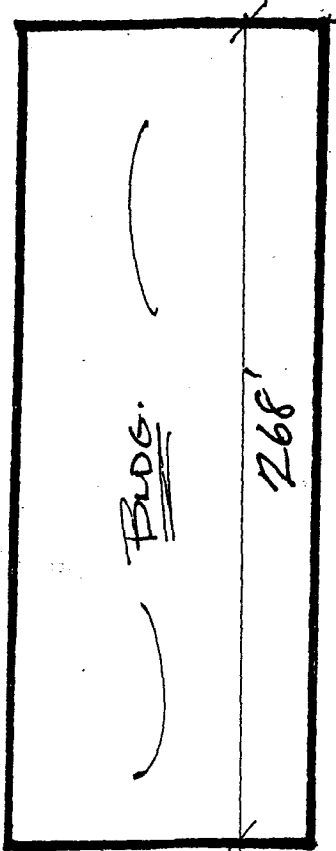

FREESTANDING
297\phi SIGN

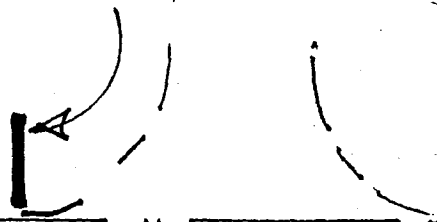

330'

2478

NORTH

10'

30"

OK
~~_____~~
OK

THIS SKETCH BELONGS TO
SOURDOUGH SIGNS