

This is drawing of Sign that will be mounted to masonry base & foundation.

ARCHITECT'S SUBMITTAL ACTION

- A-APPROVED
- B-APPROVED AS NOTED
- C-REVISE AND RESUBMIT
- D-NOT APPROVED
- E-NOT REQUIRED FOR A/E REVIEW


Action taken in accordance with conditions of the Contract Documents.

BLYTHE DESIGN +

BY pb DATE 9/13/04
 SUBMITTAL NO. 10400

Drawing Notes:
 All ModuLex Colors Formulated Abrasion Resistant
 w/ 1/8" Thick Non-Skid Surface and 1/2" Edge

enclosed top

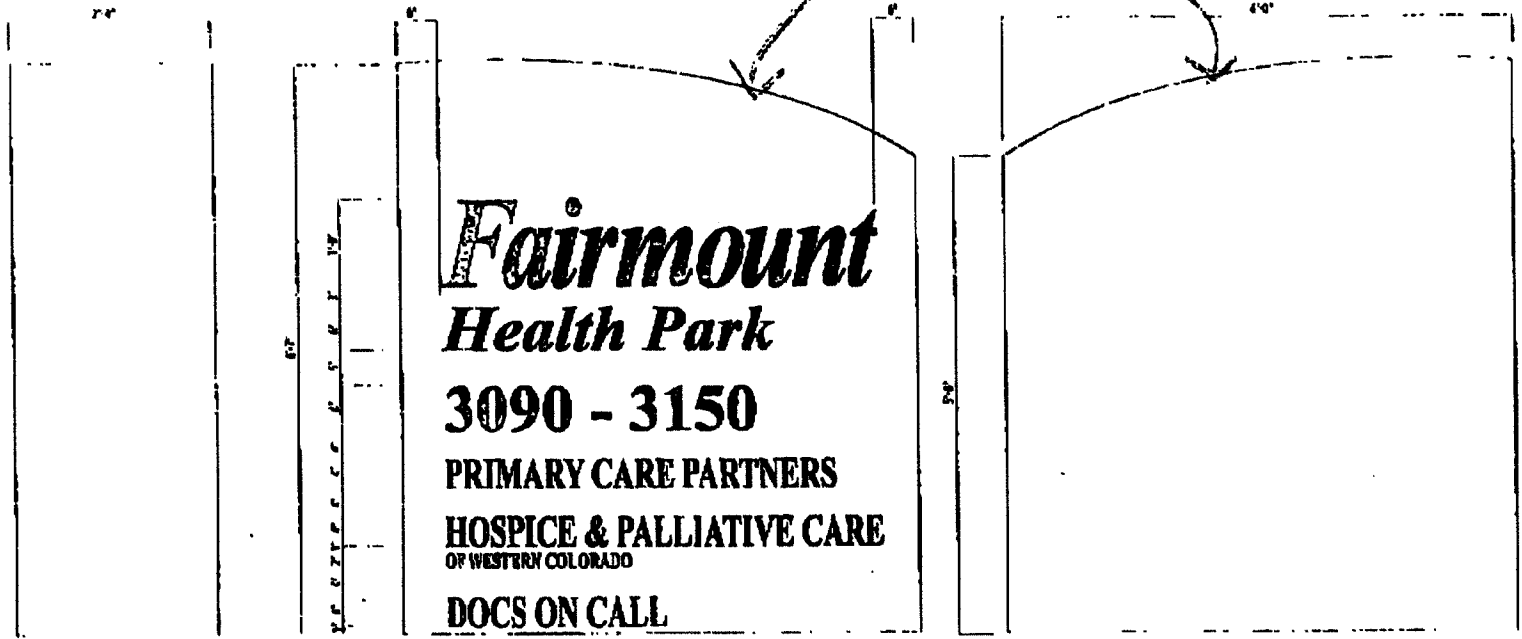

Job No: * Q 0918
 Project: * Internal Sign
 Reference: * PIP Invoices, 011
 Title: * 1/4" - 1"
 Date: * 09/13/04
 File Name: * PIP-10400

DRAWING PRINTERS
 Revision 0: revision 0
 Revision 1: revision 1

Non-approval of this plan is neither a warranty nor a responsibility. The approval of this plan is not a warranty or a responsibility. The approval of this plan is not a warranty or a responsibility.
 Approved By: _____
 Date Approved: _____

asi • moduLex.
 61119 Road, Appleton WI 54912
 920.836.9977 fax 920.836.9978
 www.asimodulex.com