



10'-0"

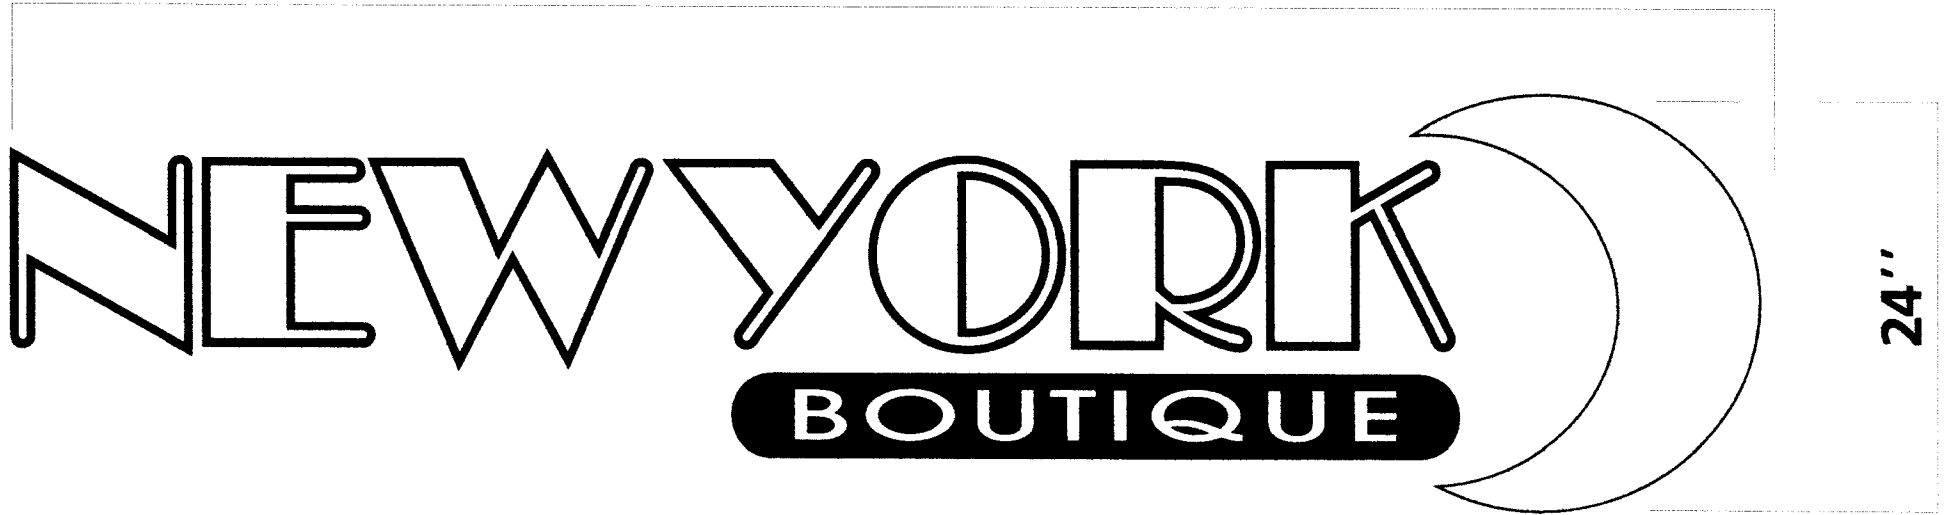

24"

RACEWAY MOUNTED CHANNEL LETTERS

Grand Central Plaza

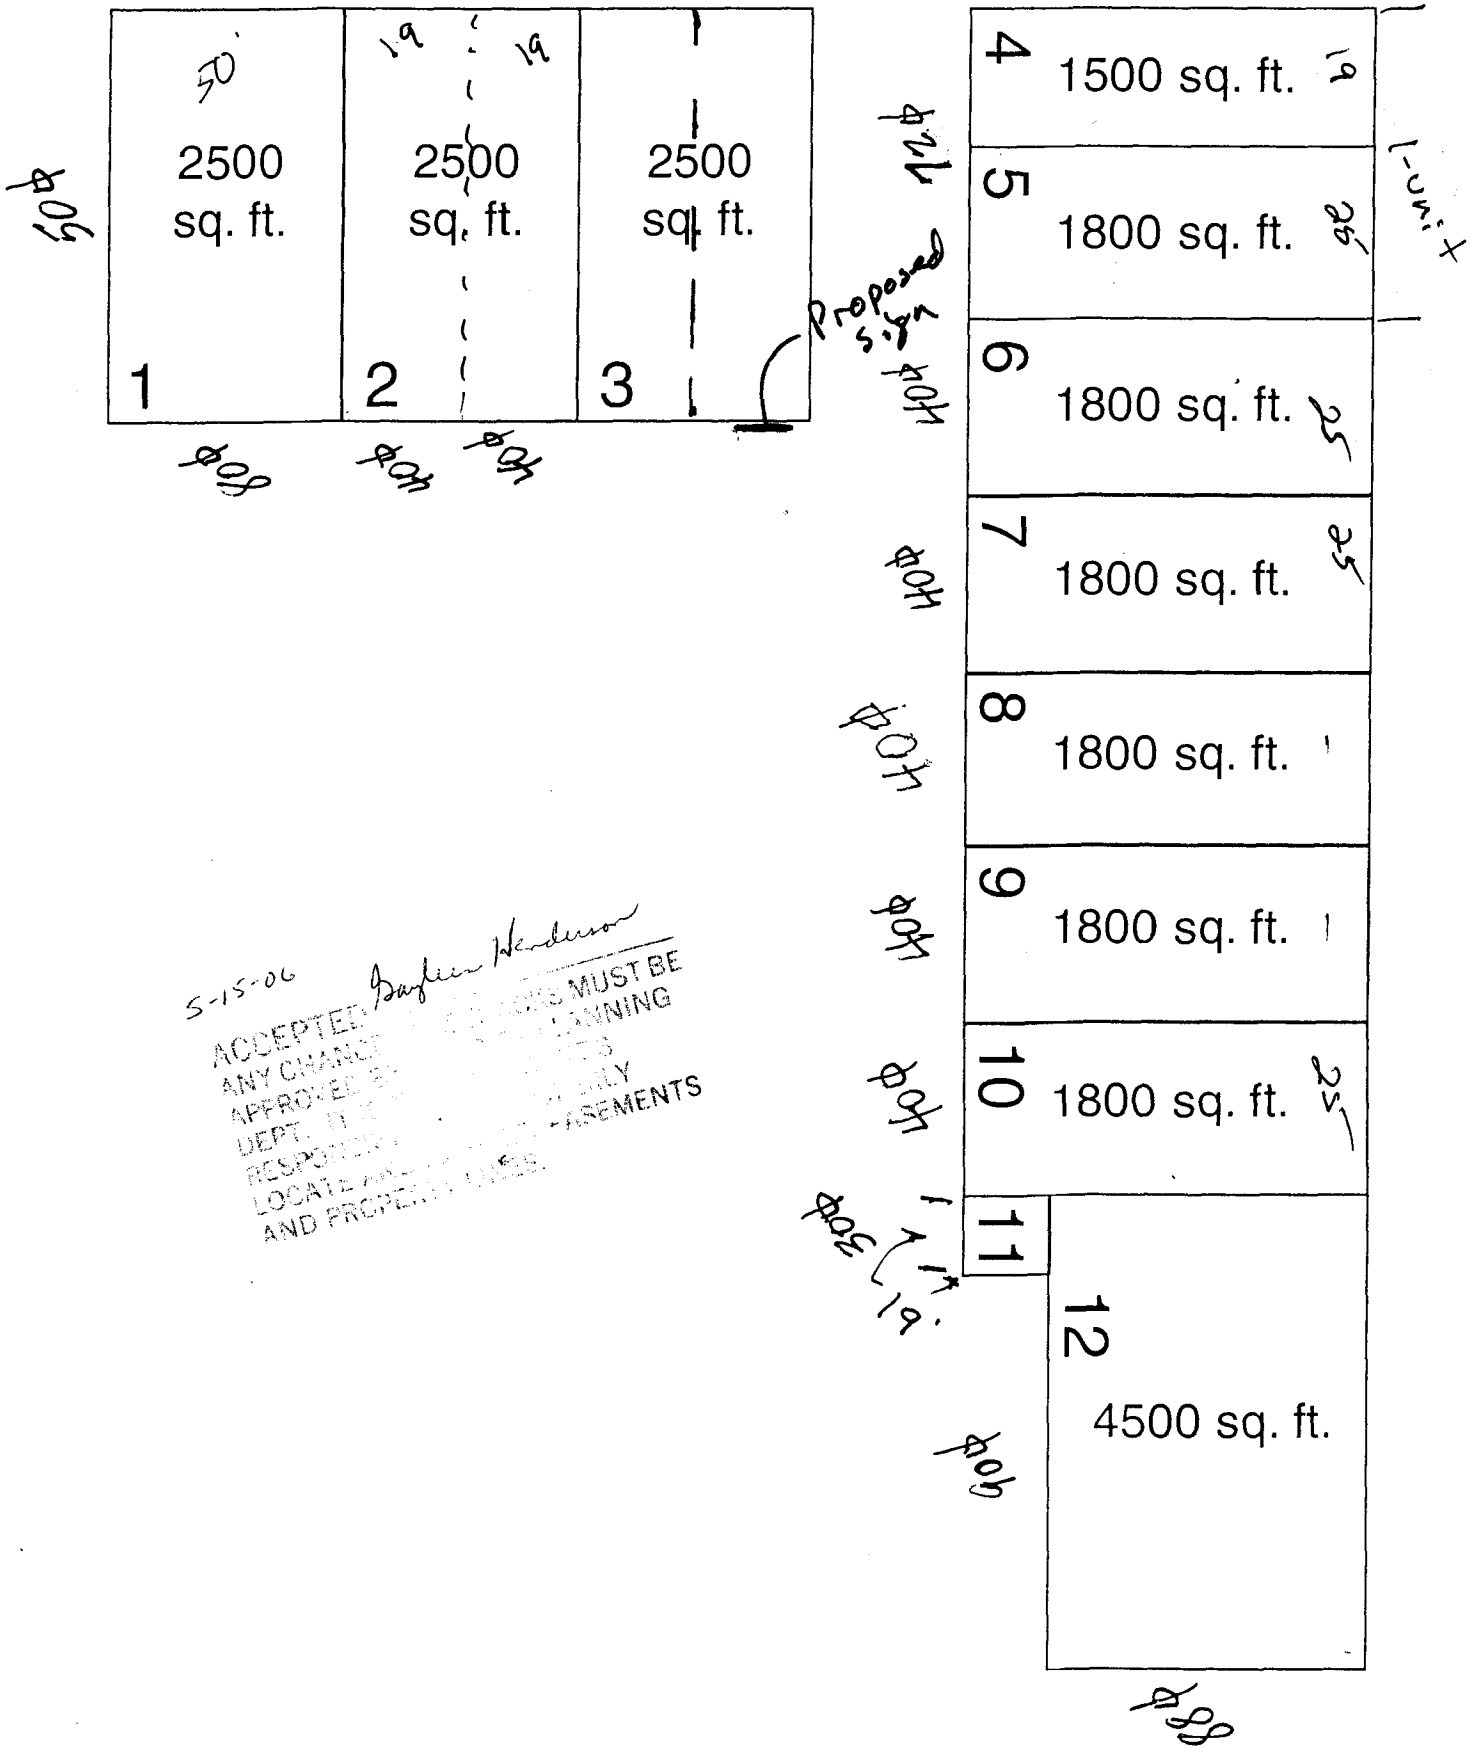

5-15-06
 ACCEPTED
 ANY CHANCE
 APPROVED BY
 DEPT. OF
 RESPONSIB
 LOCATE AND
 AND PROPERTY USES

Gayle Henderson

ALL WORKS MUST BE
 APPROVED BY THE PLANNING
 DEPT. IT IS THE RESPONSIBILITY
 OF THE APPLICANT TO OBTAIN ALL NECESSARY PERMITS AND EASEMENTS