



SIGN CLEARANCE

Community Development Department
250 North 5th Street
Grand Junction CO 81501
(970) 244-1430

Clearance No.	_____
Date Submitted	<u>3-2-06</u>
Fee \$	<u>25.00</u>
Zone	<u>C-1</u>

TAX SCHEDULE	<u>2945-141-02-018</u>	CONTRACTOR	<u>Sourdough Signs</u>
BUSINESS NAME	<u>Fidelity Mortgage</u>	LICENSE NO.	<u>2060666</u>
STREET ADDRESS	<u>700 Bedford Ave</u>	ADDRESS	<u>2223 H Rd</u>
PROPERTY OWNER	<u>Fmc Properties LLC</u>	TELEPHONE NO.	<u>243-1383</u>
OWNER ADDRESS	_____	CONTACT PERSON	<u>Sandy</u>

- | | | |
|-------------------------------------|------------------|---|
| <input type="checkbox"/> | 1. FLUSH WALL | 2 Square Feet per Linear Foot of Building Facade |
| <input type="checkbox"/> | 2. ROOF | 2 Square Feet per Linear Foot of Building Facade |
| <input checked="" type="checkbox"/> | 3. FREE-STANDING | 2 Traffic Lanes - 0.75 Square Feet x Street Frontage
4 or more Traffic Lanes - 1.5 Square Feet x Street Frontage |
| <input type="checkbox"/> | 4. PROJECTING | 0.5 Square Feet per each Linear Foot of Building Facade |
| <input type="checkbox"/> | 5. OFF-PREMISE | See #3 Spacing Requirements; Not > 300 Square Feet or < 15 Square Feet |

Externally Illuminated Internally Illuminated Non-Illuminated

(1 - 5) Area of Proposed Sign: 42 Square Feet

(1,2,4) Building Façade: ~~120~~ 125 Linear Feet Building Façade Direction: North South East West

(1 - 4) Street Frontage: ~~207~~ 125 Linear Feet Name of Street: 7th St.

(2 - 5) Height to Top of Sign: 6.5 Feet Clearance to Grade: 0 Feet Monument sign on concrete slab

(5) Distance from all Existing Off-Premise Signs within 600 Feet: _____ Feet

EXISTING SIGNAGE/TYPE & SQUARE FOOTAGE:	
_____	_____ Sq. Ft.
_____	_____ Sq. Ft.
_____	_____ Sq. Ft.
Total Existing:	_____ Sq. Ft.

FOR OFFICE USE ONLY	
Signage Allowed on Parcel for ROW:	
Building	<u>120</u> Sq. Ft.
Free-Standing	<u>187.50</u> Sq. Ft.
Total Allowed:	<u>187.50</u> Sq. Ft.

COMMENTS: (previous free standing sign permit issued was not built)


NOTE: No sign may exceed 300 square feet. A separate sign clearance is required for each sign. Attach a sketch, to scale, of proposed and existing signage including types, dimensions and lettering. Attach a plot plan, to scale, showing: abutting streets, alleys, easements, driveways, encroachments, property lines, distances from existing buildings to proposed signs and required setbacks. A SEPARATE PERMIT FROM THE BUILDING DEPARTMENT IS ALSO REQUIRED.


I hereby attest that the information on this form and the attached sketches are true and accurate.

Sandra M. Holladay 3/28/06 Dayleen Henderson 3-3-06
 Applicant's Signature Date Community Development Approval Date

(White: Community Development) (Canary: Applicant) (Pink: Building Dept) (Goldenrod: Code Enforcement)

FIDELITY MORTGAGE
700 BELFORD AVE.
2945-141-02-018

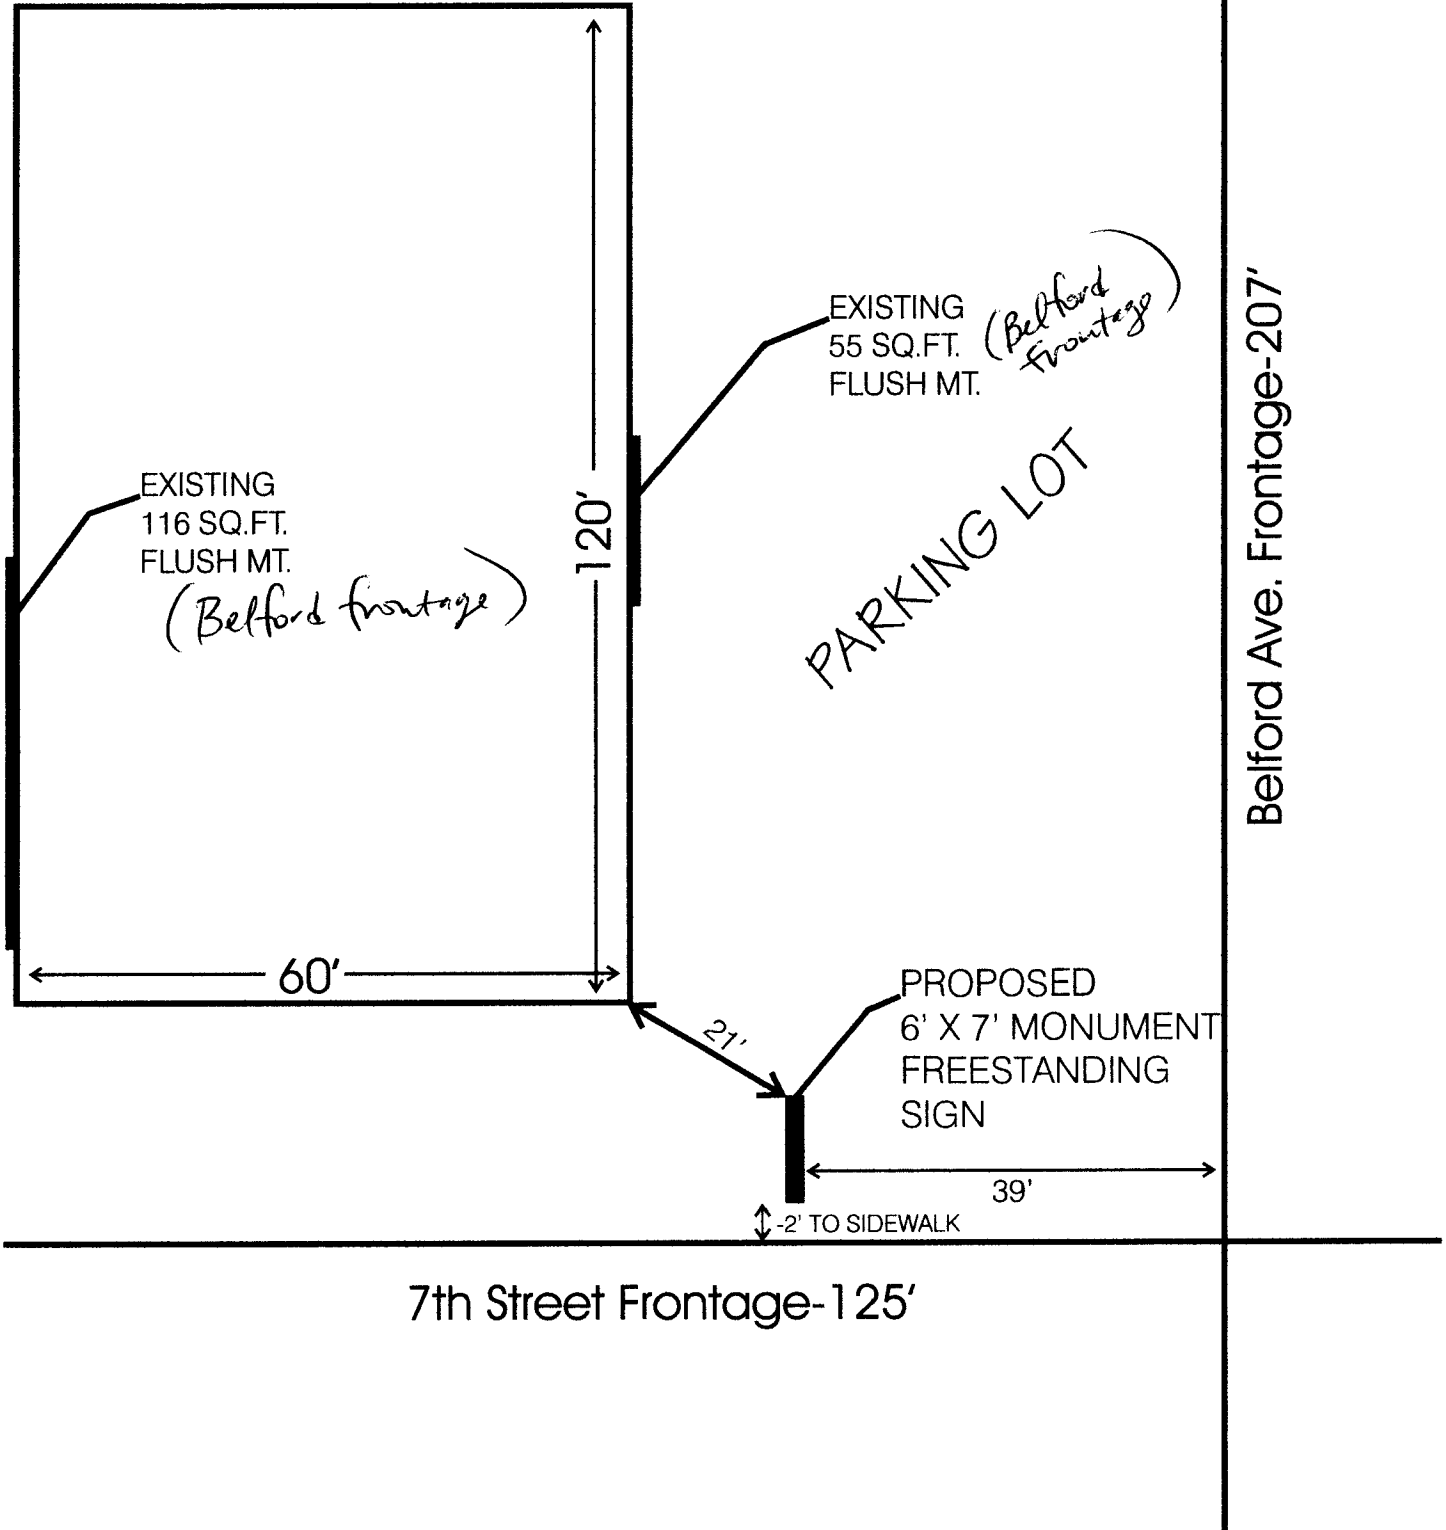

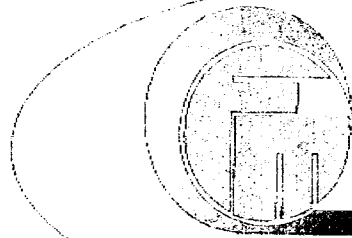

FIDELITY

MORTGAGE COMPANY



6' ↑
↓

700 Belford Avenue



← 7' →

