



Permit
SIGN CLEARANCE
Community Development Department
250 North 5th Street
Grand Junction CO 81501
(970) 244-1430

Sign B

Clearance No. _____
Date Submitted 10-3-06
Fee \$ 5.00
Zone I-1

TAX SCHEDULE <u>2697-362-04-001</u>	CONTRACTOR <u>Bud's Signs</u>
BUSINESS NAME <u>UPS</u>	LICENSE NO. <u>2060105</u>
STREET ADDRESS <u>777 2 1/2 Road</u>	ADDRESS <u>1055 Ute Ave.</u>
PROPERTY OWNER <u>SAME</u>	TELEPHONE NO. <u>245-7700</u>
OWNER ADDRESS <u>SAME</u>	CONTACT PERSON <u>TODD</u>

- | | |
|---|--|
| <input checked="" type="checkbox"/> 1. FLUSH WALL | 2 Square Feet per Linear Foot of Building Facade |
| <input type="checkbox"/> 2. ROOF | 2 Square Feet per Linear Foot of Building Facade |
| <input type="checkbox"/> 3. FREE-STANDING | 2 Traffic Lanes - 0.75 Square Feet x Street Frontage |
| | 4 or more Traffic Lanes - 1.5 Square Feet x Street Frontage |
| <input type="checkbox"/> 4. PROJECTING | 0.5 Square Feet per each Linear Foot of Building Facade |
| <input type="checkbox"/> 5. OFF-PREMISE | See #3 Spacing Requirements; Not > 300 Square Feet or < 15 Square Feet |

Externally Illuminated Internally Illuminated Non-Illuminated

(1 - 5) Area of Proposed Sign: 12 Square Feet

(1,2,4) Building Façade: ~~180~~ Linear Feet 200 Building Façade Direction: North South East West

(1 - 4) Street Frontage: ~~80~~ Linear Feet 385 Name of Street: _____

(2 - 5) Height to Top of Sign: 11 Feet Clearance to Grade: 8 Feet

(5) Distance from all Existing Off-Premise Signs within 600 Feet: _____ Feet

EXISTING SIGNAGE/TYPE & SQUARE FOOTAGE:

<u>Flushwall</u>	<u>13</u>	Sq. Ft.
_____	_____	Sq. Ft.
_____	_____	Sq. Ft.
Total Existing:	_____	Sq. Ft.

FOR OFFICE USE ONLY

Signage Allowed on Parcel for ROW:

Building	<u>400</u>	Sq. Ft.
Free-Standing	<u>288.75</u>	Sq. Ft.
Total Allowed:	<u>300</u>	Sq. Ft.


COMMENTS: _____

NOTE: No sign may exceed 300 square feet. A separate sign clearance is required for each sign. Attach a sketch, to scale, of proposed and existing signage including types, dimensions and lettering. Attach a plot plan, to scale, showing: abutting streets, alleys, easements, driveways, encroachments, property lines, distances from existing buildings to proposed signs and required setbacks. **A SEPARATE PERMIT FROM THE BUILDING DEPARTMENT IS ALSO REQUIRED.**


I hereby attest that the information on this form and the attached sketches are true and accurate.

<u>[Signature]</u>	<u>10/2/06</u>	<u>[Signature]</u>	<u>10-5-06</u>
Applicant's Signature	Date	Community Development Approval	Date

(White: Community Development) (Canary: Applicant) (Pink: Building Dept) (Goldenrod: Code Enforcement)

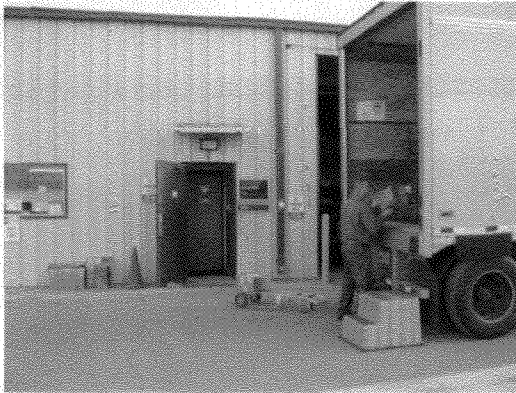

EXISTING BUILDING SIGNAGE
TO BE REMOVED
PER CORPORATE GUIDELINES

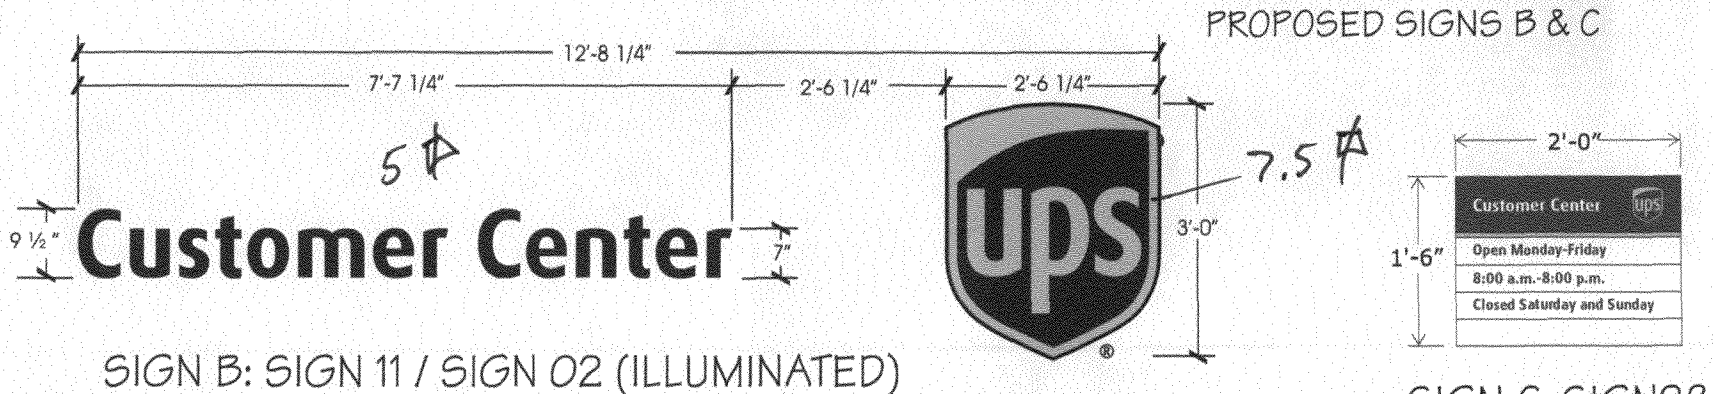

This is an original unpublished drawing created by Elro Signs. It is submitted for your personal use in conjunction with a project being planned for you. It is not to be shown to anyone outside your organization nor is it to be used, reproduced, copied or exhibited in any fashion without the express written consent of Elro Signs.



CALIFORNIA
400 West Walnut Street, Gardena, CA 90248
(800) 927-4555 • Fax (310) 380-7451

GEORGIA
2150 Boggs Road, Suite 350, Duluth, GA 30096
(877) 367-3576 • Fax (878) 475-6403

MARYLAND
1402 Ritchie-Marlboro Road, Suites E-8-10
Capitol Heights, MD 20743
(800) 218-5594 • Fax (301) 580-8889

TEXAS
103 Kirby Street, Garland, TX 75042
(800) 357-6170 • Fax (972) 205-9423

REVISIONS

NO.	COMMENTS	DATE
1	Change Sign E to a SIGN 17A	05-05-05

Client UPS / Grand Junction, CO / Rocky Mountain Dist.
Address 777 21 1/2 Road / Grand Junction, CO
Design No. 62173 Store No. _____
Drawn By: AB Date 04-29-05-C
Approved By: _____ Date _____