



## $S_{\text{IGN}}\,C_{\text{LEARANCE}}$

Community Development Department 250 North 5<sup>th</sup> Street Grand Junction CO 81501 (970) 244-1430

( <del>/ </del>
Clearance No.
Date Submitted 12/28/2006
Fee \$ 25.00
Zone <u>U-1</u>

PROPERTY OWNER COOK WILL DO OWNER ADDRESS 2320 W. C. COO	LICENSE NO ADDRESS _	D. 2049176 3770 Joliet St. Denuer 80239 ENO. 303-375-9933
[ ] 2. ROOF 2 [ ] 3. FREE-STANDING 2 [ ] 4. PROJECTING 0	Square Feet per Linear Foot of But Square Feet per Linear Foot of But Traffic Lanes - 0.75 Square Feet was or more Traffic Lanes - 1.5 Square Feet per each Linear Foot See #3 Spacing Requirements; Not the Square Feet per each Linear Foot See #3 Spacing Requirements; Not the Square Feet per each Linear Foot See #3 Spacing Requirements; Not the Square Feet per each Linear Foot See #3 Spacing Requirements; Not the Square Feet per each Linear Foot See #3 Spacing Requirements; Not the Square Feet per each Linear Foot Square Feet per each Linear Foot of But Park Poot	uilding Facade k Street Frontage e Feet x Street Frontage
[ ] Externally Illuminated [	Internally Illuminated	[ ] Non-Illuminated
(1-5) Area of Proposed Sign: SO (1,2,4) Building Façade: 297 Line (1-4) Street Frontage: 576 Linea (2-5) Height to Top of Sign: (5) Distance from all Existing Off-Pren	Building Façade Dir r Feet Name of Street:  Clearance to Grade:	Feet
EXISTING SIGNAGE/TYPE & SQUARE F	OOTAGE:	FOR OFFICE USE ONLY
$\mathcal{A}$	Sq. Ft.	Signage Allowed on Parcel for ROW:
	Sq. Ft.	2 x 297 Building
	Sq. Ft.	,75×576 Free-Standing 432 Sq. Ft.
Total Exist	R-	Total Allowed: 594 Sq. Ft.
COMMENTS:		
and existing signage including types, dimensio driveways, encroachments, property lines, dist PERMIT FROM THE BUILDING DEPAR	ns and lettering. Attach a plot plan cances from existing buildings to part to the transfer of	ed for each sign. Attach a sketch, to scale, of proposed to scale, showing: abutting streets, alleys, easements, roposed signs and required setbacks. A SEPARATE
I hereby attest that the information on this form		
	1 1	
Applicant's Signature	12/22/06 Judools	

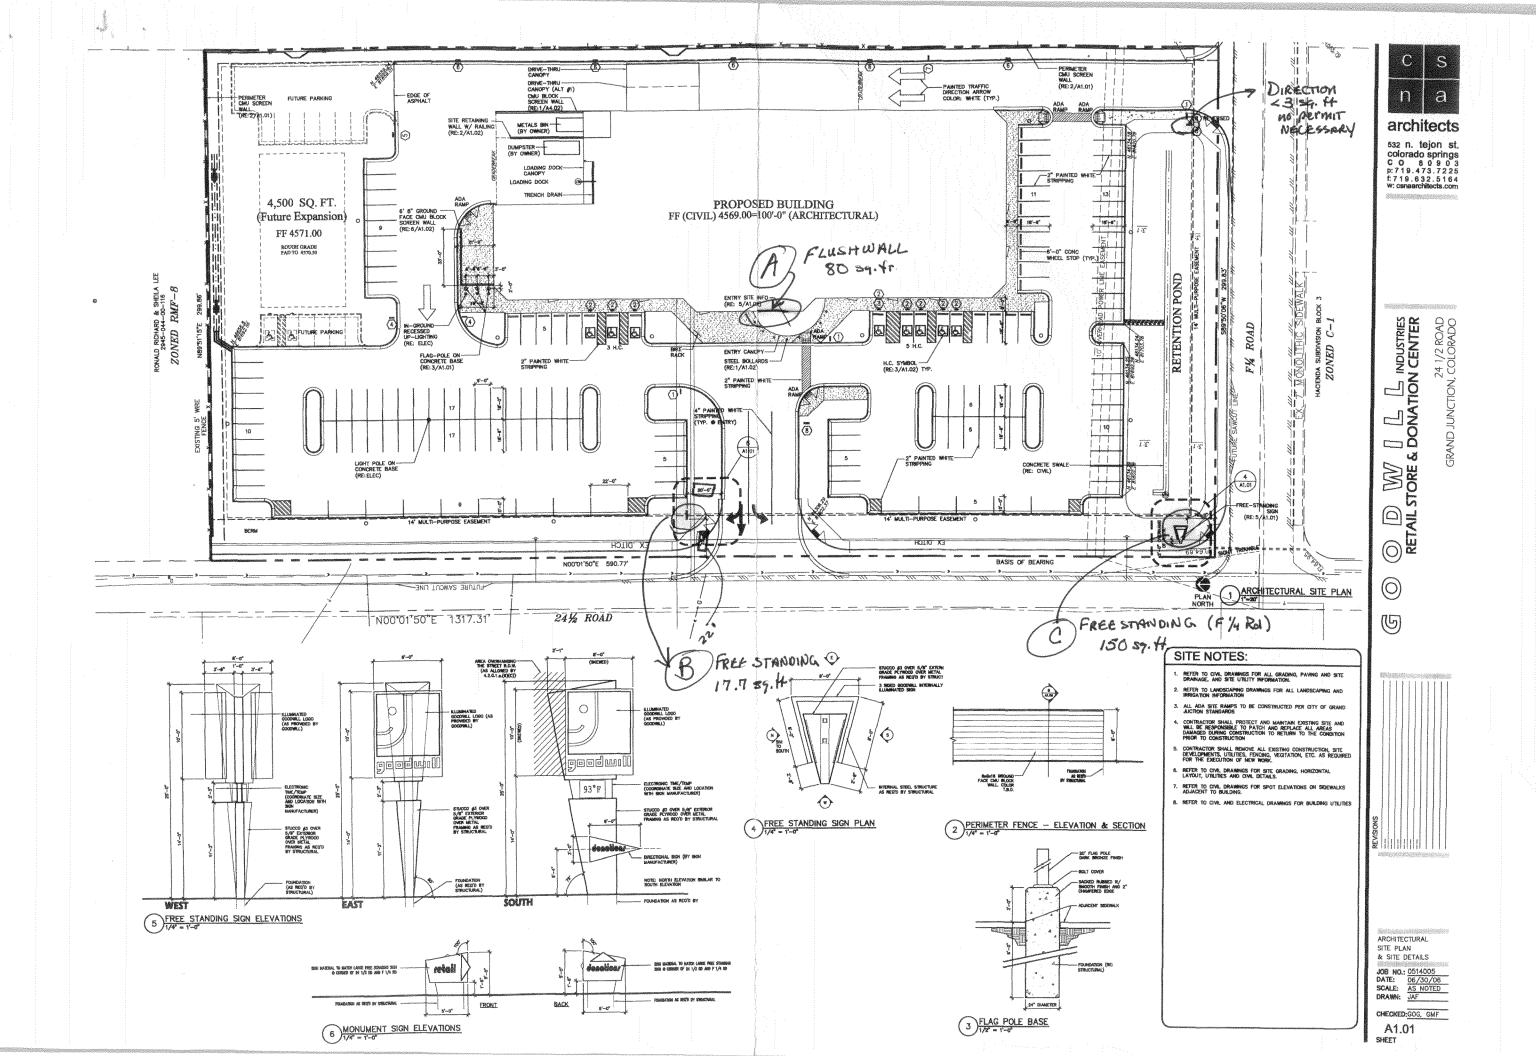

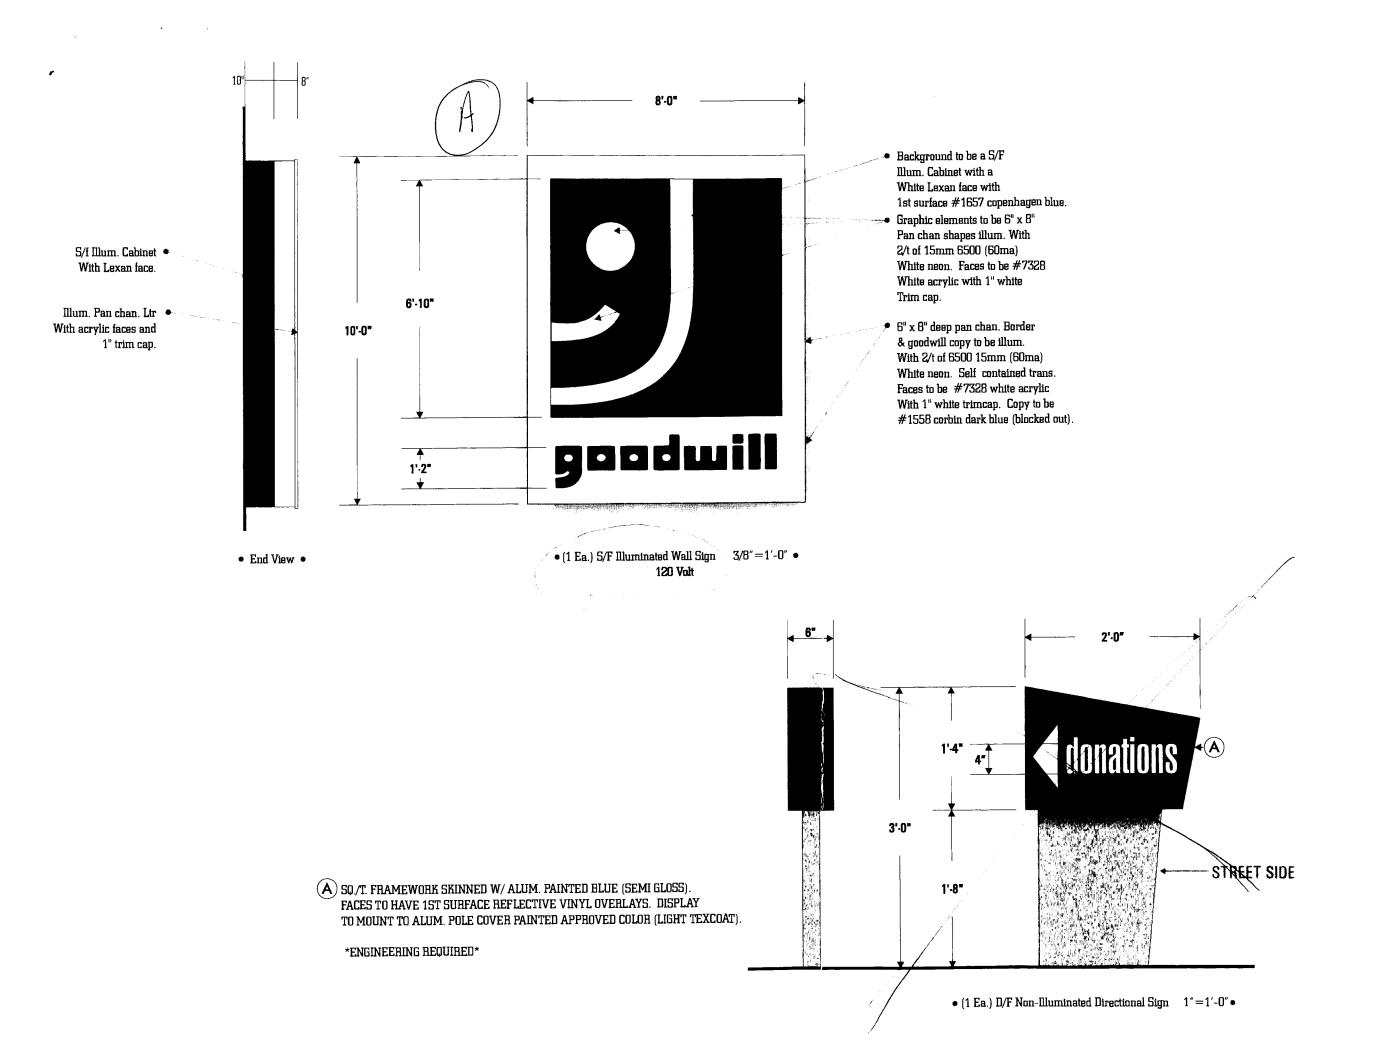



**Denver Division** 3770 Joliet Street Denver, CO 80239

Address:

303-375-9933 303-375-9111 (Fax) www.yesco.com




630 24 ½ ROAD
GRAND JUNCTION, COLDRADO
· · · · · · · · · · · · · · · · · · ·
Designer: CASEY EASTON
Color DICK D
Sales: RICK B.
Scale: NDTED
Date: 5.23.D6
Revisions:
-
<u>×</u>
<u>×</u>
Work Order #:
Trein wider N.

NOTE: UNLESS OTHERWISE NOTED, ELECTRICAL RUNS OR FINAL ELECTRICAL HOOKUP CHARGES ARE NOT INCLUDED. ILLUMINATED DISPLAYS WILL BE WIRED FOR 120 VOLT POWER UNLESS OTHERWISE INDICATED.

IF VOLTAGE IS NOT 120 PLEASE INDICATE YOUR VOLTAGE HERE.

OTHIS DRAWING WAS CREATED TO ASSIST YOU IN VISUALIZING OUR PROPOSAL THE ORIGINAL IDEAS HEREIN ARE THE PROPERTY OF YOUNG ELECTRIC SIGN COMPAIN. PERMISSION TO COPY OR REVISE TIMS DRAWING CAN ONLY BE OBTAINED THRU A WRITTEN ARREMENT WITN VESCO. SEE YOUR SALES REPRESENTATIVE OR CALL THE NEAREST OFFICE OF YOUNG ELECTRIC SIGN COMPANY.

DESIGN#: 06-413 R-4CR1

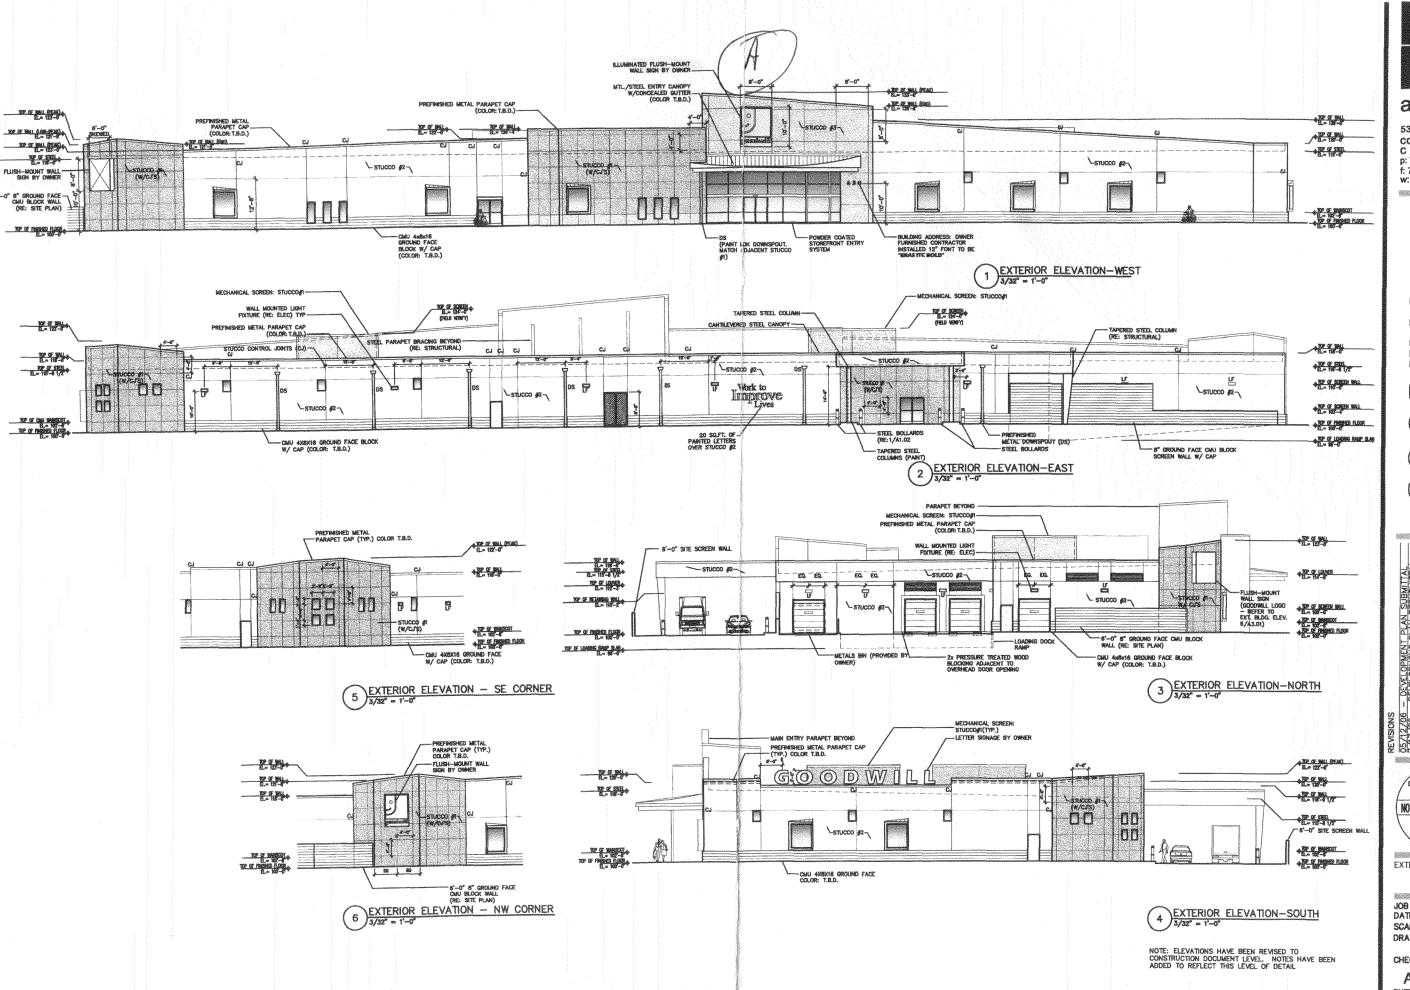

S а

## architects

532 n. tejon st. colorado springs C O 8 0 9 0 3 p:719.473.7225 f:719.632.5164 w: csnaarchitects.com

| | | | | | Industries Ø STORE . RETAIL S







EXTERIOR ELEVATIONS

JOB NO.: 0514005 DATE: 05/12/06 SCALE: AS NOTED DRAWN:

CHECKED:

A-2

SHEET




## SIGN CLEARANCE

Community Development Department 250 North 5<sup>th</sup> Street Grand Junction CO 81501 (970) 244-1430

Clearance No.
Date Submitted /2/26/2006
Fee \$ <u>5.00</u>
Zone C-I

STREET ADDRESS 630 24	I ralustries LICEN  2 Rose ADDR  industries TELER  Celosedo Ave CONT.	RACTOR LOUNG GEOMIC SIGN (O. SENO. 2041176) ESS 3770 JUNET STOPHER 80239 HONE NO. 303-35-9933 ACT PERSON ETICHOWN.
[ ] 1. FLUSH WALL [ ] 2. ROOF 3. FREE-STANDING [ ] 4. PROJECTING [ ] 5. OFF-PREMISE	0.5 Square Feet per each Line See #3 Spacing Requirements	t of Building Facade Feet x Street Frontage Square Feet x Street Frontage ear Foot of Building Facade s; Not > 300 Square Feet or < 15 Square Feet
[ ] Externally Illuminated	[X] Internally Illuminated	[ ] Non-Illuminated
(1-5) Area of Proposed Sign: 4 (1,2,4) Building Façade: 297 (1-4) Street Frontage: 516 (2-5) Height to Top of Sign: (5) Distance from all Existing Company (1)	Linear Feet Building Faça Linear Feet Name of Stre	et: 7 43 Rd Grade: _ <del>  1                                  </del>
EXISTING SIGNAGE/TYPE & SQU	IARE FOOTAGE:	FOR OFFICE USE ONLY
	2l. 02	
PLUSHWALL DOM	<u>80</u> Sq. F	Signage Allowed on Parcel for ROW:
	Sq. I	t. $2 \times 297$ Building $594$ Sq. Ft.
	Sq. F	t75 x 576 Free-Standing 432 Sq. Ft.
Tot	tal Existing: Sq. F	rad
COMMENTS:	97	
NOTE: No sign may exceed 300 square feet. A separate sign clearance is required for each sign. Attach a sketch, to scale, of proposed and existing signage including types, dimensions and lettering. Attach a plot plan, to scale, showing: abutting streets, alleys, easements, driveways, encroachments, property lines, distances from existing buildings to proposed signs and required setbacks. A SEPARATE PERMIT FROM THE BUILDING DEPARTMENT IS ALSO REQUIRED.  I hereby attest that the jaformation on this form and the attached sketches are true and accurate.		
THE	12/22/26 -	Tudorh D. VIC- 1/10/2007
Applicant's Signature	Date Com	munity Development Approval    1/10/2007   Date
(White: Community Development)	(Canary: Applicant) (Pink.	Building Dept) (Goldenrod: Code Enforcement)



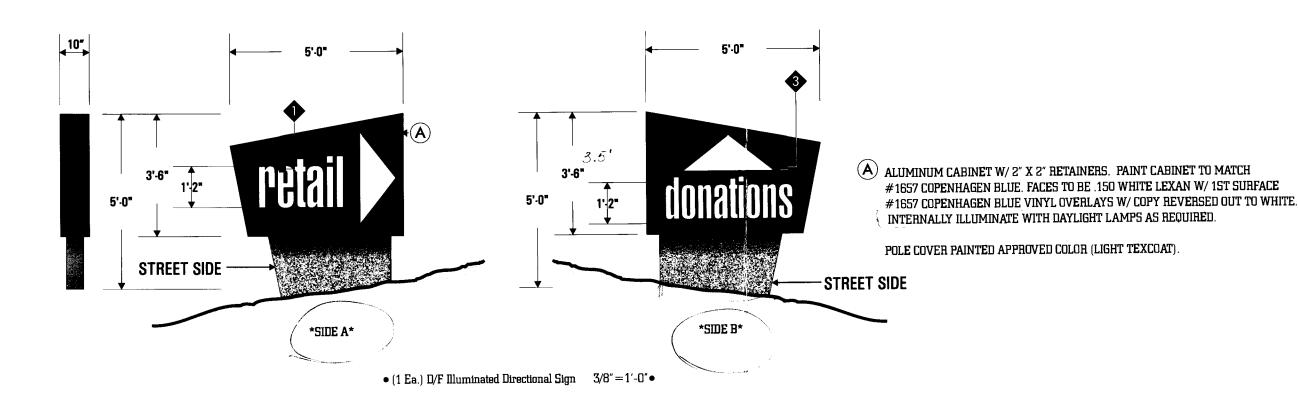



Denver Division 3770 Joliet Street Denver, CO 80239 303-375-9933 303-375-9111 (Fax) www.yesco.com



Address:		
630 24 ½ ROAD		
GRAND JUNCTI	ON, COLORADO	
Designer: CAS	EY EASTON	
Sales: RICK B.		
Scale: NOTED		
Date: 5.23.06		
Revisions:		
		-
-		
<u>×</u>		
	-	
×		
Work Order #:		
WIEGI W.		

NOTE: UNLESS OTHERWISE NOTED, ELECTRICAL RUNS OR FINAL ELECTRICAL HOOKUP CHARGES ARE NOT INCLUDED. ILLUMINATED DISPLAYS WILL BE WIRED FOR 120 VOLT POWER UNLESS OTHERWISE INDICATED.

F VOLTAGE IS NOT 120 PLEASE INDICATE YOUR VOLTAGE HERE.

OTHIS DRAWING WAS CREATED TO ASSIST YOU IN VISUALIZING OUR PROPOSAL THE ORIGINAL IDEAS HEREIN ARE THE PROPERTY OF YOUNG ELECTRIC SIGN COMPANY. PERMISSION TO COPY OR REVISE THIS DRAWING CAN ONLY BE OBTAINED THRU A WRITTEN AGREEMENT WITH YESCO. SEE YOUR SALES REPRESENTATIVE OR CALL THE MEAREST DIFFICE OF YOUNG ELECTRIC SIGN COMPANY.

DESIGN#: 06-413 R-4CR1

3

3




## SIGN CLEARANCE

Community Development Department 250 North 5<sup>th</sup> Street Grand Junction CO 81501 (970) 244-1430

Clear	ance No		
		12/26/2006	
Fee \$	5,00		
Zone	C-1		

TAX SCHEDULE 2945-04 BUSINESS NAME COOWING STREET ADDRESS 630 245 PROPERTY OWNER GOODWIN I OWNER ADDRESS 2320 W. (a)	ADDRES TELEPHO CONTAC	ENO. 2041176 S 2770 John St. Donner 80239 ONE NO. 303-375-9933 CT PERSON Fric Bown
[ ] 1. FLUSH WALL [ ] 2. ROOF	2 Square Feet per Linear Foot o 2 Square Feet per Linear Foot o 2 Traffic Lanes - 0.75 Square Foot 4 or more Traffic Lanes - 1.5 Sc 0.5 Square Feet per each Linear See #3 Spacing Requirements; I	f Building Facade eet x Street Frontage quare Feet x Street Frontage
[ ] Externally Illuminated	[X] Internally Illuminated	[ ] Non-Illuminated
(1-5) Area of Proposed Sign: H. (1,2,4) Building Façade: /// (1-4) Street Frontage: 576 (2-5) Height to Top of Sign: 2	Linear Feet Building Façade 300 Linear Feet Name of Street:	ade: F/4 KOAD
EXISTING SIGNAGE/TYPE & SQUA	RE FOOTAGE:	FOR OFFICE USE ONLY
A /	IKE POOTAGE.	FOR OFFICE USE ONE!
Juone	Sq. Ft.	Signage Allowed on Parcel for ROW:
	Sq. Ft.	3× //1 Building <u>222</u> Sq. Ft.
	Sq. Ft.	.76 x 300 Free-Standing 225 Sq. Ft.
Total	Existing: Sq. Ft.	Total Allowed: 225 Sq. Ft.
COMMENTS:		
and existing signage including types, din	nensions and lettering. Attach a plot es, distances from existing buildings EPARTMENT IS ALSO REQUIR	
The state of the s		
7/1	12/22/06 Jnd	unity Development Approval    1/10/2007   Date
Applicant's Signature	<b>Date</b> Comm	unity Development Approval ' Date

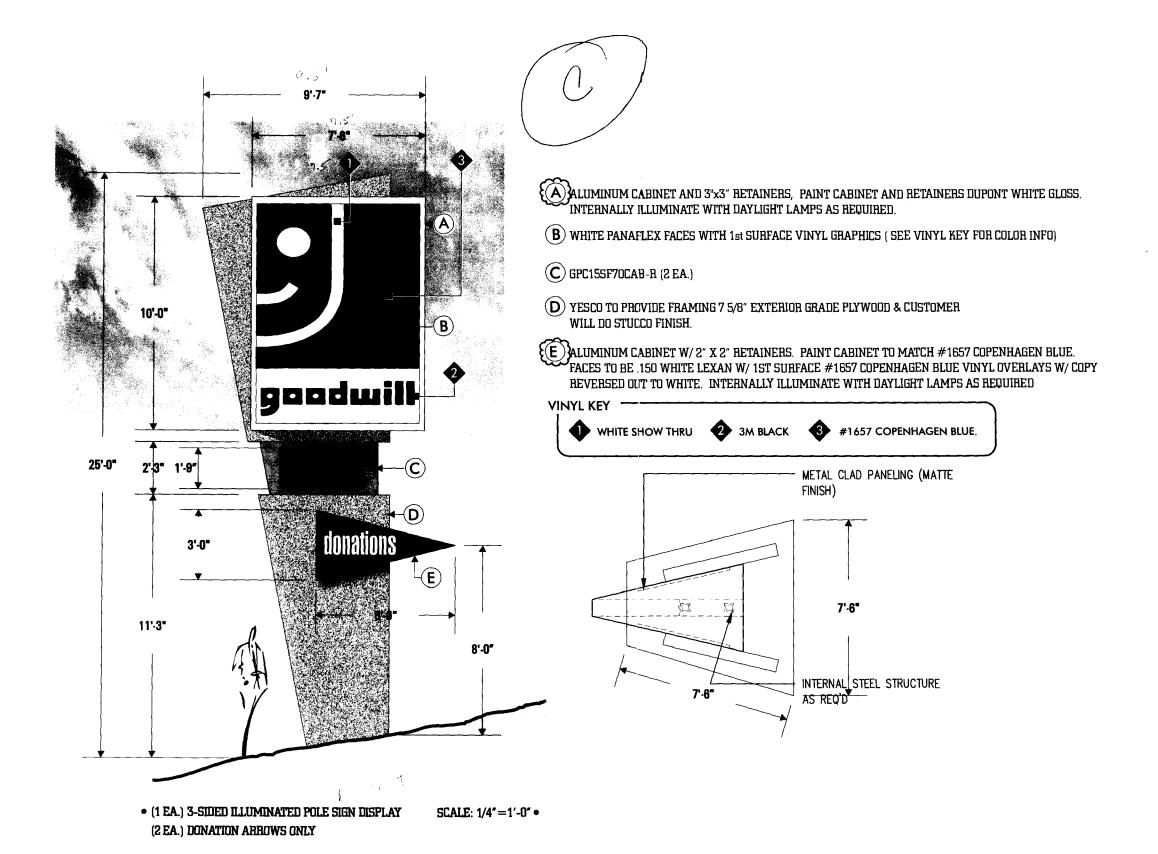



**Denver Division** 3770 Joliet Street Denver, CO 80239 303-375-9111 (Fax) www.yesco.com



Address:
630 24 ½ ROAD
GRAND JUNCTION, COLORADO
Designer: CASEY EASTON
Designer. CASET EASTON
Sales: RICK B.
Scale: NOTED
Date: 5.23.06
DECS. 3.23.00
Revisions:
nstisiulis.
<u>×</u>
x
Wark Order #:
NOTE: UNLESS OTHERWISE
NOTED, ELECTRICAL RUNS OR FINAL ELECTRICAL HOOKUP
CHARGES ARE NOT INCLUDED.

ILLUMINATED DISPLAYS WILL BE WIRED FOR 120 VOLT POWER UNLESS OTHERWISE INDICATED.

OTHIS DRAWING WAS CREATED TO ASSIST YOU IN VISUALIZING WHIS DRAWING WAS CREATED TO ASSIST YOU IN YISUALIZING OUR PROPOSAL THE ORIGINAL IDEAS REFER HAR THE PROPERTY OF YOUNG ELECTRIC SIGN COMPANY, PERMISSION TO COPY OR REVISE THIS DRAWING CAN ONLY BE ONTAINED THIN A NIWITTEN AGREEMENT WITH YESCO. SEE YOUR SALES REPRESENTATIVE OR CALL THE HEAREST OFFICE OF YOUNG ELECTRIC SIGN COMPANY.

DESIGN#: 06-413 R-4CR1