



Sign Permit

Community Development Department
250 North 5th Street
Grand Junction CO 81501
Phone: (970) 244-1430 FAX (970) 256-4031

Permit No.	_____
Date Submitted	<u>6-14-07</u>
Fee \$	<u>25.00</u>
Zone	<u>C-2</u>

TAX SCHEDULE	<u>2945-103-37-015</u>	CONTRACTOR	<u>Bud's Signs</u>
BUSINESS NAME	<u>Check into Cash</u>	LICENSE NO.	<u>2070171</u>
STREET ADDRESS	<u>2546 Rimrock Ave</u>	ADDRESS	<u>1055 Ute Ave.</u>
PROPERTY OWNER	_____	TELEPHONE NO.	<u>245-7700</u>
OWNER ADDRESS	_____	CONTACT PERSON	<u>TODD</u>

<input checked="" type="checkbox"/> 1. FLUSH WALL	2 Square Feet per Linear Foot of Building Façade
Face change only on items 2, 3 & 4	
<input type="checkbox"/> 2. ROOF	2 Square Feet per Linear Foot of Building Façade
<input type="checkbox"/> 3. PROJECTING	0.5 Square Feet per each Linear Foot of Building Façade
<input type="checkbox"/> 4. FREE-STANDING	2 Traffic Lanes - 0.75 Square Feet x Street Frontage 4 or more Traffic Lanes - 1.5 Square Feet x Street Frontage

Existing Externally or Internally Illuminated - No Change in Electrical Service Non-Illuminated

(1-4) Area of Proposed Sign:	<u>34.8</u> Square Feet	Building Façade Direction:	<u>North</u> South East West
(1-3) Building Façade:	<u>25</u> Linear Feet	Name of Street:	<u>Hwy 6 + 50</u>
(4) Street Frontage:	_____ Linear Feet	Clearance to Grade:	<u>15</u> Feet
(2-4) Height to Top of Sign:	<u>17</u> Feet		

EXISTING SIGNAGE/TYPE:	
_____	_____ Sq. Ft.
_____	_____ Sq. Ft.
_____	_____ Sq. Ft.
Total Existing:	_____ Sq. Ft.

FOR OFFICE USE ONLY	
Signage Allowed on Parcel:	<u>Hwy 6 + 50</u> <u>Rimrock Ave</u>
Building	<u>315</u> Sq. Ft.
Free-Standing	_____ Sq. Ft.
Total Allowed:	<u>315</u> Sq. Ft.

COMMENTS: ✓ Master Plan
1.75 \$ allowed per linear ft. of bldg facade

NOTE: No sign may exceed 300 square feet. A separate sign permit is required for each sign. Attach a sketch, to scale, of proposed and existing signage including types, dimensions and lettering. Attach a plot plan, to scale, showing: abutting streets, alleys, easements, driveways, encroachments, property lines, distances from existing buildings to proposed signs and required setbacks. Roof signs shall be manufactured such that no guy wires, braces or supports shall be visible.

I hereby attest that the information on this form and the attached sketches are true and accurate.

<u>Jocel Stocher</u>	<u>6/12/07</u>	<u>Bayleen Henderson</u>	<u>6-14-07</u>
Applicant's Signature	Date	Community Development Approval	Date

17' 4"


34.8 Sq. Ft.

24"

✓ \$ CHECK INTO CASH

CHANNELS on RACEWAY

REAR SIGN

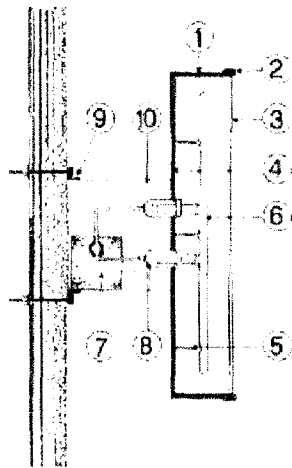

NOTES

1. 4 1/2" Deep .040 Aluminum Returns - Black
2. 1" Vinyl Trim Cap - Black
3. 1/8" Plexiglass Faces
 "Check Into" - # 2283 Red Plex Faces
 "Cash" - # 2447 White Plex w/ 3M # 3630-126
 Dark Emerald Green Vinyl
 "Check w/ \$" - White Plex w/
 3M # 3630-33 Red Vinyl
 3M # 3630-22 Black Vinyl
 (Space between \$ and Check to
 match fascia per site.)
4. .083 Aluminum Books
5. Standard Glass Supports
6. 13mm White Neon Tubing
7. 30MA Transformer in Metal Box
8. Glass Housings
9. 2" x 2" Right Angle Galvanized Steel Bracket
 With Stainless Steel Thru Bolts
10. 8" x 8" Deep Continuous .040 Aluminum
 Raceway To Match Fascia



LISTED UL APPROVED AND LISTED

Store #18034


34.8 Sq. Ft.

25'

17'4"


24"

14'

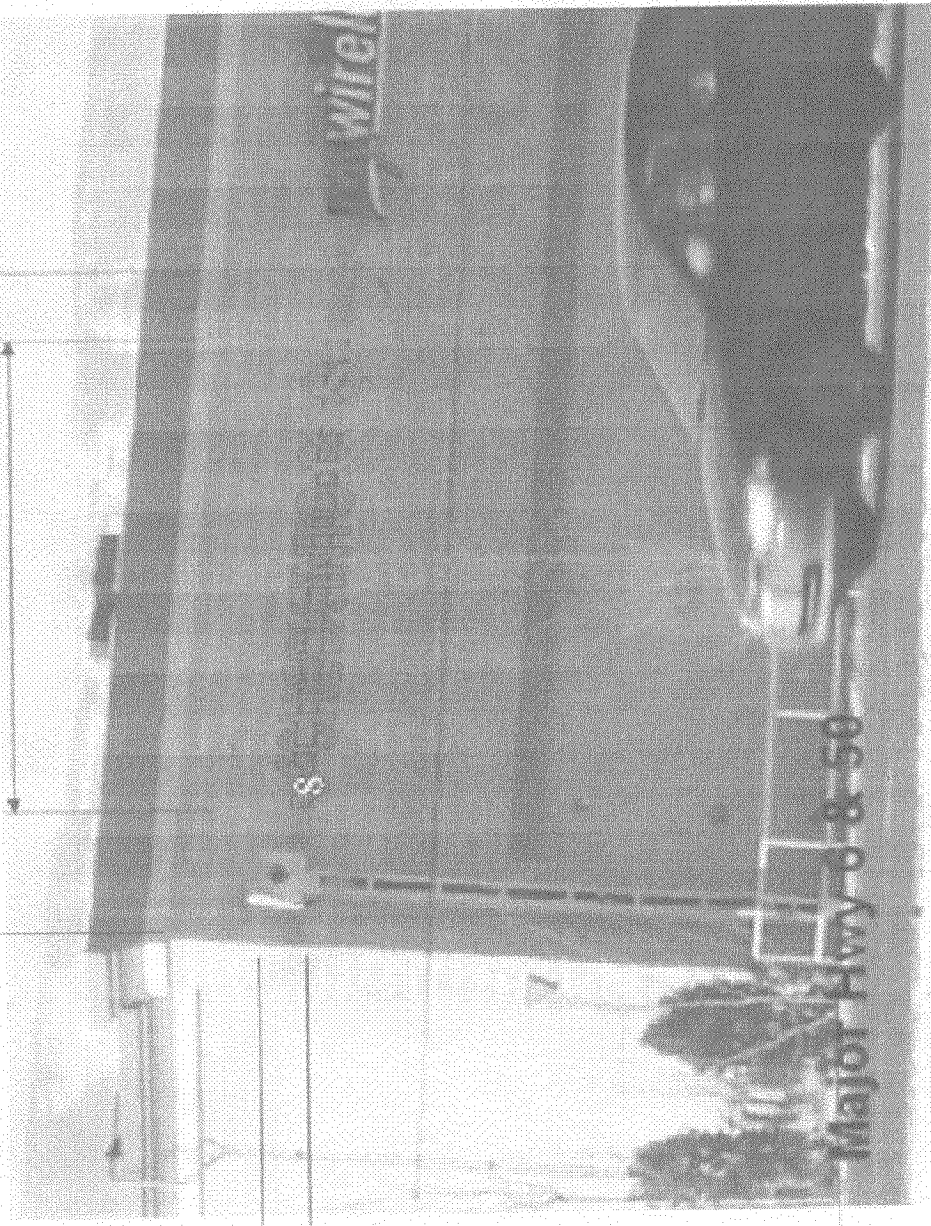

REAR ELEVATION

Store #18034

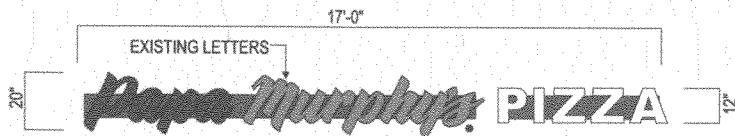


LETTER LAYOUT

SCALE: 3/16"=1'-0"

Illuminated channel letter wall signs - THREE size options

- Construction..... Aluminum - .040 returns and .063 backs.
- Return depth..... 5"
- Return color..... Black
- Trim cap..... 1" Black Jewelrite trim cap.
- Faces..... 3/16" acrylic.
- Illumination..... Neon tubing.
- PAPA colors..... #2157 Red face with Red LED illumination.
- MURPHY colors..... #2447 White acrylic w/ 1st surface 3630-27 Green vinyl overlays-with Green LED illumination
- Artwork..... As shown.
- Registered "R" disk..... #2447 White acrylic with green vinyl mount flat to wall - not illuminated.
- Electrical..... Remote install - verify access.

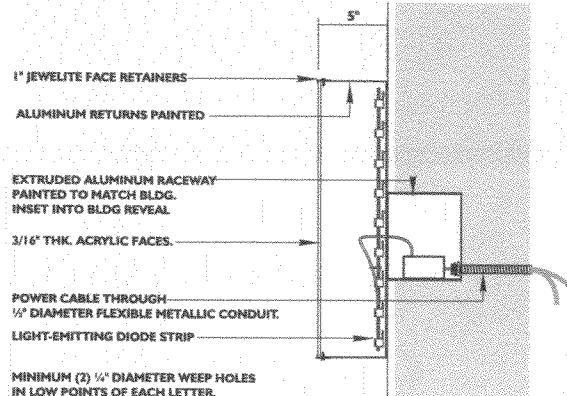

LETTER SECTION

1/4" = 1'-0"



PROPOSED ELEVATION

N.T.S.

FRONT

adART

SIGN COMPANY

2609 SAGEBRUSH DRIVE
SUITE 204
FLOWER MOUND, TEXAS 75028
T. 972.899.5660
F. 972.899.5663

Papa Murphy's
PIZZA

GRAND JUNCTION CO

PAGE 1 OF 1

SALES: Doug Head
DATE: 5/24/07
DESIGNER: TJV
FILENAME: 07-1118

Revision	Date	Description
R1/TJV/5-30-07/NEW LETTERS		

SALES APPROVAL


CUSTOMER APPROVAL

LANDLORD APPROVAL

CONCEPTUAL DRAWING ONLY
Dimensions are approximate & may change due to construction factors or exact field conditions. Colors Shown areas close as printing will allow always Follow written specifications.


ALL RIGHTS RESERVED
This design has been created for you in connection with a project being planned for you by ADART. It may not be shown to anyone outside your Organization, and may not be reproduced in any manner without prior consent.

BACK SAME FRONT

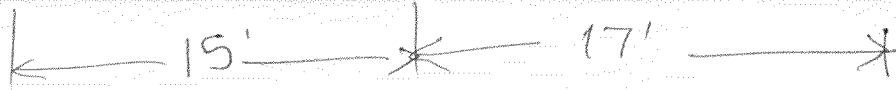



6 E 50

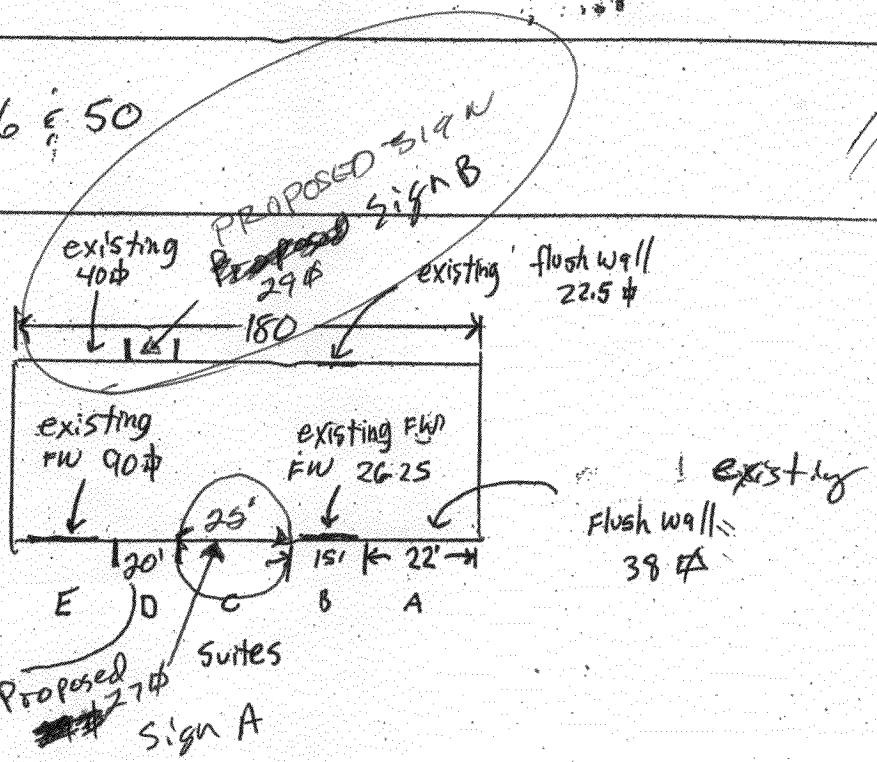

Rimrock