



Public Works and Planning Department
 250 North 5th Street, Grand Junction CO 81501
 Tel: (970) 244-1430 FAX (970) 256-4031

Sign Permit

For Signs that DO NOT Require
 a Building Permit

Date Submitted	<u>5-19-08</u>
Fee \$	25.00 <u>5.00</u>
Zone	<u>I-1</u>

TAX SCHEDULE NO. <u>2945-231-30-001</u>	CONTRACTOR <u>ANGEL SIGN CO</u>
BUSINESS NAME <u>FIRST STUDENT</u>	LICENSE NO. <u>2080077</u>
STREET ADDRESS <u>802 1ST AVE</u>	ADDRESS <u>590 N. WESTGATE</u>
PROPERTY OWNER <u>CARL SLAGLE</u>	TELEPHONE <u>244-8934</u>
OWNER ADDRESS <u>802 1ST AVE #D</u>	CONTACT PERSON <u>Daniel</u>

<input checked="" type="checkbox"/> 1. FLUSH WALL	2 Square Feet per Linear Foot of Building Façade
<input type="checkbox"/> 2. ROOF	2 Square Feet per Linear Foot of Building Façade
<input type="checkbox"/> 3. PROJECTING	0.5 Square Feet per each Linear Foot of Building Façade
<input type="checkbox"/> 4. FREE-STANDING	2 Traffic Lanes - 0.75 Square Feet x Street Frontage 4 or more Traffic Lanes - 1.5 Square Feet x Street Frontage

Existing Externally or Internally Illuminated – No Change in Electrical Service Non-Illuminated

(1-4) Area of Proposed Sign: <u>8</u> Square Feet	Building Façade Direction: North <u>South</u> East West
(1-3) Building Façade: <u>103'</u> Linear Feet	Name of Street: <u>1ST AVE</u>
(4) Street Frontage: <u>125' 14 1/4"</u> Linear Feet	Clearance to Grade: <u>11' 5 1/2"</u> Feet
(2-4) Height to Top of Sign: <u>13' 5 1/2"</u> Feet	


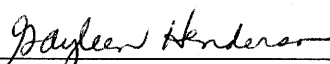
EXISTING SIGNAGE TYPE & SQUARE FOOTAGE:	
<u>FLUSH WALL MOUNT</u>	<u>8</u> Sq. Ft.
_____	_____ Sq. Ft.
_____	_____ Sq. Ft.
_____	_____ Sq. Ft.
Total Existing:	_____ Sq. Ft.

FOR OFFICE USE ONLY	
Signage Allowed on Parcel:	
Building	<u>206</u> Sq. Ft.
Free-Standing	<u>93.75</u> Sq. Ft.
Total Allowed:	<u>206</u> Sq. Ft.

COMMENTS: FACE CHANGE TO EXISTING SIGN

NOTE: No sign may exceed 300 square feet. A separate sign permit is required for each sign. Attach a sketch, to scale, of proposed and existing signage including types, dimensions and lettering. Attach a plot plan, to scale, showing: abutting streets, alleys, easements, driveways, encroachments, property lines, distances from existing buildings to proposed signs and required setbacks. Roof signs shall be manufactured such that no guy wires, braces or supports shall be visible.

I hereby attest that the information on this form and the attached sketches are true and accurate.

	<u>5-15-08</u>		<u>5-20-08</u>
Applicant's Signature	Date	Planning Approval	Date

8TH STREET


1ST AVE.

1ST AVE.

125' ~~141'4"~~

SIGN

103'

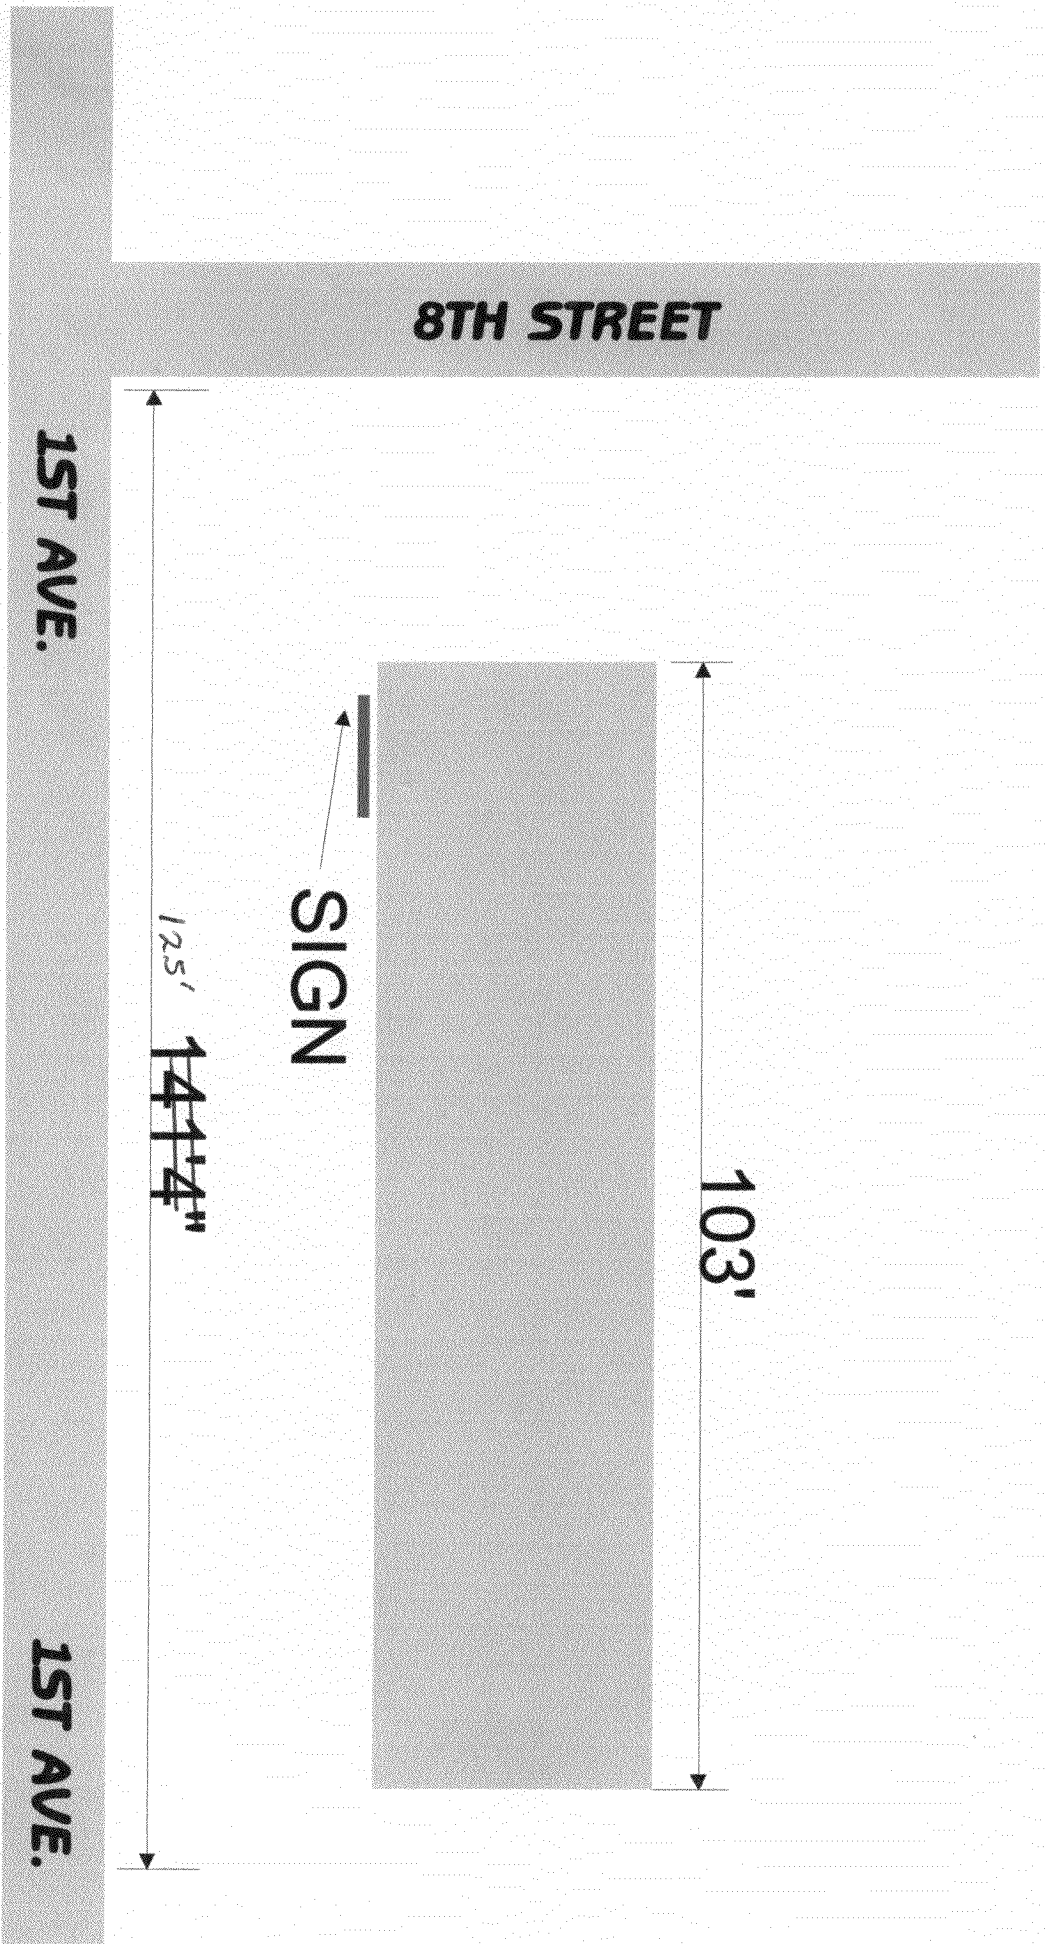

Vinyl Replacement Face - Grand Junction, CO



48" x 24"

Existing Elevation



Proposed Elevation



FASTSIGNS

120 West 7th Street, Cincinnati, OH 45202

1-888-758-3488

Fastsigns Catalog No.: Laidlaw

Rebrand Project

Scale: 10% of actual

Date: 2/15/08

Contact:

Location:

802 First Avenue

Grand Junction, CO 81501

Drawn by: ds Checked by: AS

Specifications:

(1) Plastic Flat Face with full color graphics - Please match PMS Colors to vinyl.

Frame: 30"x144"

Panel: 29-5/8"x143-5/8"

V.O.: 27-1/2"x141"

Production Notes:

.150 WHITE PIGMENTED plastic

PMS Rubine Red C/YC
(Avery A7 Blossom Opaque)

PMS 2758 C
(Graco 845 Cobalt Blue)

Please read carefully and check appropriate box:

- Sketch OK as is Sketch OK with changes
 New sketch required

Date _____ Signature _____

2007 Fastsigns 171 / All rights reserved. This drawing was created by Fastsigns 171, and contains exclusive design elements by Fastsigns 171 and may not be reproduced or utilized without consent from Fastsigns 171.