



Building B

THIS SPACE #400

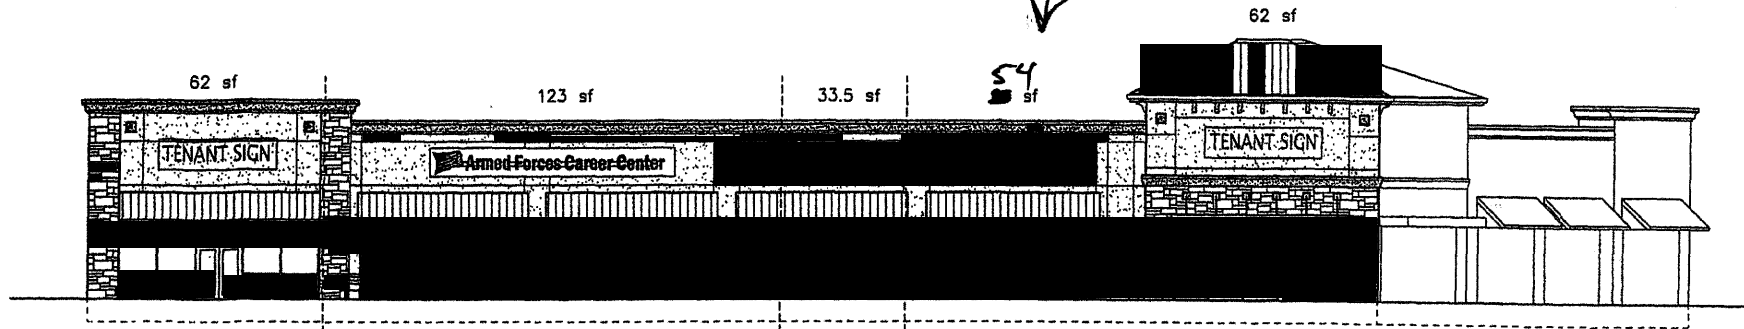

WEST ELEVATION

SCALE: 1/8"=1'-0"

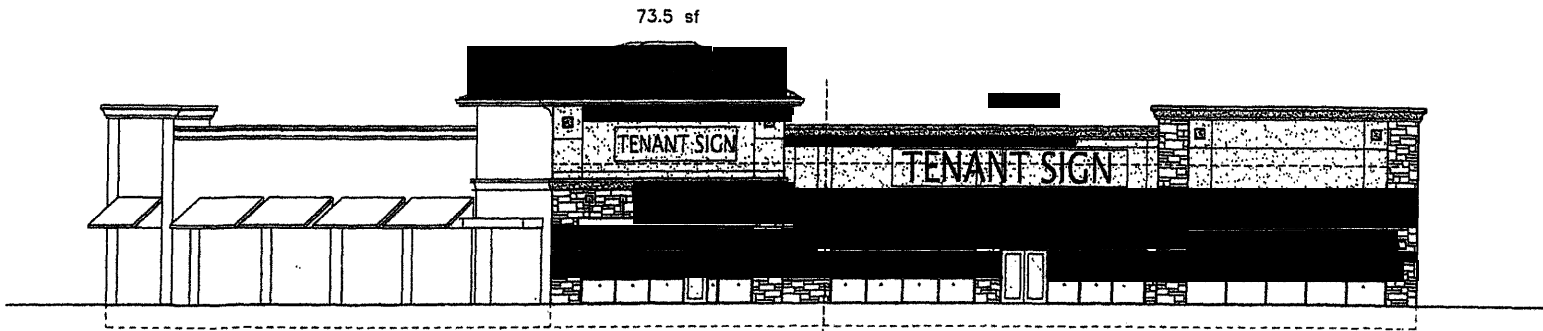

SOUTH ELEVATION

SCALE: 1/8"=1'-0"

14'-0"

Studio 25
a hair salon

3'-10"

ILLUMINATED CHANNEL LETTERS

54 Sq. Ft.

(55 Sq. Ft. Tenant Signage Allowed)

- INDIVIDUAL CHANNEL LETTERS
- REMOTE WIRED
- ILLUMINATED WITH L.E.D. MODULES
- WHITE FACES W/ DK. BROWN OVERLAYS
(BROWN BY DAY/WHITE BY NIGHT)
- 5" NATURAL BRUSHED ALUMINUM RETURNS
- 1" BRUSHED ALUMINUM CAP



DESIGN PROPERTY OF
Bud's
SIGNS
970-245-7700