

City  County

APPLICATION FOR THE PLANNING CLEARANCE FOR A BUILDING PERMIT

SUBMITTALS REQUIRED: (2) Plot Plans showing Parking, Landscaping, Setbacks to all property lines, and all streets which abut the parcel:

BLDG ADDRESS: 333 N. 1<sup>ST</sup> STREET

SQ FT OF BLDG: \_\_\_\_\_

SUBDIVISION: WILSON

SQ FT OF LOT: \_\_\_\_\_

FILING # \_\_\_\_\_ BLK # 2 LOT # \_\_\_\_\_

NUMBER OF FAMILY UNITS: \_\_\_\_\_

TAX SCHEDULE NUMBER: \_\_\_\_\_

NUMBER OF BUILDINGS ON PARCEL BEFORE THIS PLANNED CONSTRUCTION \_\_\_\_\_

2945-154-01-012 + 013

PROPERTY OWNER: GAY JOHNSON, INC

USE OF ALL EXISTING BUILDINGS: \_\_\_\_\_

ADDRESS: 333 N. 1<sup>ST</sup> STREET

Gen Staff Rest.

PHONE: 243-2421

DESCRIPTION OF WORK AND INTENDED USE:

INSTALL 8,000 - GALVAD U-G  
STEEL TANK W/A JOES

\*\*\*\*\*

FOR OFFICE USE ONLY

\*\*\*\*\*

ZONE: C-2

FLOOD PLAIN: YES  NO

SETBACKS: F 0 S 0 R 0

GEOLOGIC HAZARD: YES  NO

RIGHT OF WAY: \_\_\_\_\_

CENSUS TRACT NUMBER: 1

MAXIMUM HEIGHT: \_\_\_\_\_

SPECIAL CONDITIONS: \_\_\_\_\_

PARKING SPACES REQUIRED: \_\_\_\_\_

LANDSCAPING/SCREENING: \_\_\_\_\_

\*\*\*\*\*

ANY MODIFICATION TO THIS APPROVED PLANNING CLEARANCE MUST BE APPROVED IN WRITING BY THIS DEPARTMENT.

THE STRUCTURE APPROVED BY THIS APPLICATION CANNOT BE OCCUPIED UNTIL A CERTIFICATE OF OCCUPANCY (CO) IS ISSUED BY THE BUILDING DEPARTMENT (Section 307, Uniform Building Code).

ANY LANDSCAPING REQUIRED BY THIS PERMIT SHALL BE MAINTAINED IN AN ACCEPTABLE AND HEALTHY CONDITION. THE REPLACEMENT OF ANY VEGETATION MATERIALS THAT DIE OR ARE IN AN UNHEALTHY CONDITION SHALL BE REQUIRED.


I HEREBY ACKNOWLEDGE THAT I HAVE READ THIS APPLICATION AND THE ABOVE IS CORRECT AND I AGREE TO COMPLY WITH THE REQUIREMENTS ABOVE. FAILURE TO COMPLY SHALL RESULT IN LEGAL ACTION.

DATE APPROVED: 7/18/84

Bernie Perle  
SIGNATURE

APPROVED BY: [Signature]

Independent Pump  
242-5433

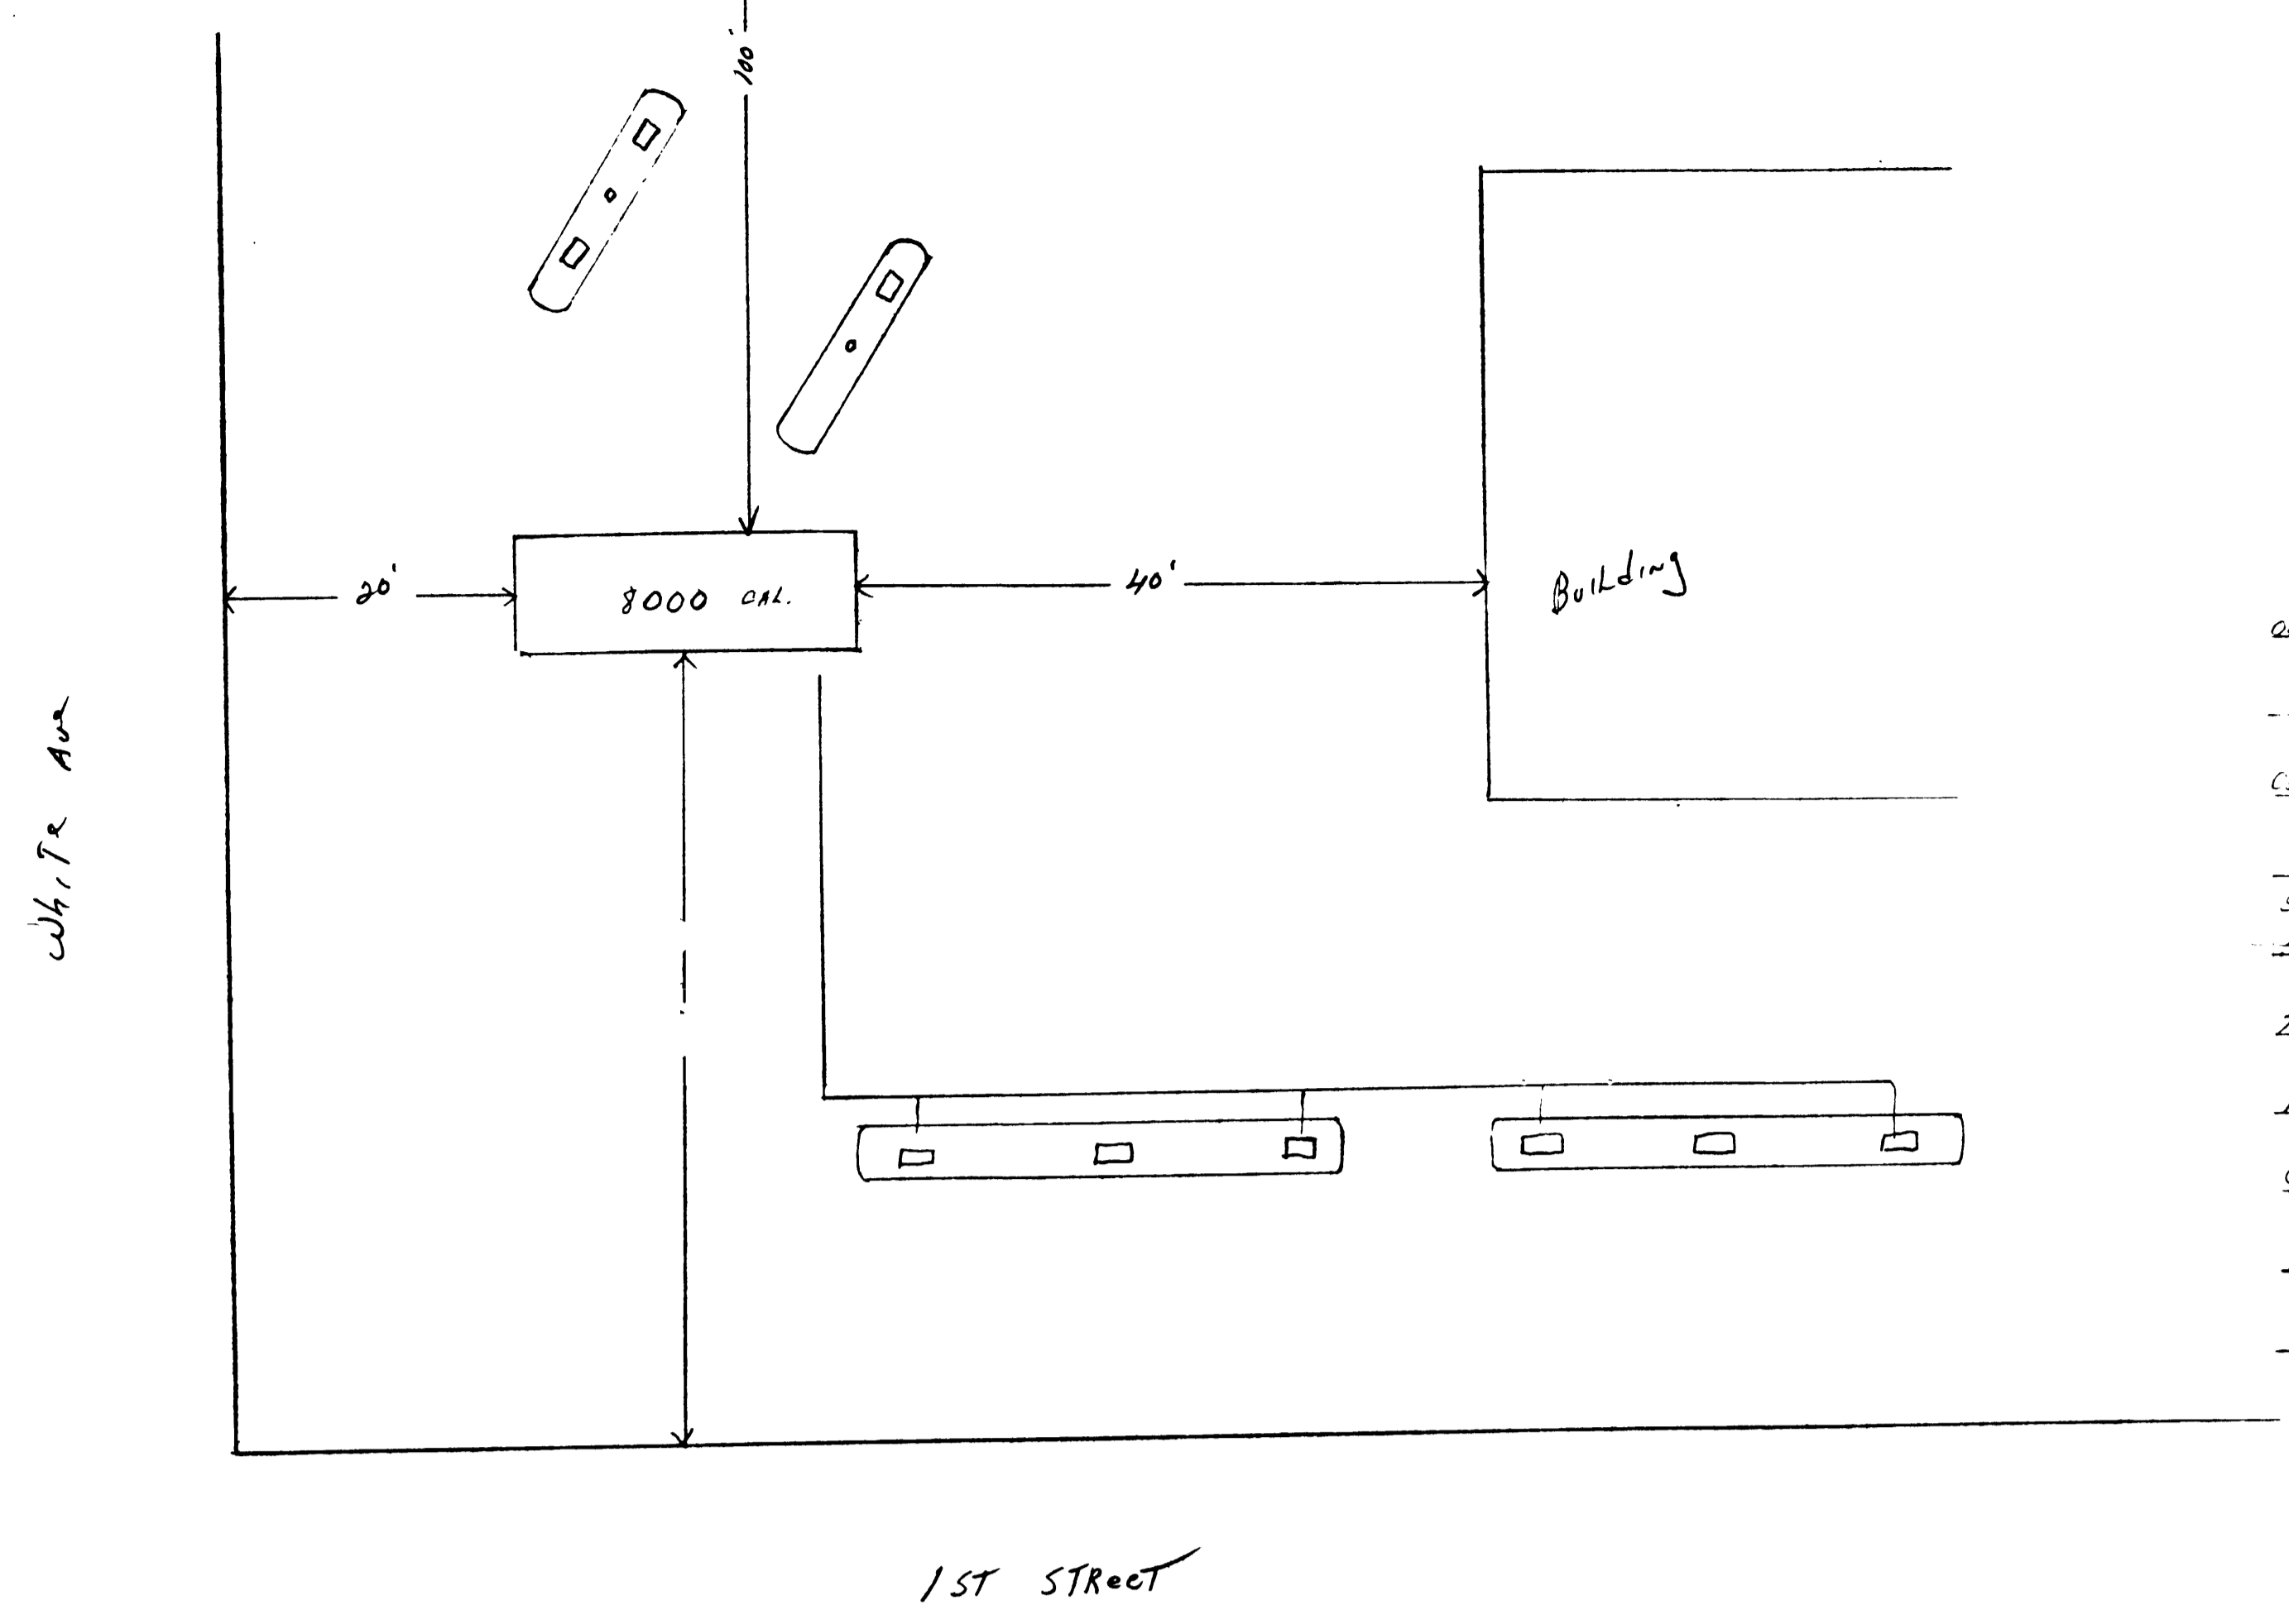

owned by Johnson Inc  
 933 N 1st Grand St side  
 Concrete Independent Pump Inc  
 148 3rd Ave Grand St side  
 install 9000 Gal. tank  
 To R/W & Ex. 1. 8000 Gal  
 TANK hook up to EXT  
 Copper Line. Cement  
 over tank. Analysis on TANK