

City County

PLAN # 20748

APPLICATION FOR THE PLANNING CLEARANCE FOR A BUILDING PERMIT

SUBMITTALS REQUIRED: (2) Plot Plans showing Parking, Landscaping, Setbacks to all property lines, and all streets which abut the parcel:

BLDG ADDRESS: 11 FORESIGHT CIRCLE

SQ FT OF BLDG: _____

SUBDIVISION: FORESIGHT PARK

SQ FT OF LOT: _____

FILING # _____ BLK # _____ LOT # _____

NUMBER OF FAMILY UNITS: —

TAX SCHEDULE NUMBER: _____

NUMBER OF BUILDINGS ON PARCEL BEFORE THIS PLANNED CONSTRUCTION

2945-03-16-030

ONE

PROPERTY OWNER: UNITED CABLE

USE OF ALL EXISTING BUILDINGS:

ADDRESS: 11 FORESIGHT CIRCLE

WHS & OFFICE

PHONE: _____

DESCRIPTION OF WORK AND INTENDED USE:

ADD 2 HANDICAPPED PARKING SPACES FOR INTERIOR REMODEL

FOR OFFICE USE ONLY

ZONE: _____

FLOOD PLAIN: YES NO

SETBACKS: F _____ S _____ R _____

GEOLOGIC HAZARD: YES NO

RIGHT OF WAY: _____

CENSUS TRACT NUMBER: # 10

MAXIMUM HEIGHT: _____

SPECIAL CONDITIONS: _____

PARKING SPACES REQUIRED: _____

LANDSCAPING/SCREENING: _____

As Per Approved Plan

ANY MODIFICATION TO THIS APPROVED PLANNING CLEARANCE MUST BE APPROVED IN WRITING BY THIS DEPARTMENT.

THE STRUCTURE APPROVED BY THIS APPLICATION CANNOT BE OCCUPIED UNTIL A CERTIFICATE OF OCCUPANCY (CO) IS ISSUED BY THE BUILDING DEPARTMENT (Section 307, Uniform Building Code).

ANY LANDSCAPING REQUIRED BY THIS PERMIT SHALL BE MAINTAINED IN AN ACCEPTABLE AND HEALTHY CONDITION. THE REPLACEMENT OF ANY VEGETATION MATERIALS THAT DIE OR ARE IN AN UNHEALTHY CONDITION SHALL BE REQUIRED.

I HEREBY ACKNOWLEDGE THAT I HAVE READ THIS APPLICATION AND THE ABOVE IS CORRECT AND I AGREE TO COMPLY WITH THE REQUIREMENTS ABOVE. FAILURE TO COMPLY SHALL RESULT IN LEGAL ACTION.

J. D. Wilby
SIGNATURE

DATE APPROVED: 4/27/84


APPROVED BY: *BCG*

ALL ELECTRICAL WORK SHALL
DONE ACCORDING TO CLASS
DIV 1 & 2 HAZARDOUS LOCA

PP-13, 15
(SWITCHED NEUTRAL)
(3# 12) 3/4"
20A2P CB

UNDERGROUND

LP-8 VIA
TIME CLOCK
(2# 12)

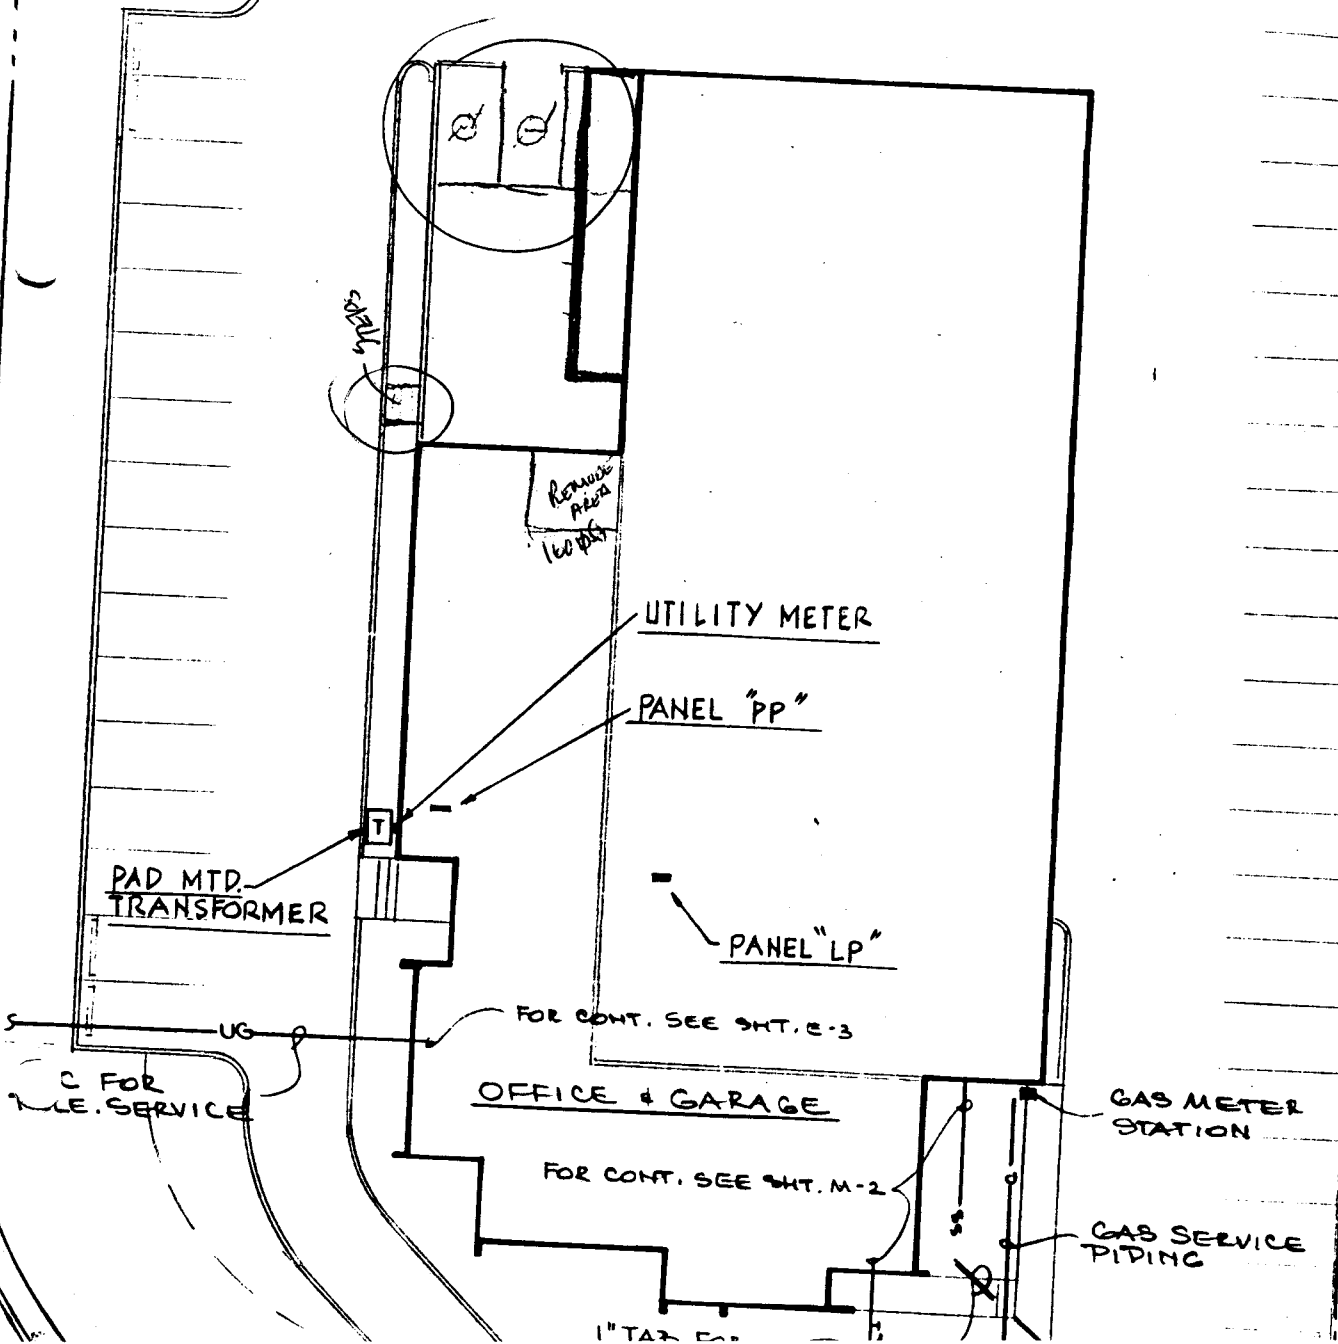

PAD MTD.
TRANSFORMER

UTILITY METER

PANEL "PP"

PANEL "LP"

FOR CONT. SEE SHT. E-3

OFFICE & GARAGE

FOR CONT. SEE SHT. M-2

GAS METER
STATION

GAS SERVICE
PIPING

1" TAP

C FOR
N.E. SERVICE

UG

SHIELD

Reverse
Pump
100 PSI