

APPLICATION FOR THE PLANNING CLEARANCE FOR A BUILDING PERMIT

SUBMITTALS REQUIRED: (2) Plot Plans showing Parking, Landscaping, Setbacks to all property lines, and all streets which abut the parcel:

BLDG ADDRESS: 2857 Bunting Ave.

SQ FT OF BLDG: _____

SUBDIVISION: Hutt

SQ FT OF LOT: _____

FILING # _____ BLK # _____ LOT # 22

NUMBER OF FAMILY UNITS: 1

TAX SCHEDULE NUMBER: West half 23

NUMBER OF BUILDINGS ON PARCEL BEFORE THIS PLANNED CONSTRUCTION _____

2943-074-14-008

PROPERTY OWNER: Thomas E. Verdick

USE OF ALL EXISTING BUILDINGS: _____

ADDRESS: 2857 Bunting Avenue

PHONE: 245-5725 or 245-5337

Res.

DESCRIPTION OF WORK AND INTENDED USE:

Close in back porch to make into an office

FOR OFFICE USE ONLY

ZONE: RSP 8

FLOOD PLAIN: YES NO

SETBACKS: F 20 S 5/5 R 15

GEOLOGIC HAZARD: YES NO

RIGHT OF WAY: Existing

CENSUS TRACT NUMBER: 6

MAXIMUM HEIGHT: _____

SPECIAL CONDITIONS: TZ 30

PARKING SPACES REQUIRED: _____

As per home occupation registration #1114

LANDSCAPING/SCREENING: _____

ANY MODIFICATION TO THIS APPROVED PLANNING CLEARANCE MUST BE APPROVED IN WRITING BY THIS DEPARTMENT.

THE STRUCTURE APPROVED BY THIS APPLICATION CANNOT BE OCCUPIED UNTIL A CERTIFICATE OF OCCUPANCY (CO) IS ISSUED BY THE BUILDING DEPARTMENT (Section 307, Uniform Building Code).


ANY LANDSCAPING REQUIRED BY THIS PERMIT SHALL BE MAINTAINED IN AN ACCEPTABLE AND HEALTHY CONDITION. THE REPLACEMENT OF ANY VEGETATION MATERIALS THAT DIE OR ARE IN AN UNHEALTHY CONDITION SHALL BE REQUIRED.

I HEREBY ACKNOWLEDGE THAT I HAVE READ THIS APPLICATION AND THE ABOVE IS CORRECT AND I AGREE TO COMPLY WITH THE REQUIREMENTS ABOVE. FAILURE TO COMPLY SHALL RESULT IN LEGAL ACTION.

DATE APPROVED: 7/30/85

Sheryl W. Verdick
SIGNATURE

APPROVED BY: Don

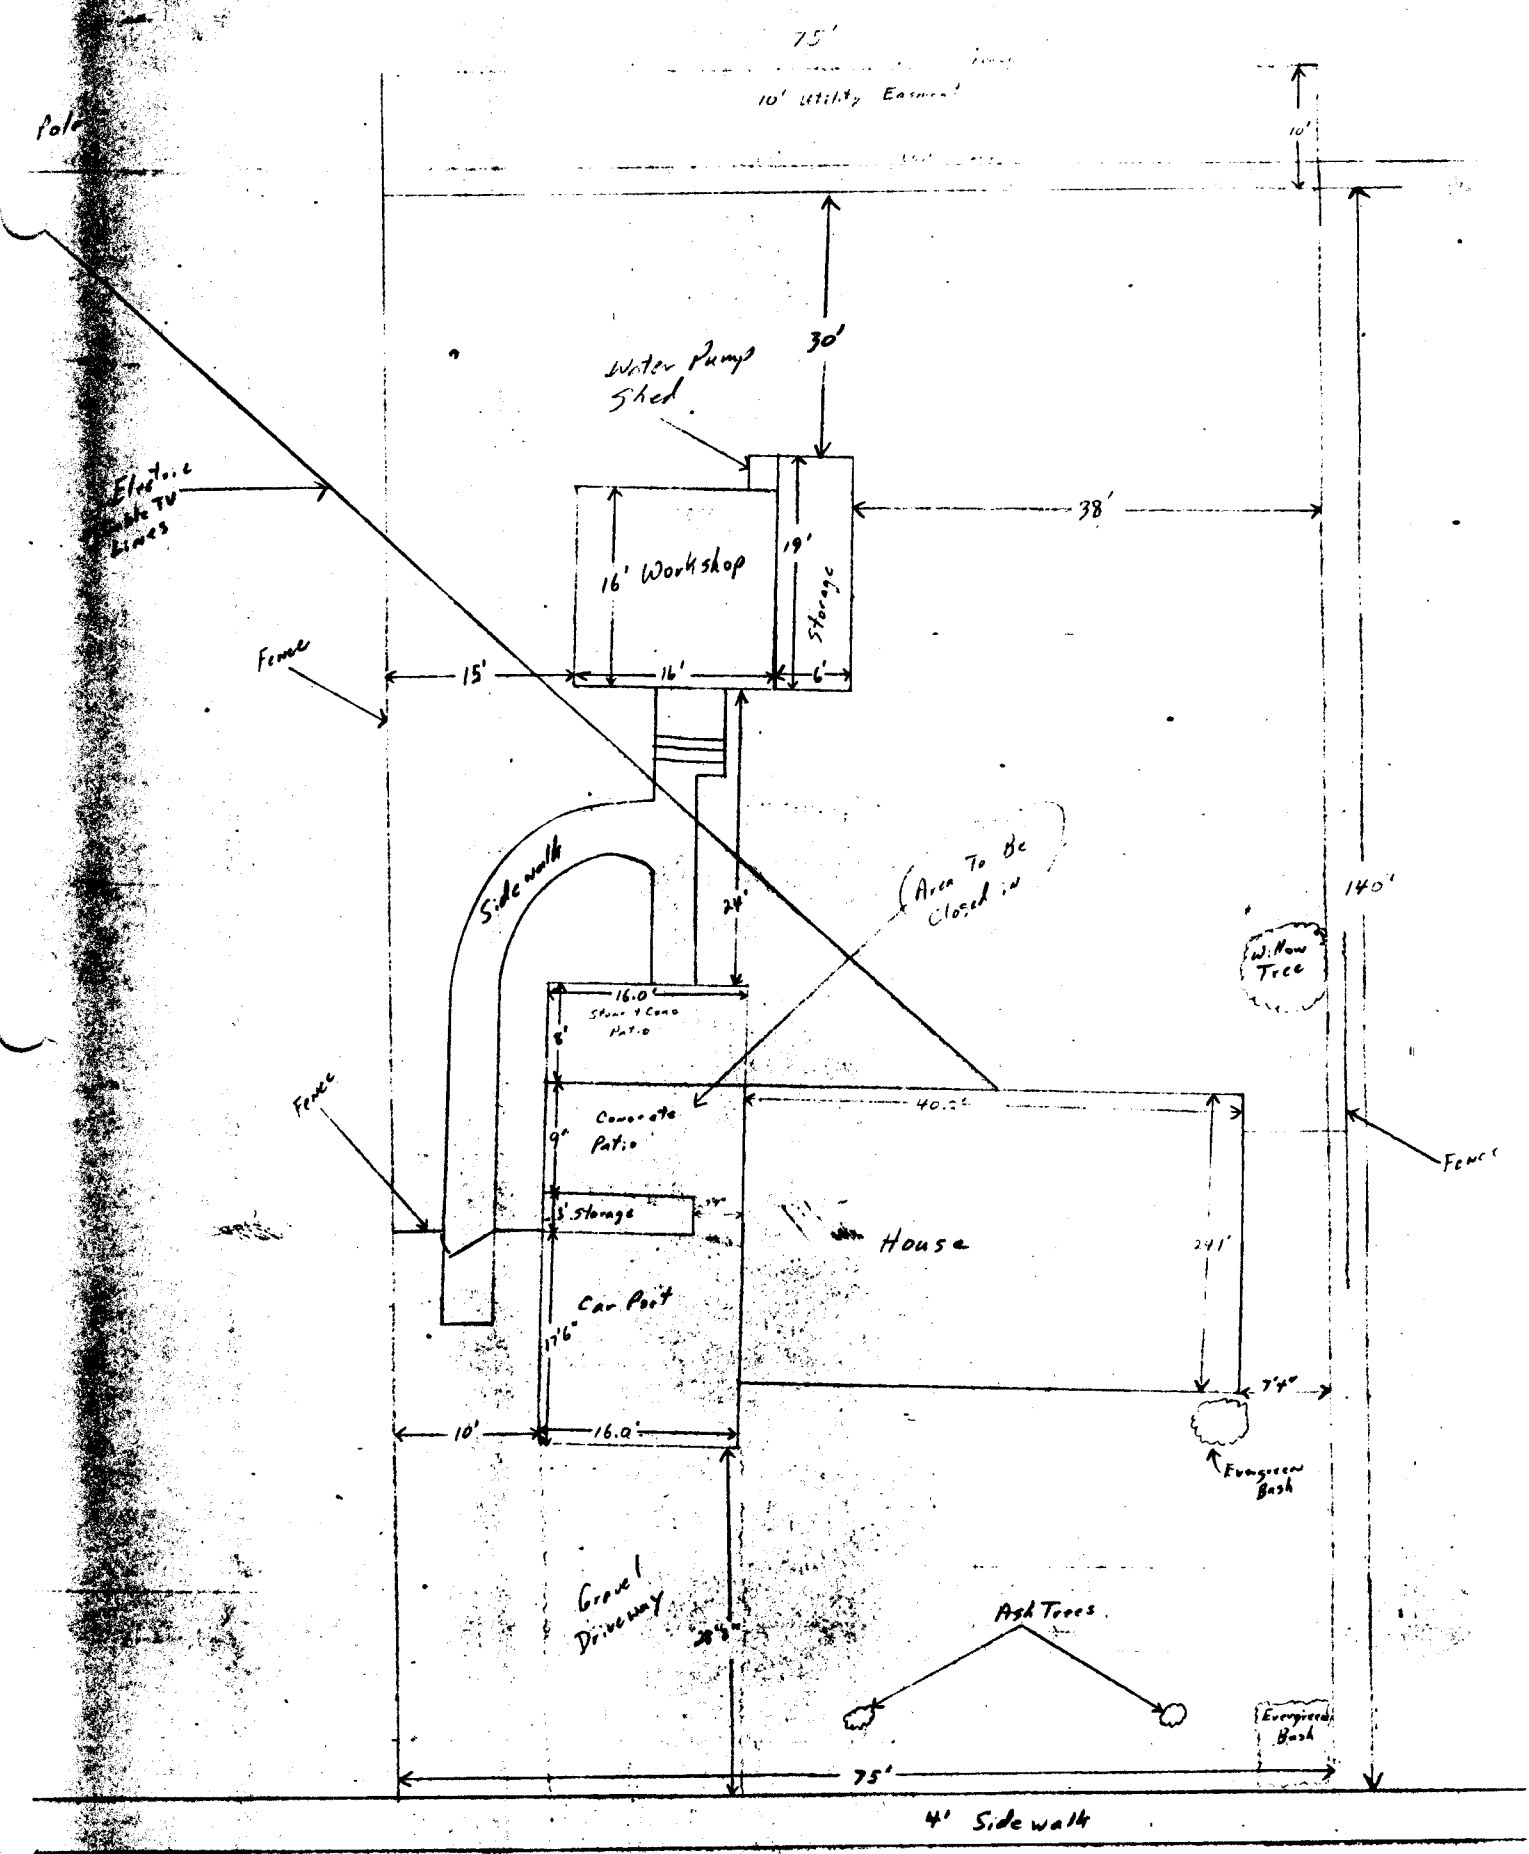

2857 Bunting Avenue