

/	
City	County

## APPLICATION FOR THE PLANNING CLEARANCE FOR A BUILDING PERMIT

SUBMITTALS REQUIRED: (2) Plot Plans showing Parkin property lines, and all streets which abut the parc	g, Landscaping, Setbacks to all el:			
BLDG ADDRESS: 839 Grand are	SQ FT OF BLDG: 1, 800			
UBDIVISION:	SQ FT OF LOT: 7, 500			
FILING # BLK # <u>85</u> LOT # <u>9+10</u>	NUMBER OF FAMILY UNITS:			
TAX SCHEDULE NUMBER:	NUMBER OF BUILDINGS ON PARCEL			
2945 - 144-04-004	BEFORE THIS PLANNED CONSTRUCTION			
PROPERTY OWNER: Boy Scruts of Americal	onl			
ADDRESS: 628 Road avenue	USE OF ALL EXISTING BUILDINGS:			
PHONE: 24-3-0346	office Building			
DESCRIPTION OF WORK AND INTENDED USE:				
office fulding				
******************				
FOR OFFICE USE ONL	•			
ZONE:	FLOOD PLAIN: YES (NO)			
€TBACKS: F <u>55'£</u> S <u>O'</u> R <u>O'</u>	GEOLOGIC HAZARD: YES NO			
RIGHT OF WAY: \co'	CENSUS TRACT NUMBER:			
MAXIMUM HEIGHT: 40'	SPECIAL CONDITIONS: parking area will			
ARKING SPACES REQUIRED:	pavied and strong w/ curb blocks			
LANDSCAPING/SCREENING: 25 shown on	save pine tree in front All other			
attached plan	area will be sod per site plan attached			
****************	*******			
ANY MODIFICATION TO THIS APPROVED PLANNING CLEARANCE THIS DEPARTMENT.	E MUST BE APPROVED IN WRITING BY			
THE STRUCTURE APPROVED BY THIS APPLICATION CANNOT B				
OF OCCUPANCY (CO) IS ISSUED BY THE BUILDING DEPARTM Code).	ENT (Section 307, Uniform Building			
ANY LANDSCAPING REQUIRED BY THIS PERMIT SHALL BE MA				
CONDITION. THE REPLACEMENT OF ANY VEGETATION MATER CONDITION SHALL BE REQUIRED.	TALS THAT DIE OR ARE IN AN UNHEALTHY			
·				
I HEREBY ACKNOWLEDGE THAT I HAVE READ THIS APPLICAT AGREE TO COMPLY WITH THE REQUIREMENTS ABOVE. FAILURACTION.				
ACTION.				
	SIGNATURE			
DATE APPROVED: 2-14-85	()			
APPROVED BY:	•			
	·			

معا) ج 501 Winds as I go'x roll the arriver Strong blats grind addition 21' \00° doss Bunk axisting house 401 New Porter € 9 -> 301 ALL D XXXV (MEN XXX X USheoms

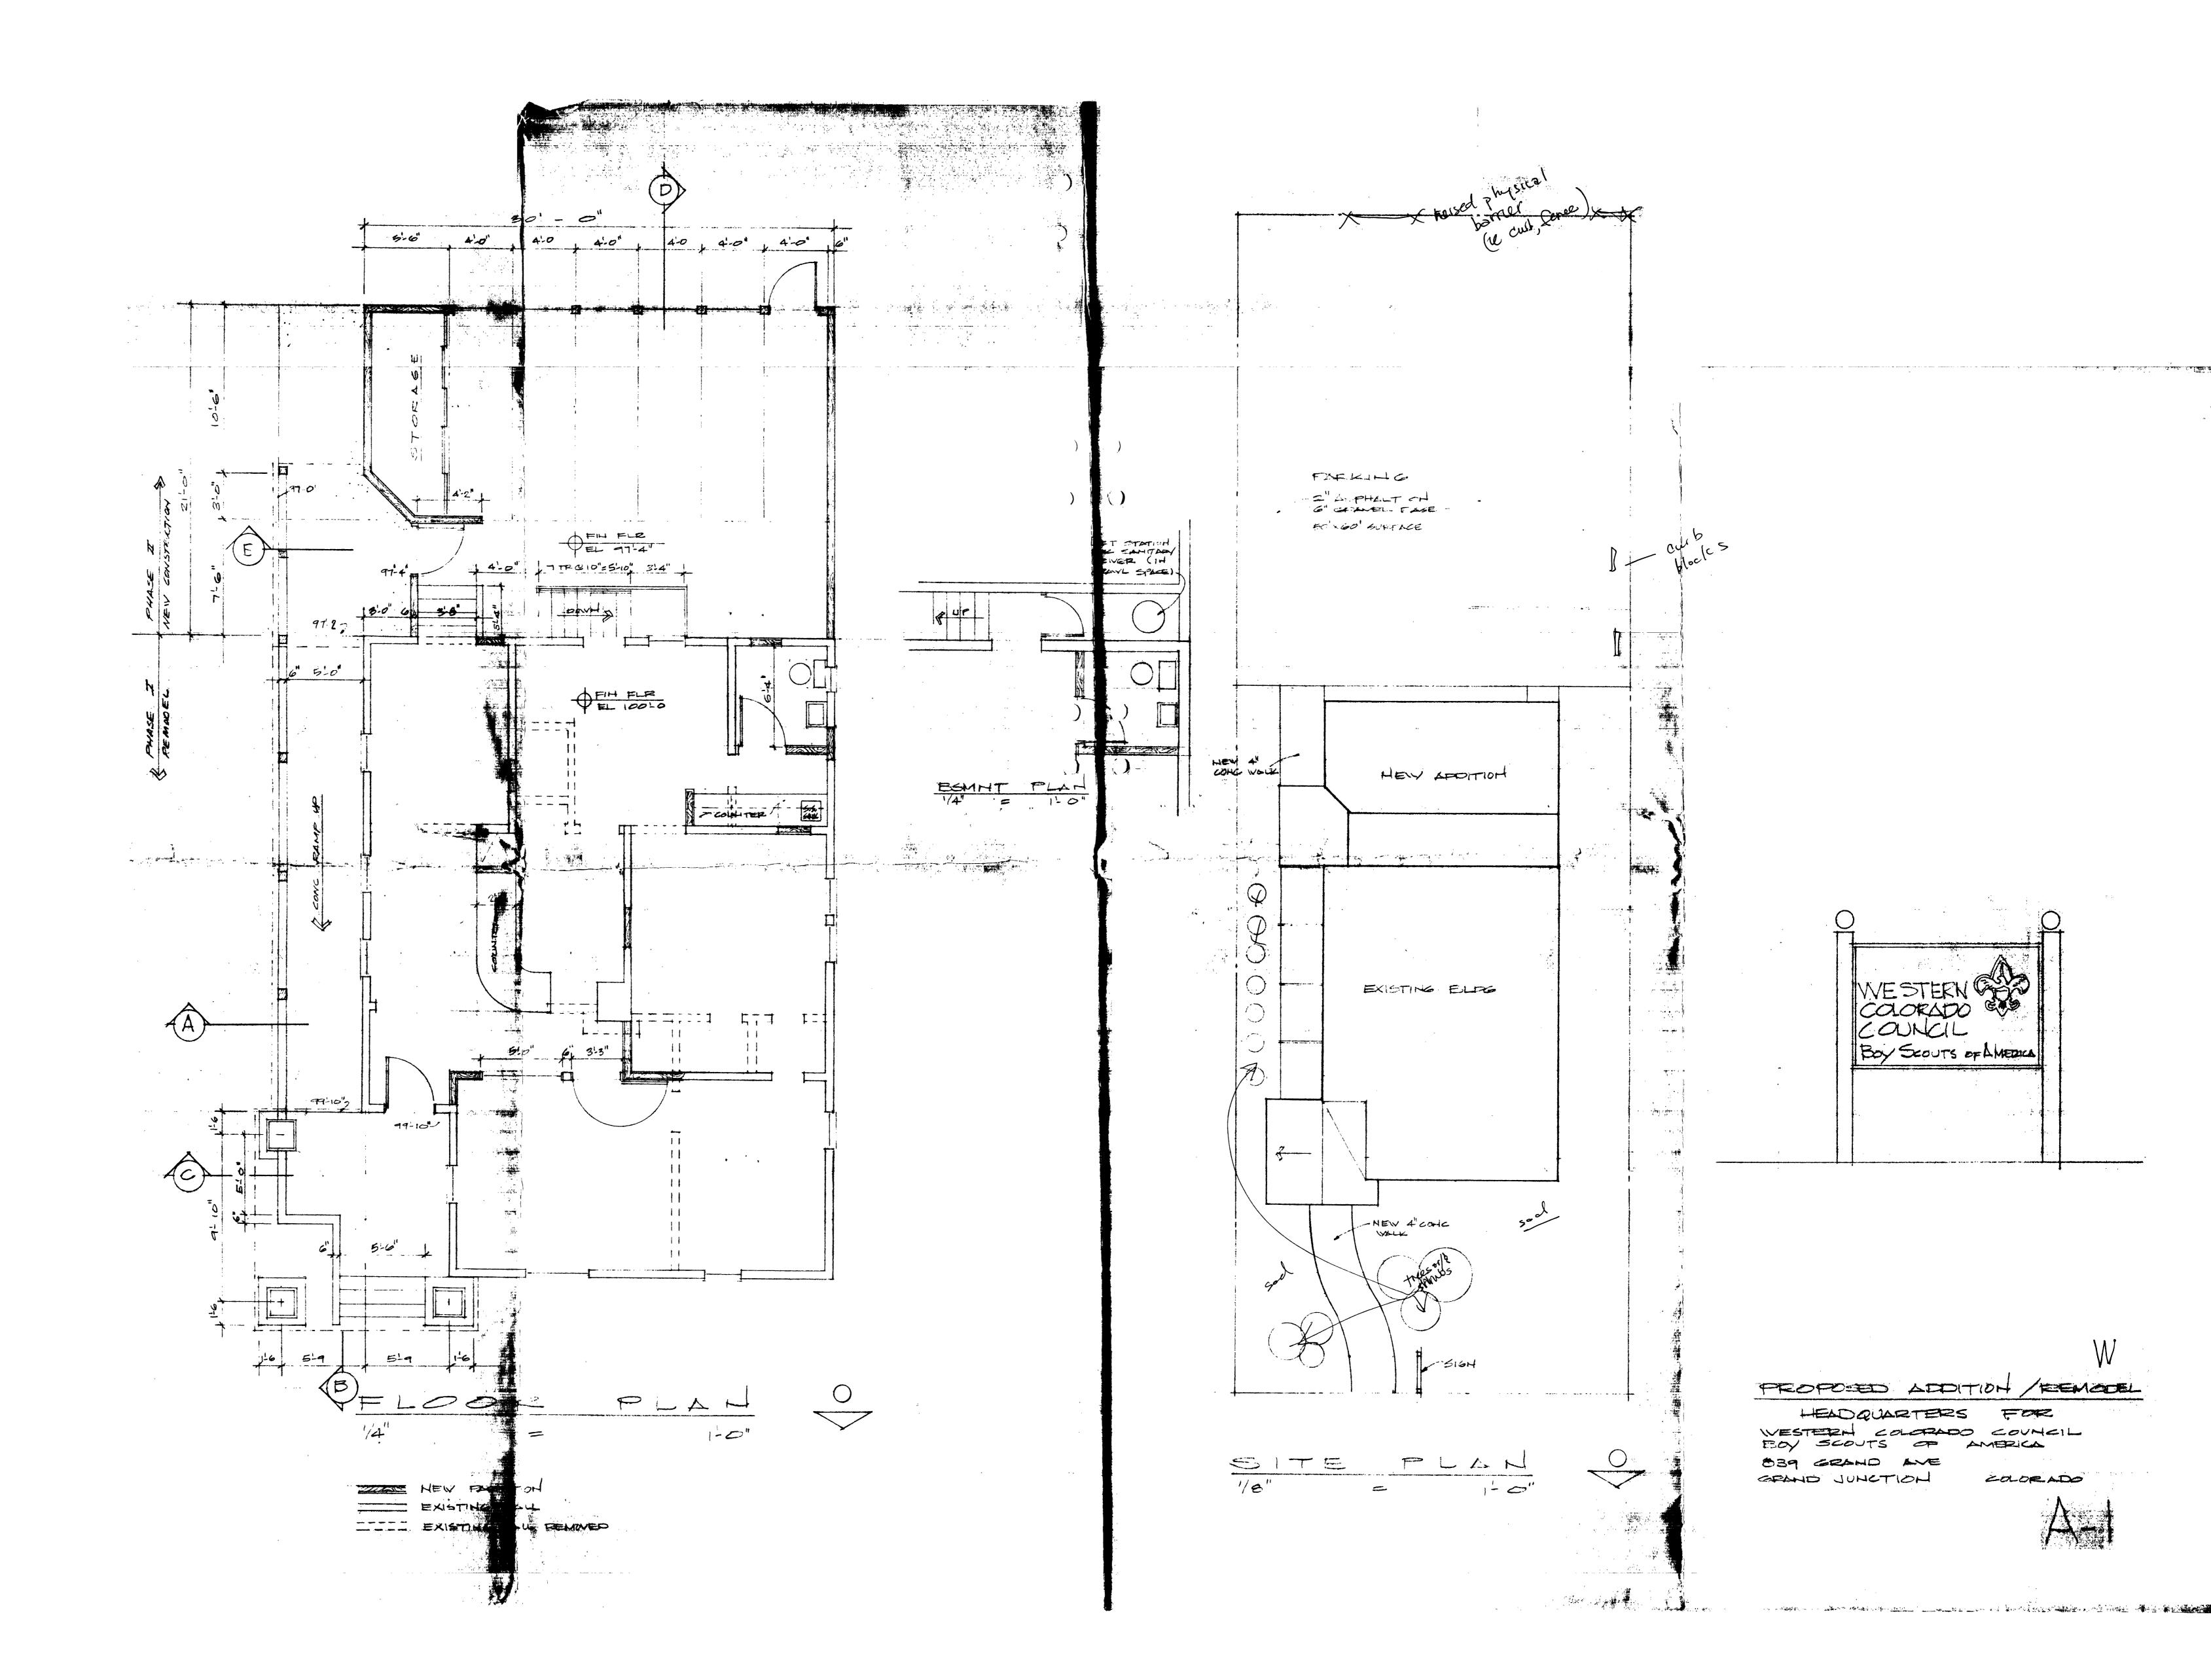

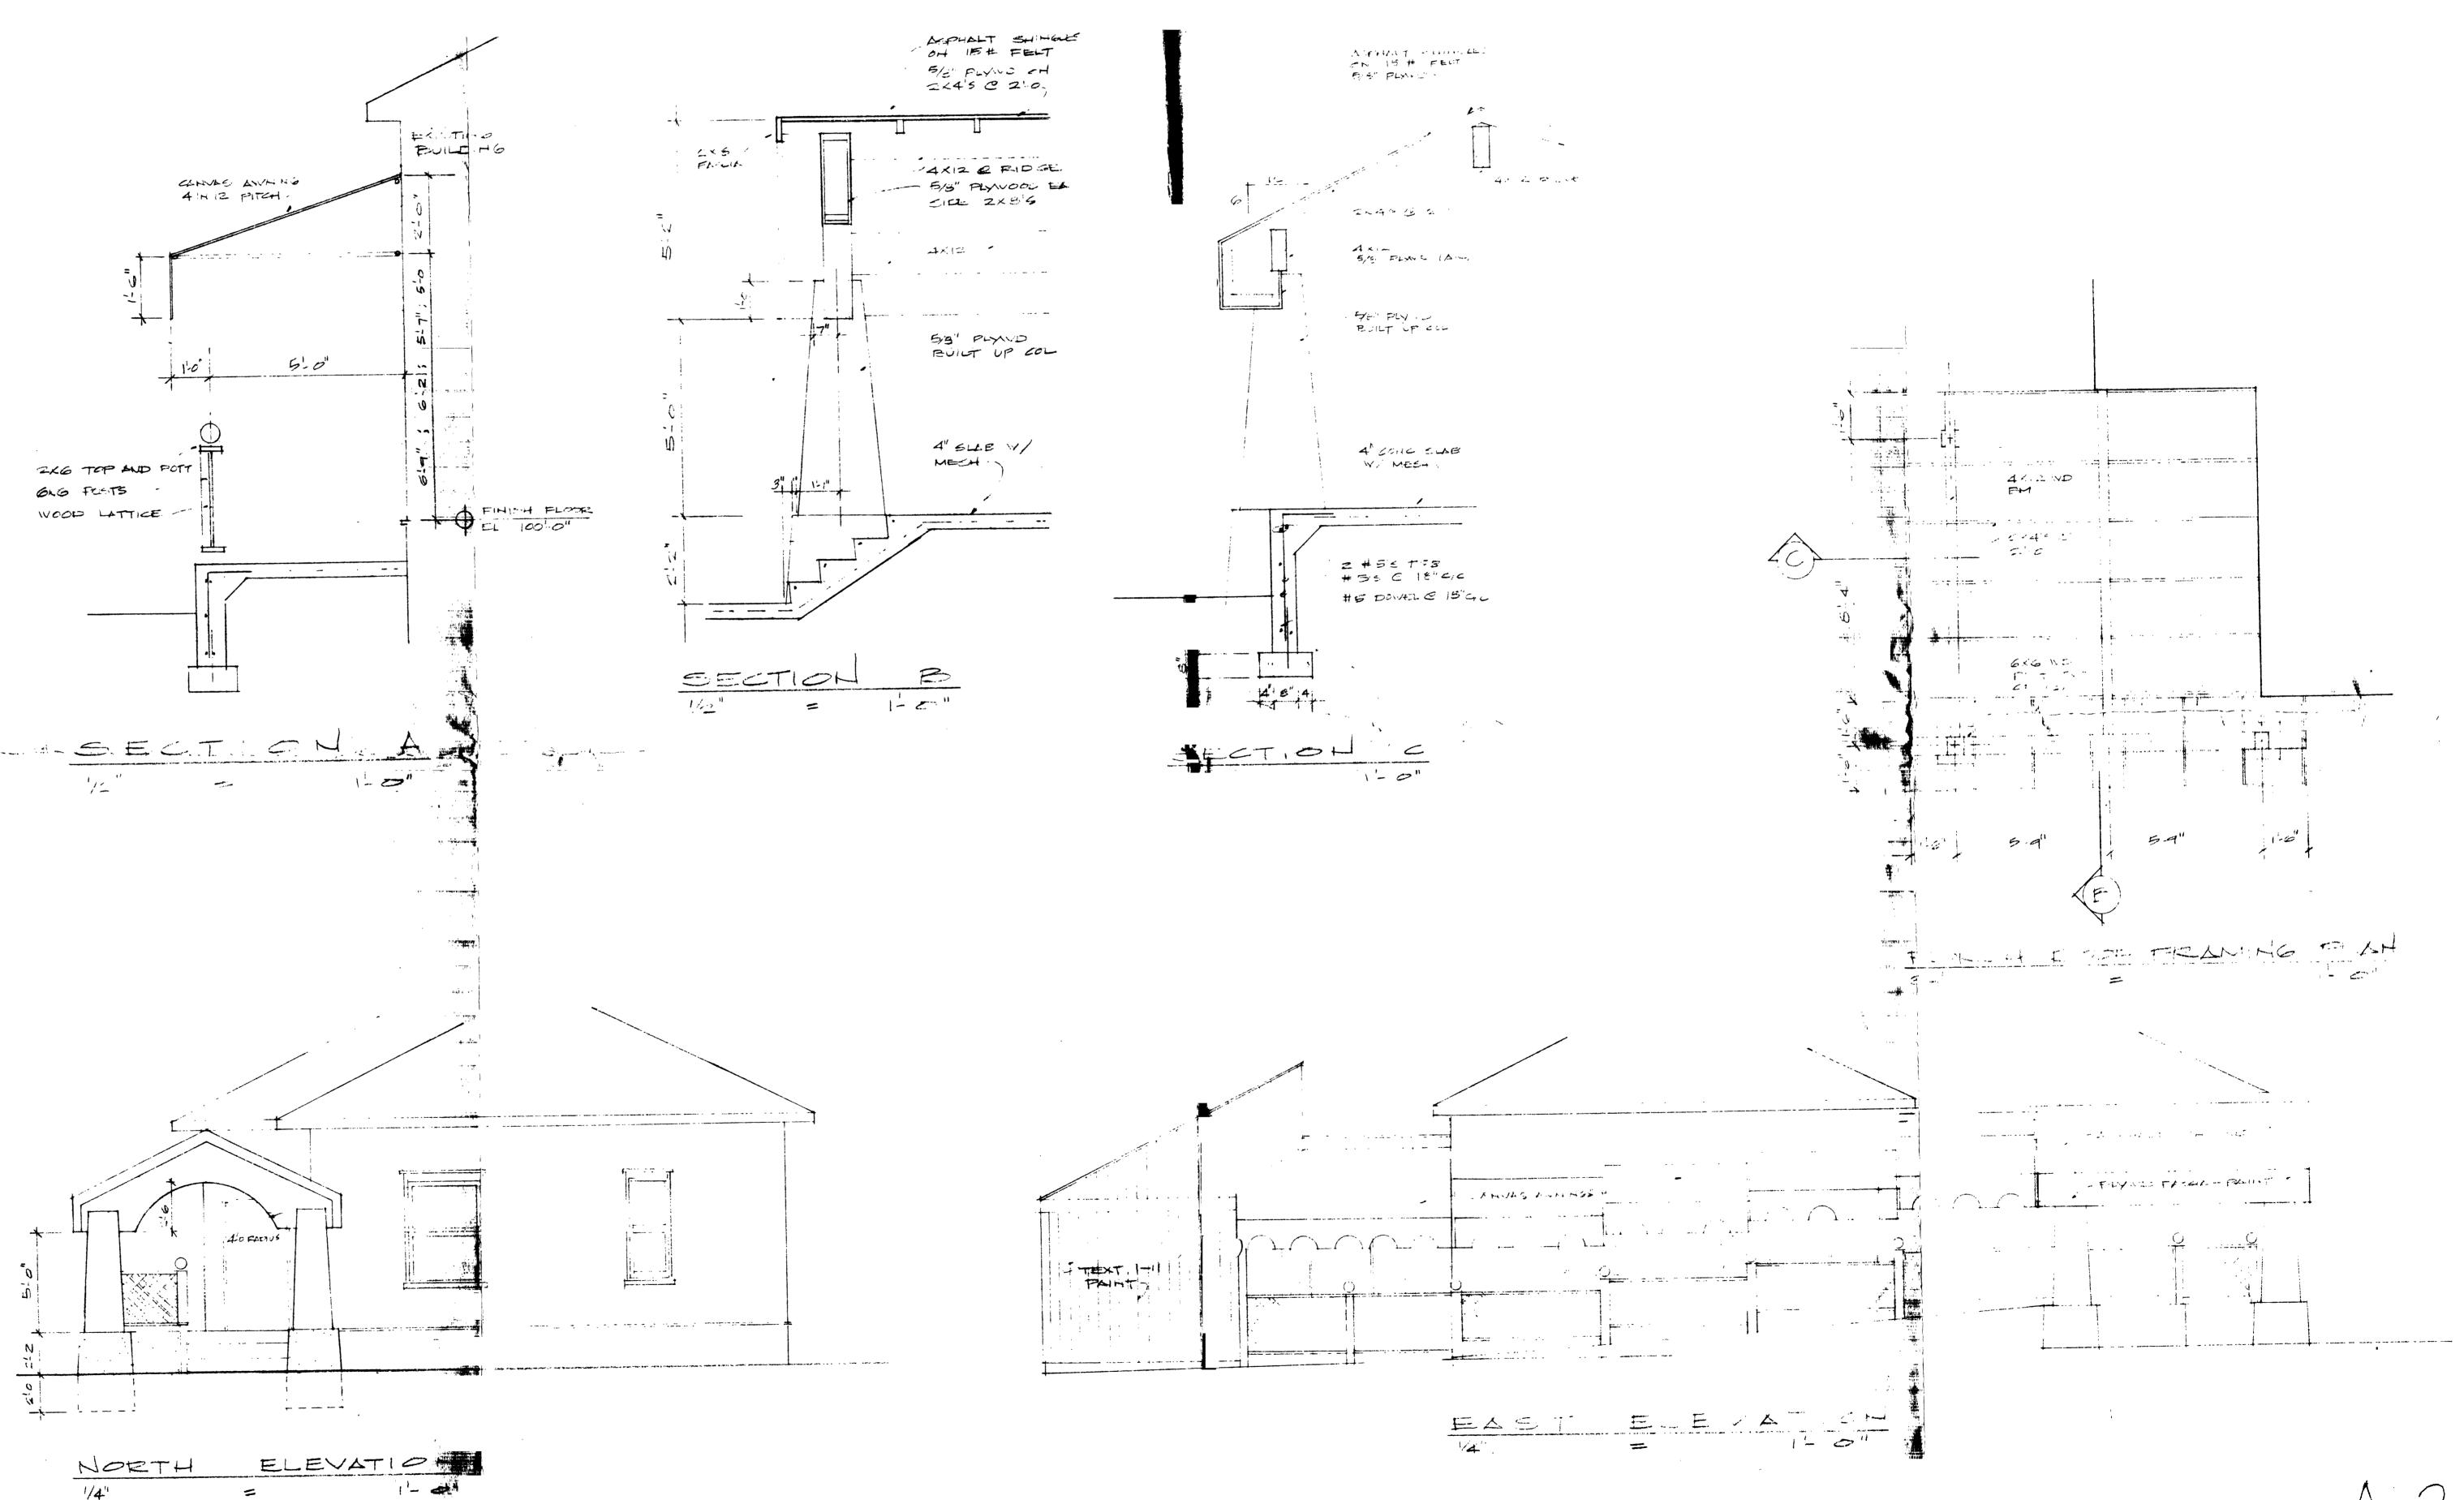

A-2