
	· · · · · · · · · · · · · · · · · · ·
DATE SUBMITTED: 43/86	PERMIT # 25079 FEE #500
, ,	FEE \$500
PLANNING CLEARANCE	
GRAND JUNCTION PLANN	ING DEPARTMENT
BLDG ADDRESS: 1529 Booker, & C.	SQ. FT. OF BLDG: $12^{\prime} \times 16^{\prime}$
SUBDIVISION:	SQ. FT. OF LOT:
FILING # BLK # LOT #	NUMBER OF FAMILY UNITS:
TAX SCHEDULE NUMBER:	NUMBER OF BUILDINGS ON PARCEL BEFORE THIS PLANNED CONSTRUCTION:
2945-122-12-010	before This Planned Construction:
PROPERTY OWNER: Roger C Malan	
ADDRESS: 1529 130020 (1)	USE OF ALL EXISTING BUILDINGS:
PHONE: 242-3093	- lodging
DESCRIPTION OF WORK AND INTENDED USE:	SUBMITTALS REQ'D: TWO (2) PLOT PLANS SHOWING PARKING, LAND-
small frame storage shed	SCAPING, SETBACKS TO ALL PROPERTY LINES, AND ALL STREETS WHICH ABUT
,	THE PARCEL.

ZONE: RMF-16	FLOODPLAIN: YES NOX
SETBACKS: F NA S 3 R 10'	GEOLOGIC HAZARD: YES NO X
MAXIMUM HEIGHT:	
PARKING SPACES REQ'D:	CENSUS TRACT #: 6
LANDSCAPING/SCREENING:	TRAFFIC ZONE: 3/
	SPECIAL CONDITIONS:

ANY LANDSCAPING REQUIRED BY THIS PERMIT SHALL BE MAINTAINED IN AN ACCEPTABLE AN HEALTHY CONDITION. THE REPLACEMENT OF ANY VEGETATION MATERIALS THAT DIE OR ARE IN AN UNHEALTHY CONDITION SHALL BE REQUIRED.	
I HEREBY ACKNOWLEDGE THAT I HAVE READ THIS APPLICATION AND THE ABOVE IS CORRECT AND I AGREE TO COMPLY WITH THE REQUIREMENTS ABOVE. FAILURE TO COMPLY SHALL RESUL IN LEGAL ACTION.	
DATE APPROVED: $\frac{4/3/R}{}$	M/ (hl.)
APPROVED BY: Sinde West 30	SIGNATURE SIGNATURE

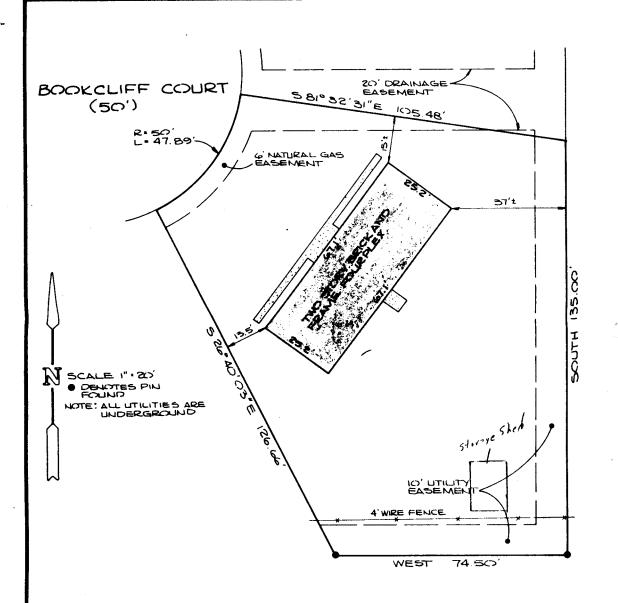

IMPROVEMENT LOCATION CERTIFICATE

LEGAL DESCRIPTION: 1529 BOOKGLIFF COURT, LOT 4, BOOKGLIFF COURT SUBDIVISION, CITY OF GRAND JUNCTION, COUNTY OF MESA, STATE OF COLORADO.

I HEREBY CERTIFY THAT THIS IMPROVEMENT LOCATION CERTIFICATE WAS PREPARED FOR VAN SCHAACK MORTGAGE Co. , THE IMPROVEMENT LOCATION BEING BASED ON PREVIOUS PROPERTY SURVEY THAT HAS BEEN MONUMENTED BY OTHERS, AND THAT IT IS NOT TO BE RELIED UPON FOR THE ESTABLISHMENT OF FENCE, BUILDING, OR OTHER FUTURE IMPROVEMENT LINES.

I FURTHER CERTIFY THAT THE IMPROVEMENTS ON THE ABOVE DESCRIBED PARCEL ON THIS DATE, 29 DECEMBER 1977, EXCEPT UTILITY CONNECTIONS, ARE ENTIRELY WITHIN THE BOUNDARIES OF THE PARCEL, EXCEPT AS SHOWN, THAT THERE ARE NO ENCROAGHMENTS UPON THE DESCRIBED PREMISES BY IMPROVEMENTS ON ANY ADJOINING PREMISES, EXCEPT AS INDICATED, AND THAT THERE IS NO EVIDENCE OR SIGN OF ANY EASEMENT CROSSING OR BURDENING ANY PART OF SAID PARCEL, EXCEPT AS NOTED.



REGISTERED LAND SURVEYON LS 9331

4

Q

COLORADO WEST SURVEYING COMPANY 835 COLORADO AVENUE GRAND JUNCTION, COLORADO 81501