

DATE SUBMITTED: 7-22-87

PERMIT # 28212

FEE \$500

# PLANNING CLEARANCE

GRAND JUNCTION PLANNING DEPARTMENT

BLDG ADDRESS: 316 Hope

SQ. FT. OF BLDG: 260 +/-

SUBDIVISION: Reservation Sub

SQ. FT. OF LOT: 96 X 148

FILING # \_\_\_\_\_ BLK # 96 LOT # 1

NUMBER OF FAMILY UNITS: 1

TAX SCHEDULE NUMBER:  
2945-244-06-008

NUMBER OF BUILDINGS ON PARCEL BEFORE THIS PLANNED CONSTRUCTION:  
1

PROPERTY OWNER: Charles Beyle

USE OF ALL EXISTING BUILDINGS:

ADDRESS: 316 Hope

Storage

PHONE: 241-4991

DESCRIPTION OF WORK AND INTENDED USE:  
Remodel Car Port

SUBMITTALS REQ'D: TWO (2) PLOT PLANS SHOWING PARKING, LANDSCAPING, SETBACKS TO ALL PROPERTY LINES, AND ALL STREETS WHICH ABUT THE PARCEL.

\*\*\*\*\*

### FOR OFFICE USE ONLY

ZONE: RSF-8

FLOODPLAIN: YES \_\_\_\_\_ NO X

SETBACKS: F 20' S 5' R 15'

GEOLOGIC HAZARD: YES \_\_\_\_\_ NO X

MAXIMUM HEIGHT: \_\_\_\_\_

CENSUS TRACT #: 13

PARKING SPACES REQ'D: \_\_\_\_\_

TRAFFIC ZONE: 80

LANDSCAPING/SCREENING: \_\_\_\_\_

SPECIAL CONDITIONS: \_\_\_\_\_

\*\*\*\*\*

ANY MODIFICATION TO THIS APPROVED PLANNING CLEARANCE MUST BE APPROVED, IN WRITING, BY THE DEPARTMENT. THE STRUCTURE APPROVED BY THIS APPLICATION CANNOT BE OCCUPIED UNTIL A CERTIFICATE OF OCCUPANCY (C.O.) IS ISSUED BY THE BUILDING DEPARTMENT (SECTION 307, UNIFORM BUILDING CODE.)


ANY LANDSCAPING REQUIRED BY THIS PERMIT SHALL BE MAINTAINED IN AN ACCEPTABLE AN HEALTHY CONDITION. THE REPLACEMENT OF ANY VEGETATION MATERIALS THAT DIE OR ARE IN AN UNHEALTHY CONDITION SHALL BE REQUIRED.

I HEREBY ACKNOWLEDGE THAT I HAVE READ THIS APPLICATION AND THE ABOVE IS CORRECT AND I AGREE TO COMPLY WITH THE REQUIREMENTS ABOVE. FAILURE TO COMPLY SHALL RESULT IN LEGAL ACTION.

DATE APPROVED: 7-22-87

APPROVED BY: [Signature]

Robert L. Curnio  
SIGNATURE

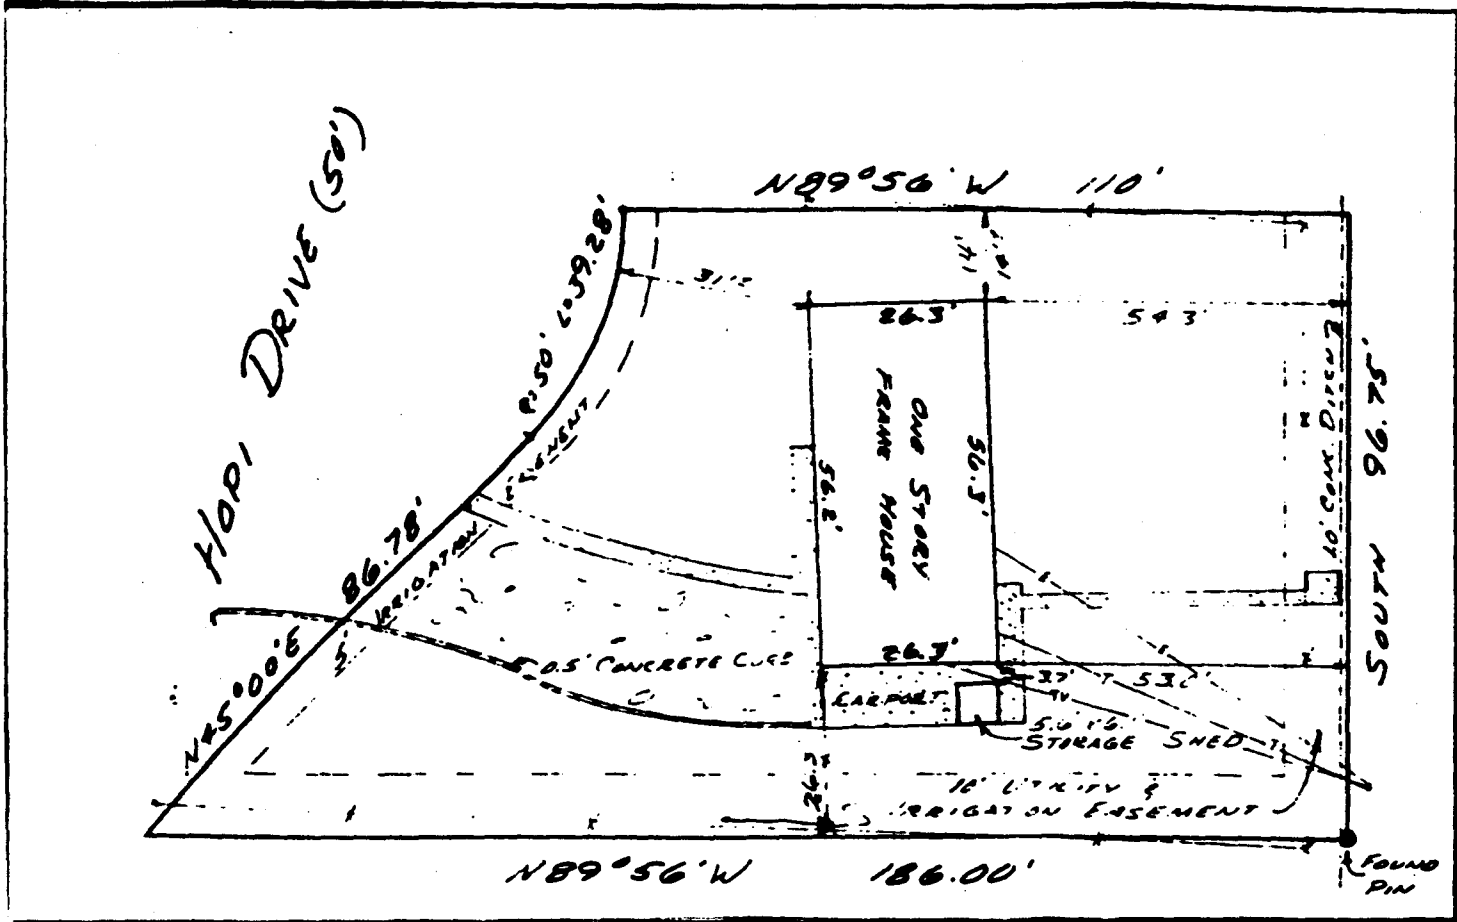

**LOCATION**

**LEGAL DESCRIPTION:** 316 Hopi Drive, Lot 1, Block 1, The Reservation, County of Mesa, State of Colorado