

PHILLIPS CONSTRUCTION COMPANY


345 33 Rd.
Palisade, Colorado 81526
434-6637

Client JIM FLYNN
Project 2906 NORTH AVE.
Subject STORAGE UNITS

Sht 1 of 3
Job _____
Date 3-16-88
by RMP

Plot Plan

SCALE 1" = 40'

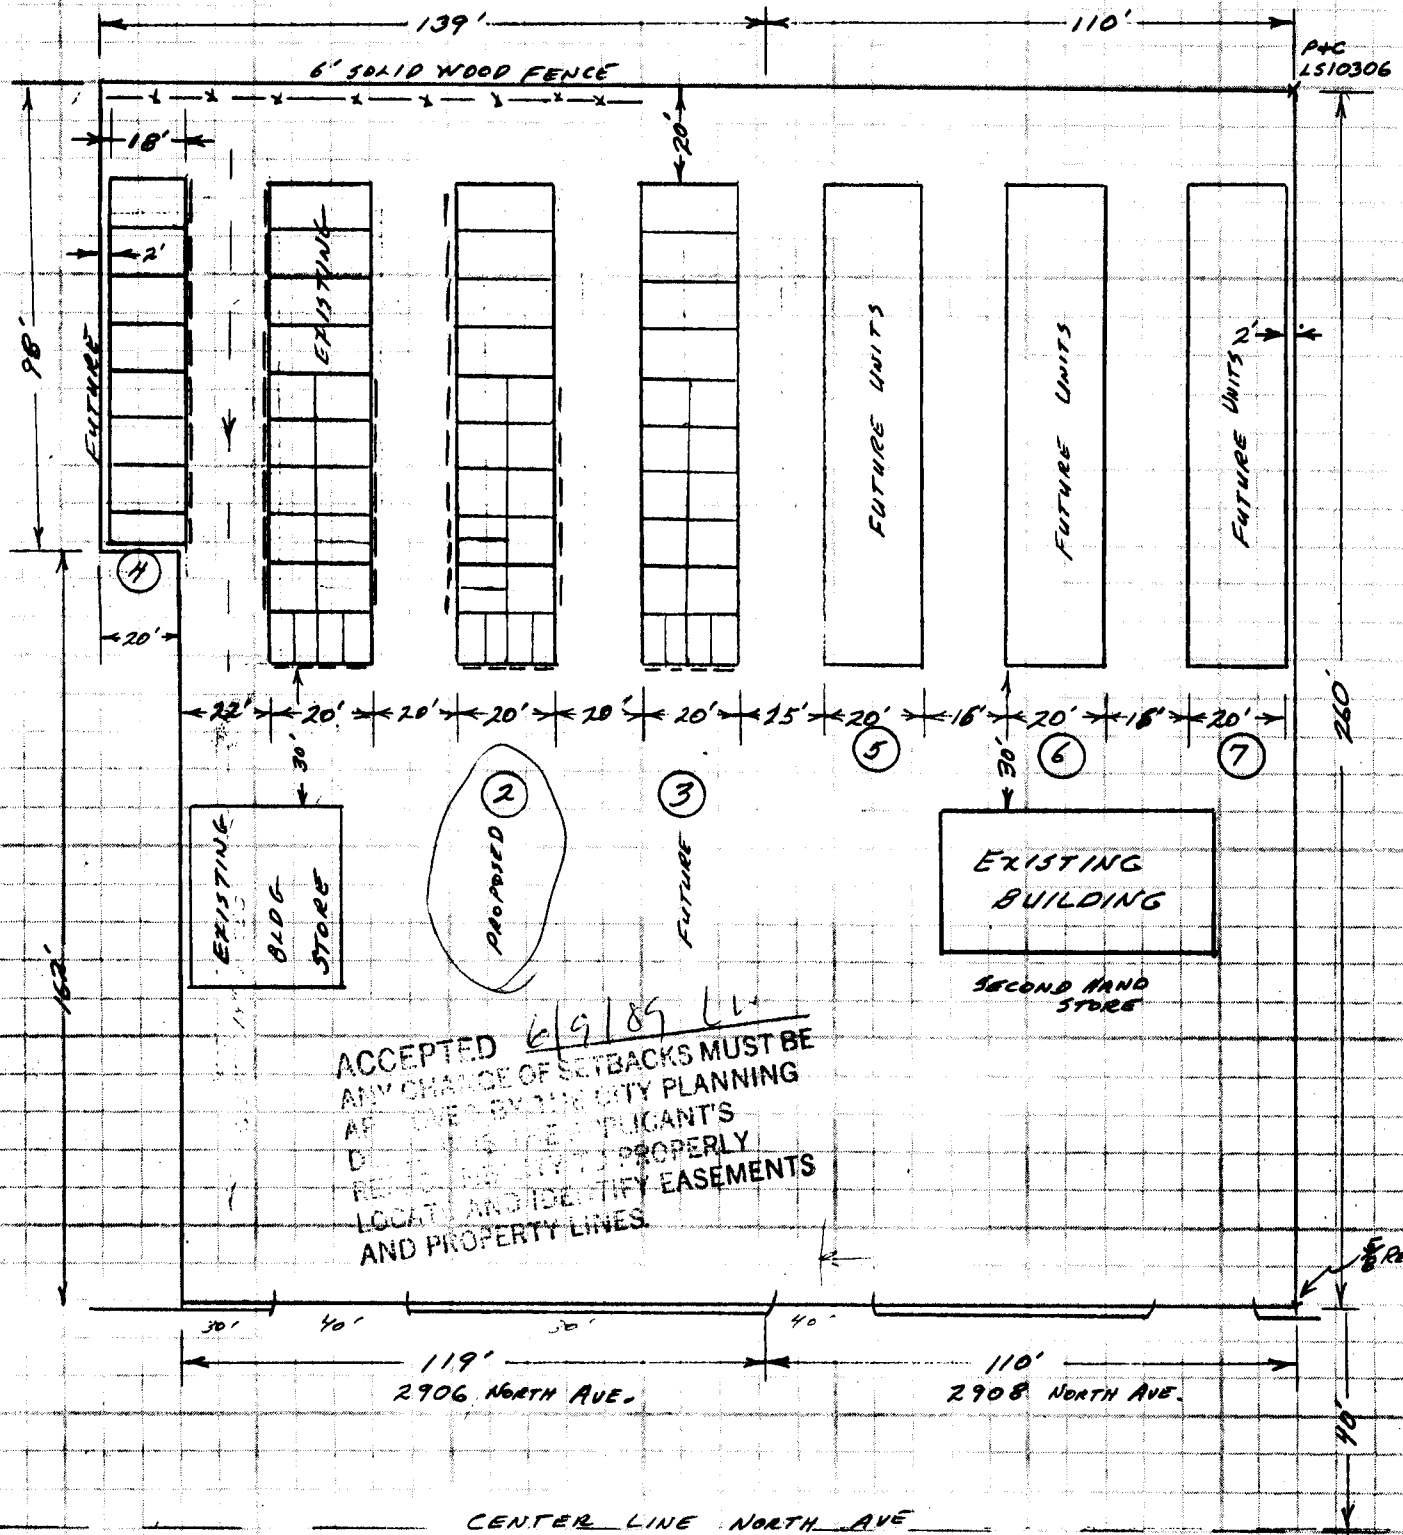

ACCEPTED 6/9/89 LL
 ANY CHANGE OF SETBACKS MUST BE
 APPROVED BY THE CITY PLANNING
 DEPARTMENT. THE APPLICANT'S
 RESPONSIBILITY TO PROPERLY
 LOCATE AND IDENTIFY EASEMENTS
 AND PROPERTY LINES.

PHILLIPS CONSTRUCTION COMPANY


345 33 Rd.
Palisade, Colorado 81526
434-6637

Client JIM FLYNN
Project 2906 NORTH AVE
Subject STORAGE UNITS
20' X 100' BUILDING

Sht 1 of 3
Job _____
Date 5-16-89
by RRP

PLOT PLAN

SCALE 1"=40'

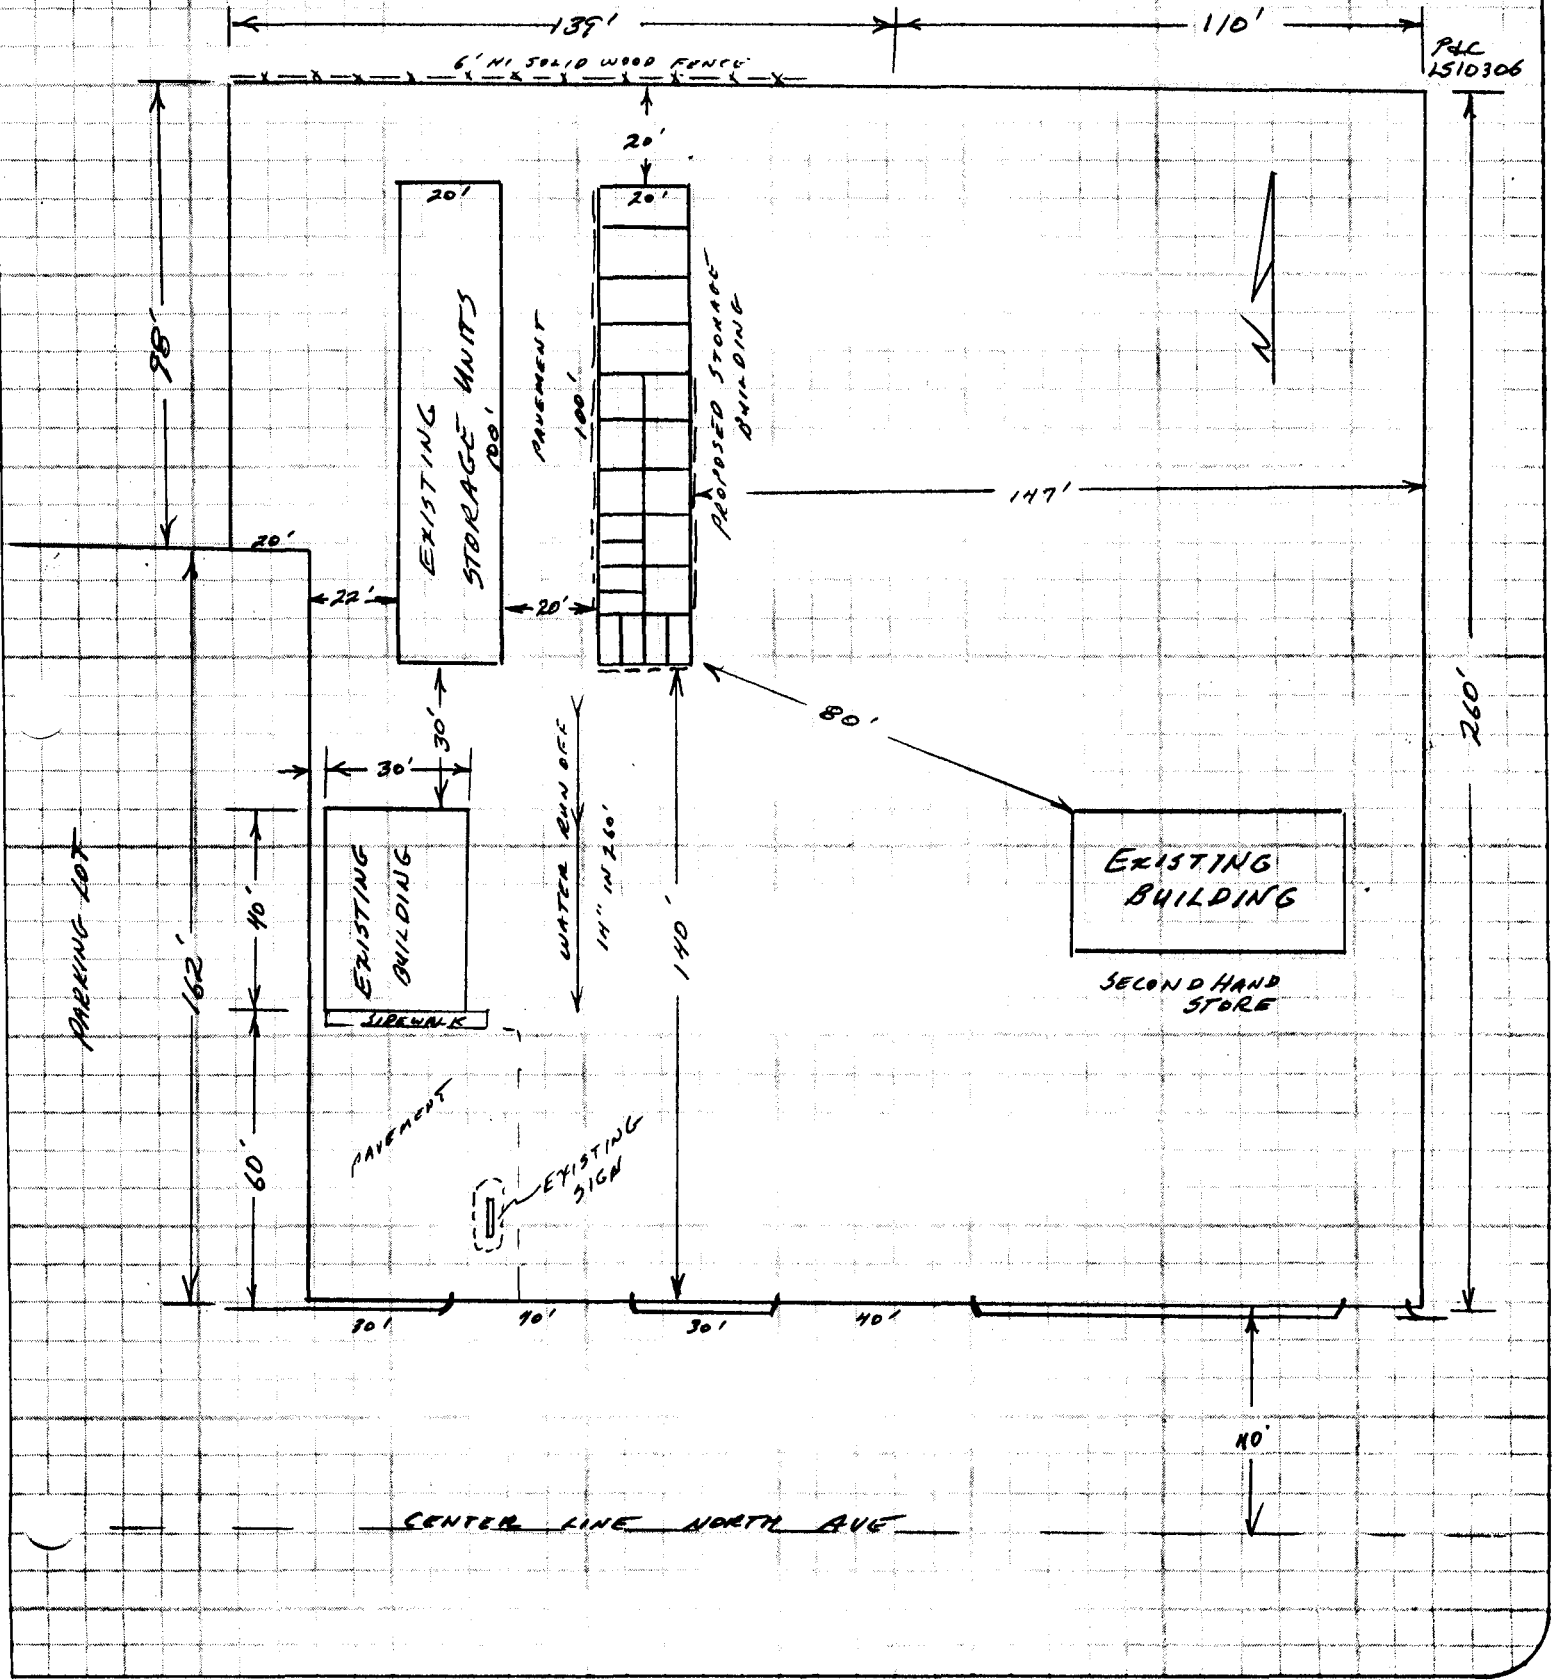

P&L
1510306