
DATE SUBMITTED: 4-19-91	PERMIT # 38462
PLANNING C	
GRAND JUNCTION PLAN	
BLDG ADDRESS: 425 N, 10 72	SQ. FT. OF BLDG: 362 # she
SUBDIVISION: <u>G.J.</u>	SQ. FT. OF LOT:
FILING #BLK # 69 LOT # $17-32$	
TAX SCHEDULE NUMBER:	NUMBER OF BUILDINGS ON PARCEL
2945 141 40 971	BEFORE THIS PLANNED CONSTRUCTION:
PROPERTY OWNER: MESA DEVELOPMENTAL SERVI	
ADDRESS: 425 N. 10 ML	USE OF ALL EXISTING BUILDINGS:
PHONE: 243-3702	Mesa Developmental services
DESCRIPTION OF WORK AND INTENDED USE:	SUBMITTALS REQ'D: TWO (2) PLOT PLANS SHOWING PARKING, LAND-
Tool Shed	SCAPING, SETBACKS TO ALL PROPERTY LINES, AND ALL STREETS WHICH ABUT
	THE PARCEL.
**************************************	**************************************
JONE: RMF-64	
Arcar	FLOODPLAIN: YES NO
SETBACKS: F S 3/ R 3/	GEOLOGIC HAZARD: YES NO
MAXIMUM HEIGHT:	CENSUS TRACT #: 2
PARKING SPACES REQ'D:	2
LANDSCAPING/SCREENING:	TRAFFIC ZONE:
·	SPECIAL CONDITIONS:
**************************************	NG CLEARANCE MUST BE APPROVED, IN RE APPROVED BY THIS APPLICATION DF OCCUPANCY (C.O.) IS ISSUED BY THE
ANY LANDSCAPING REQUIRED BY THIS PERMIT AN HEALTHY CONDITION. THE REPLACEMENT OF OR ARE IN AN UNHEALTHY CONDITION SHALL B	F ANY VEGETATION MATERIALS THAT DIE
I HEREBY ACKNOWLEDGE THAT I HAVE READ TH CORRECT AND I AGREE TO COMPLY WITH THE R DMPLY SHALL RESULT IN LEGAL ACTION.	
DATE APPROVED: 4-19-9/	An. Dan
APPROVED BY: Martins	SIGNATURE
	\smile
$\frac{1}{2} \left[\frac{1}{2} \left$	

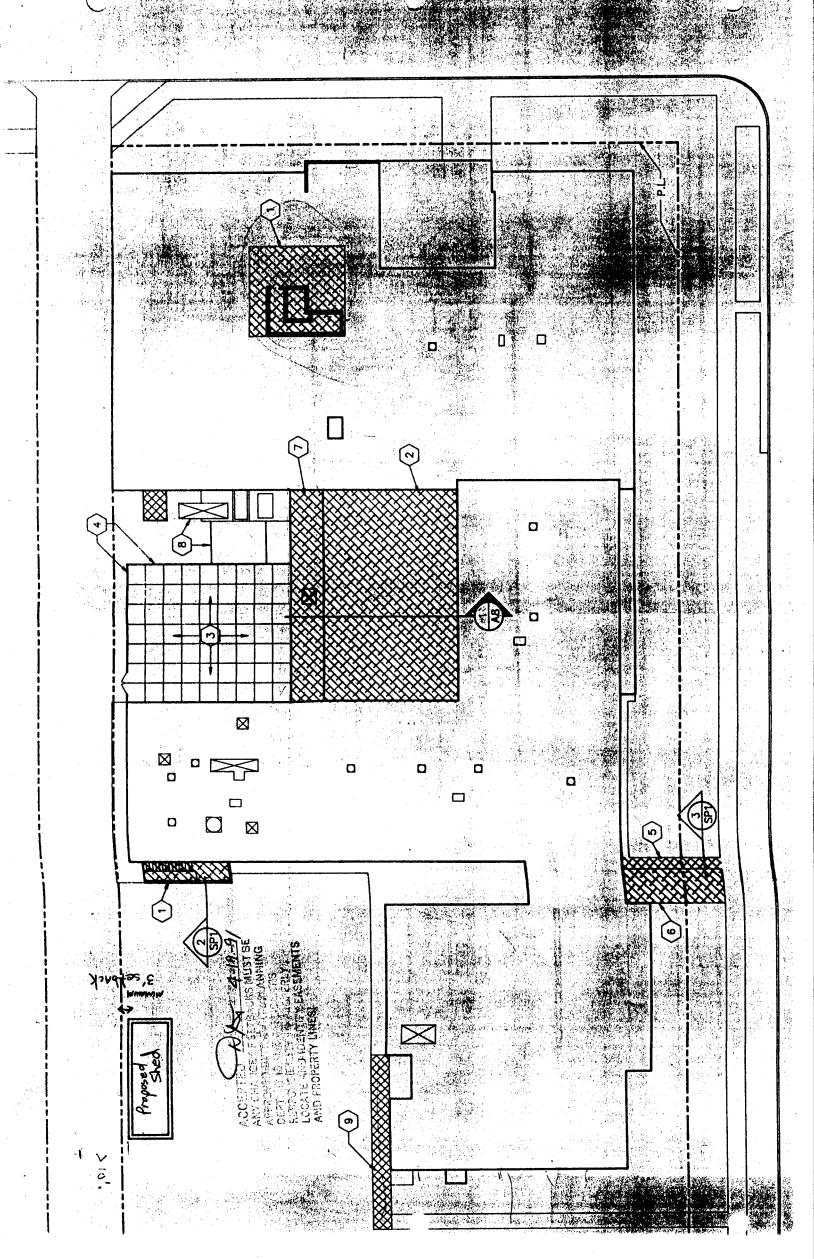

.