

DATE SUBMITTED: 5-1-91

PERMIT # 38899
FEE 8500

PLANNING CLEARANCE

GRAND JUNCTION PLANNING DEPARTMENT

BLDG ADDRESS: 615 BLUE GULL

SQ. FT. OF BLDG: Garage is 22x36

SUBDIVISION: WESTLAKE PARK SUB

SQ. FT. OF LOT: _____

FILING # _____ BLK # 4 LOT # 3

NUMBER OF FAMILY UNITS: SF

TAX SCHEDULE NUMBER:
2945-104-05-003

NUMBER OF BUILDINGS ON PARCEL BEFORE THIS PLANNED CONSTRUCTION:
1

PROPERTY OWNER: MARK + RAMONA BENKLEY

USE OF ALL EXISTING BUILDINGS:
HOME

ADDRESS: 615 BLUE GULL DR

PHONE: 303-241-9090

DESCRIPTION OF WORK AND INTENDED USE:
GARAGE DETACHED

SUBMITTALS REQ'D: TWO (2) PLOT PLANS SHOWING PARKING, LANDSCAPING, SETBACKS TO ALL PROPERTY LINES, AND ALL STREETS WHICH ABUT THE PARCEL.

FOR OFFICE USE ONLY

ZONE: RSF-8

FLOODPLAIN: YES _____ NO _____

SETBACKS: F 20' ~~3'~~ R 3'

GEOLOGIC HAZARD: YES _____ NO _____

MAXIMUM HEIGHT: 32'

CENSUS TRACT #: 4

PARKING SPACES REQ'D: _____

TRAFFIC ZONE: 10

LANDSCAPING/SCREENING: _____

SPECIAL CONDITIONS: _____

ANY MODIFICATION TO THIS APPROVED PLANNING CLEARANCE MUST BE APPROVED, IN WRITING, BY THE DEPARTMENT. THE STRUCTURE APPROVED BY THIS APPLICATION CANNOT BE OCCUPIED UNTIL A CERTIFICATE OF OCCUPANCY (C.O.) IS ISSUED BY THE BUILDING DEPARTMENT (SECTION 307, UNIFORM BUILDING CODE.)

ANY LANDSCAPING REQUIRED BY THIS PERMIT SHALL BE MAINTAINED IN AN ACCEPTABLE AN HEALTHY CONDITION. THE REPLACEMENT OF ANY VEGETATION MATERIALS THAT DIE OR ARE IN AN UNHEALTHY CONDITION SHALL BE REQUIRED.

I HEREBY ACKNOWLEDGE THAT I HAVE READ THIS APPLICATION AND THE ABOVE IS CORRECT AND I AGREE TO COMPLY WITH THE REQUIREMENTS ABOVE. FAILURE TO COMPLY SHALL RESULT IN LEGAL ACTION.


DATE APPROVED: MAY 4, 1991
APPROVED BY: [Signature]

[Signature]
SIGNATURE

South

ACCEPTED ~~DA~~ 5-1-91
ANY CHANGE OF SETBACKS MUST BE
APPROVED BY THE CITY PLANNING
DEPT. IT IS THE APPLICANT'S
RESPONSIBILITY TO PROPERLY
LOCATE AND IDENTIFY EASEMENTS
AND PROPERTY LINES.

↑
27'
↓

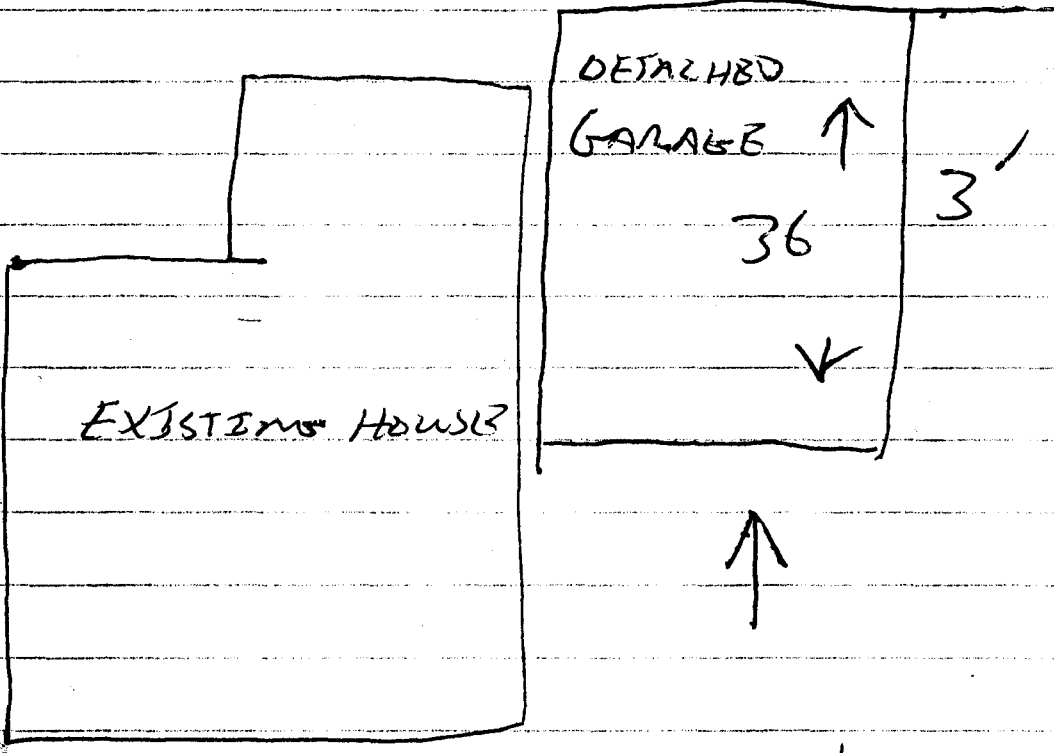

PRT

BLUE GILL DR
NORTH