	4/19/93						
DATE SUBMITTED: /8/20/92	11/4/92 PERMIT # 43367/						
	FEE 102						
PLANNING CL GRAND JUNCTION PLANNI	,						
BLDG ADDRESS: 901 NTh 151	sq. ft. of bldg: 288						
SUBDIVISION:	SQ. FT. OF LOT: VOLUES I						
TLING # BLK # LOT #	NUMBER OF FAMILY UNITS:						
TAX SCHEDULE NUMBER:	NUMBER OF BUILDINGS ON PARCEL						
7945 151 00 009	BEFORE THIS PLANNED CONSTRUCTION:						
PROPERTY OWNER: LARRY J PADINI	HCR OR ALL PATERTIES DUTTERTIES						
ADDRESS: 463 TIARA VISTADR.	USE OF ALL EXISTING BUILDINGS:						
PHONE: 24-7289.	ALES GREKE						
DESCRIPTION OF WORK AND INTENDED USE:	SUBMITTALS REQ'D: TWO (2) PLOT PLANS SHOWING PARKING, LAND-						
TEXP. SALES OFFICE	SCAPING, SETBACKS TO ALL PROPERTY LINES, AND ALL STREETS WHICH ABUT THE PARCEL.						
*********	***********						
**************************************							
NE: <u>C-2</u>	FLOODPLAIN: YES NO						
	GEOLOGIC HAZARD: YES NO						
MAXIMUM HEIGHT:	CENSUS TRACT #: 7						
ARKING SPACES REQ'D: N/A	TRAFFIC ZONE: 35						
LANDSCAPING/SCREENING: N/A							
	SPECIAL CONDITIONS:						
ANY MODIFICATION TO THIS APPROVED PLANNING WRITING, BY THS DEPARTMENT. THE STRUCTURE CANNOT BE OCCUPIED UNTIL A CERTIFICATE OF BUILDING DEPARTMENT (SECTION 307, UNIFORM	CLEARANCE MUST BE APPROVED, IN APPROVED BY THIS APPLICATION OCCUPANCY (C.O.) IS ISSUED BY THE						
ANY LANDSCAPING REQUIRED BY THIS PERMIT SHAN HEALTHY CONDITION. THE REPLACEMENT OF AN ARE IN AN UNHEALTHY CONDITION SHALL BE	ANY VEGETATION MATERIALS THAT DIE						
HEREBY ACKNOWLEDGE THAT I HAVE READ THIS CORRECT AND I AGREE TO COMPLY WITH THE REQUIPLY SHALL RESULT IN LEGAL ACTION.  DATE APPROVED: 10/20/97  APPROVED BY:							

To: File Building Permit #43367 10/20/92

From: Karl G. Metzner


Hell


Re: Landscaping Requirements

July 16, 1993


Building Permit #43367 was issued to replace an existing structure in a C-2 commercial zone. The permit indicates that the existing structure was used as a sales office and the new structure would also be used as a sales office. The property was considered nonconforming in that it did not meet current code requirements for landscaping. Section 4-9-1 paragraph A. of the Zoning and Development Code (non-conforming uses) states that— "A lawful structure or parcel of land existing at the time of adoption of this Code or prior ordinances of the City which is made nonconforming due solely to non-compliance with the bulk requirements of the zone in which it is located shall be allowed to continue free of the provisions of this section". Since the structure and property located at 901 N. 1st Street had been used as a sales office, and since this use had not been discontinued for more than one year (Section 4-9-1E.) it was determined that the replacement of the existing building by a new building for the same use did not require the property to come into compliance with the current code bulk requirements regarding landscaping. This determination is consistent with a previous permit issued on 1/28/91 at 935 N. 1st Street (permit #38213) where an existing structure was replaced by a new structure with no change of use or discontinuance of the existing use.

xc; David Thornton Larry Timm

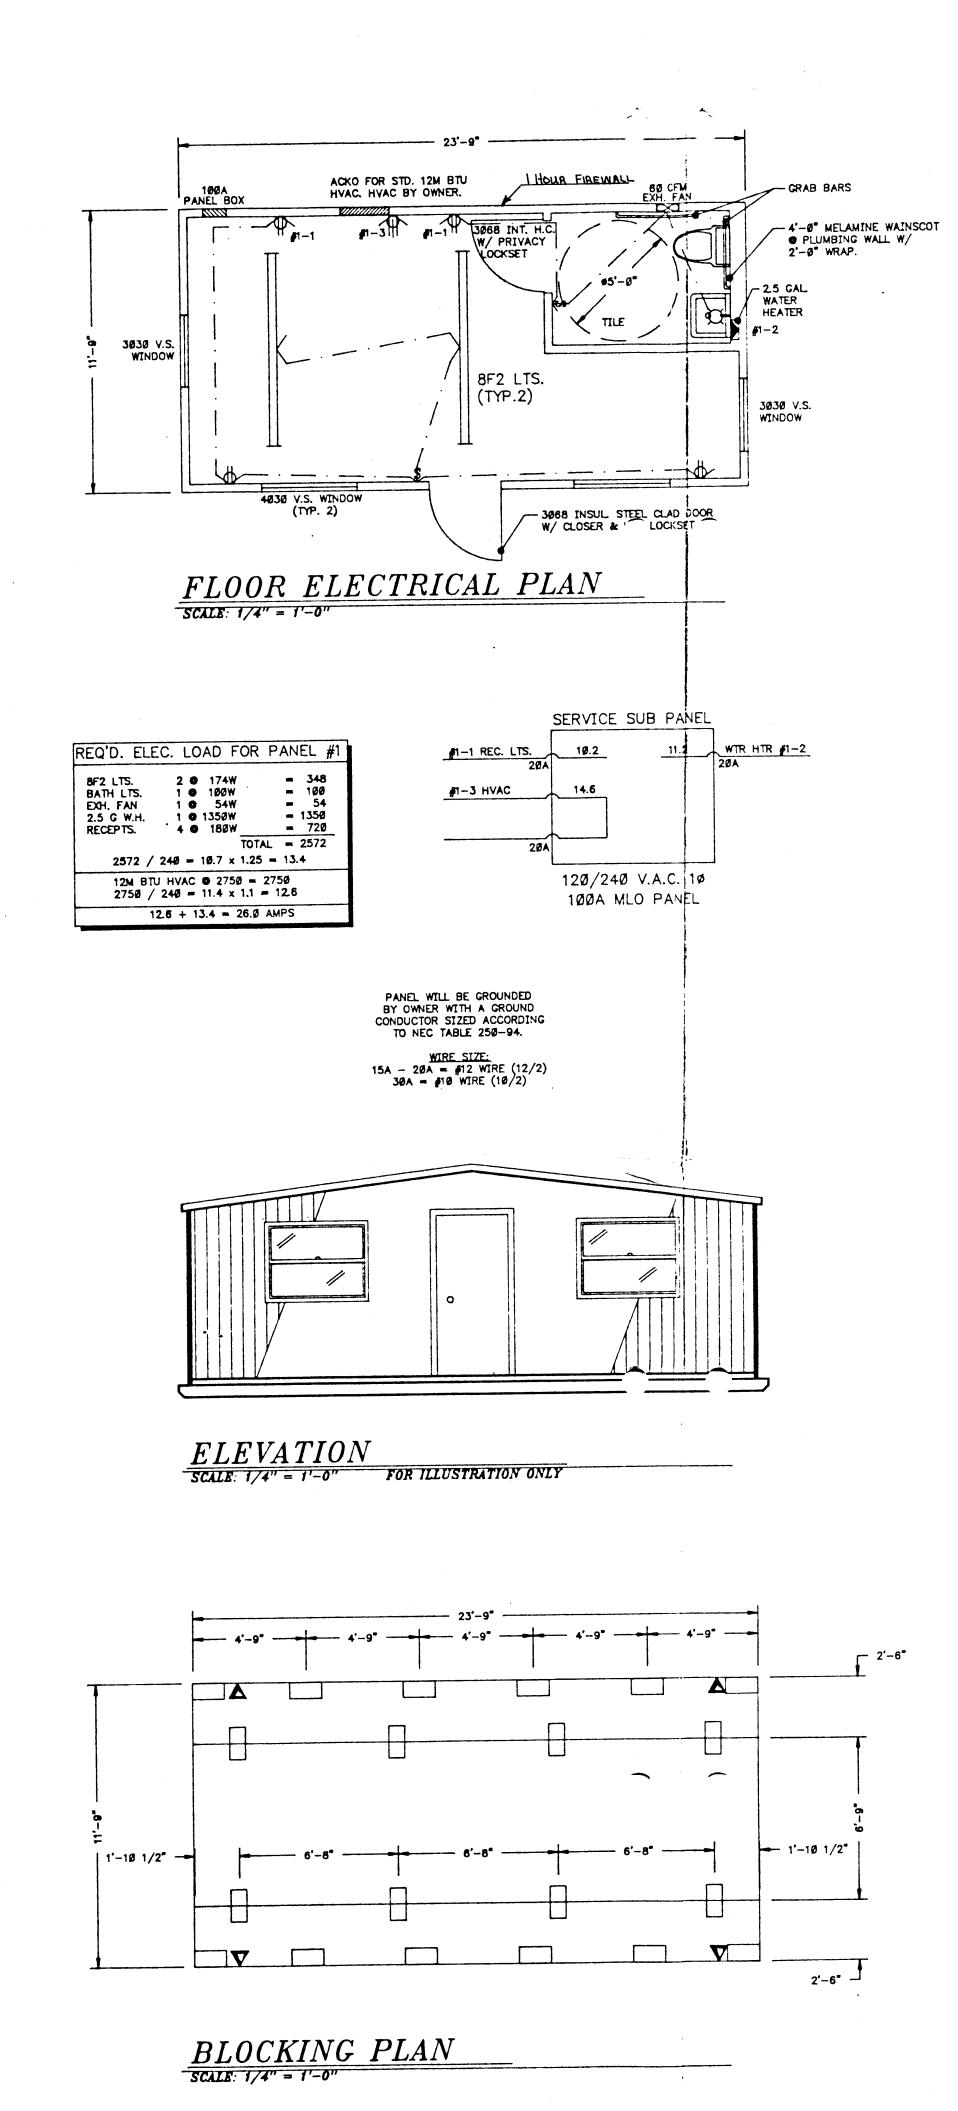

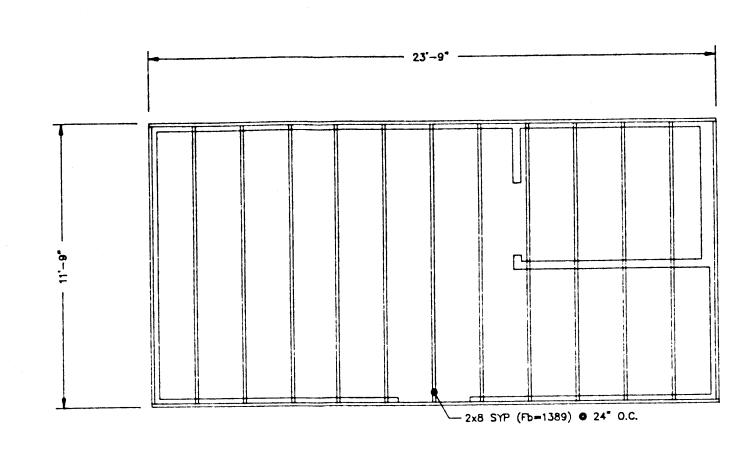


ROOF FRAMING PLAN
SCALE: 1/4" = 1'-0"

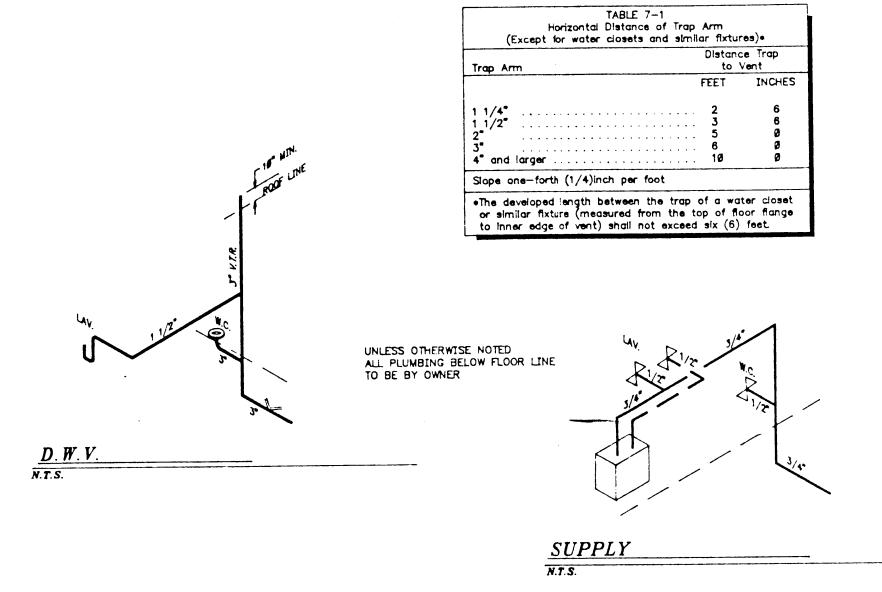



LEGEND

SUGGESTED BLOCKING LOCATION (8" x 8" x 16")

TIE DOWN LOCATION

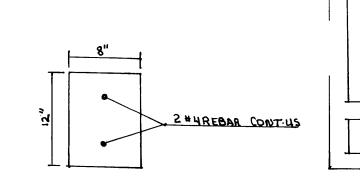

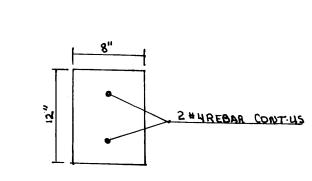

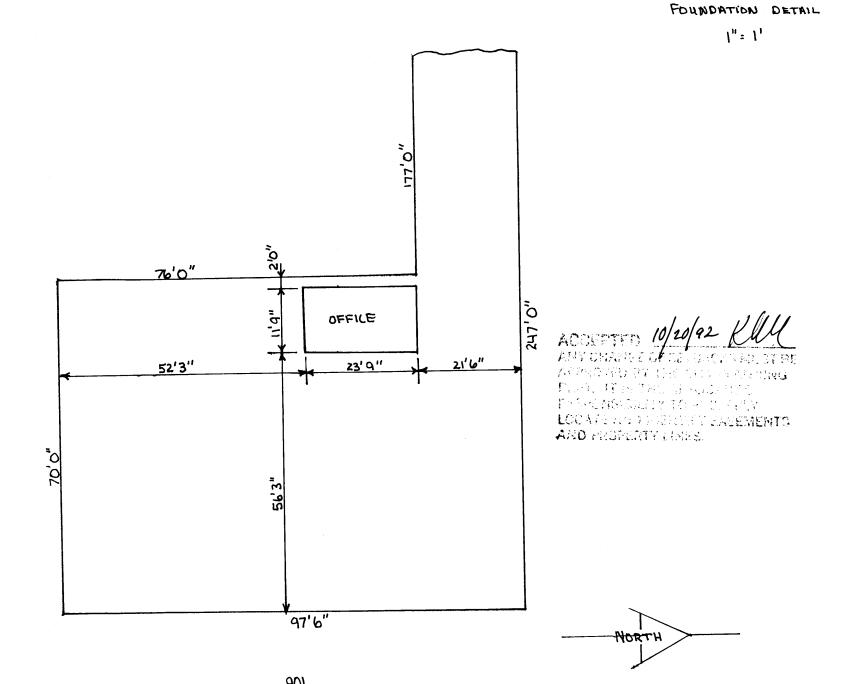

PLOT PLAN 1": 20"

.NORTH FIRST ST.



FLOOR: 2 x 8 Fb=800 joists © 16" o.c. W/ 5/8" plywood Plywood glued to joists. Dbl. Skids & Sidebands ASSEMBLED \* KD \_\_\_\_ FLOOR COVERING: TILE BY MORGAN, CARPET BY OWNER
WALLS: 2 x 4 studs © 16" o.c. W/7-0" nominal stud height
Dbl. Studs & Headers, at Ext. openings & Int. load bearing partitions where applicable
PARTITIONS: 2 x 4 studs © 24" o.c.
SIDING: Material—HARDBOARD
Color—GRAY
Applied—Vert. ROOF: Style- Deluxe Material—Baked on enamel steel

supported by T-bars
INSULATION: R-11 Floor, R-11 Walls,
R-19 Ceiling EXTERIOR TRIM: Baked on Enamel Steel. Color WHITE DOORS: See Plan WINDOWS: See Plan
ELECTRICAL: Copper in conduit
conduit only stubbed thru WALL from panel only for connection by Owner to existing service. ELECTRICAL FIXTURES: See Plan PLUMBING: ABS/PVC-DWV Lines. Type
"L" or "M" copper supply lines. Plumbing
stubbed thru floor only for connection by Owner to existing service.
PLUMBING FIXTURES: See Plan LINING: 1/4" PANELING HVAC: BY OWNER FOUNDATION: By Owner \* Pier Plan By Morgan \_\_\_ Blocking Plan \_\_\_


UNDERPINNING: N/A

CEILING: Class A Finish Ceiling Board

PERMITS: Transportation by Morgan. All others by Owner Morgan is only responsible for work noted on it's own plans & specifications. Any modifications or additions required to comply with governing codes or regulations will be

done at the Owner's Expense.

NOTES: BLOCKS & LEVELING BY MORGAN. FOUNDATION & ANCHORING BY OWNER CARPET BY OWNER TILE BY MORGAN FASTENER SCHEDULE - Q100.01,.02,.03,.04 DOOR/WINDOW HEADERS - B100.03 LUMBÉR SPECS. - B100.04 ELECTRICAL SPECS - H100.01 TYP. PLUMBING FITTING LIST - L103.04 TYP. TIEDOWN INSTALLATION - 1200.06A RECESS CAVITY FOR 2.5 GAL. WTR.HTR. - L103.03 DELUXE WALL SECTION - D309.08
TYP. SPECIFICATIONS FOR "UBC" - B101.02 ATTACHED

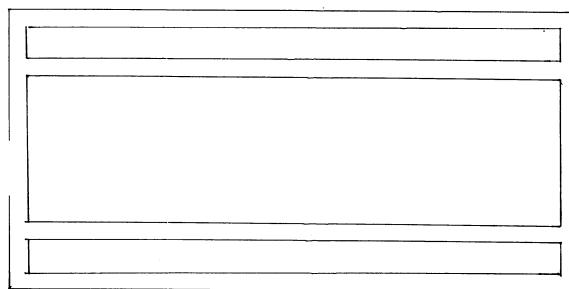

1/4"=1,

DESIGN CRI	TERIA
BUILDING CODE LEC	-86 EL-0
OCCUPANCY CLASSIFICONSTRUCTION TYPE OCCUPANT LOAD	CATION B
DESIGN LO	ADS
ROOF DEAD LOAD ROOF LIVE LOAD FLOOR DEAD LOAD FLOOR LIVE LOAD WIND SEISMIC ZONE EXPRENCE	O PSF 30 PSF 10 PSF 50 PSF 80 MPH

ALL MOF	RGAN'S SALES CON	ONDITIONS STATED OF NTRACT FORM ARE MADE NS AND SPECIFICATIONS	E   Wa	rgan Buil	ding Syste	ms, Inc		Morg
	SWITCH	NINY PANEL BCX	PEV	BY	DATE	AEV	۵v	DATE
ė	110 V DUPLEX OUTLET	KNOCK OUT	1	<del> </del>		1	1	
ŏ	WALL MOUNTED FIXTURE	EXHAUST FAN		<del> </del>				
ë"	220 V OUTLET	THE HEATER					1	
$\stackrel{\bullet}{\circ}$	CLG MOUNTED FIXTURE	OVERHEAD		İ		į	,	
$\leq$	FLUORESCENT FIXTURE	JOINLINE	TITLE	5.00=	EFC	2.6	PA	N 51 61
<b>©</b>	ELEC SERVICE (NOM 8)	THE FLAT TOP PARTITION	122	POOR ELECTRICAL PAN ELEV				
Ď	TELEPHONE BOX	INSULATED PARTITION	<b>4006</b>	L MO. J	4 5	0 7		10 11
1	(STUBBED THRU FLOOR)	TYP TYPICAL	1	22	4		1	12 0
d7	PIERLOCATION		7440	HASER CA	YEAR		7 A	
PROPE	RIETARY INFORMATION - THIS	DRAWING IS THE PROPERTY OF MORGA OT BE TRACED, COPIED OR REPRODUCE	N			ء اسا ح		•