| DATE SUBMITTED: 6/10/92 | | PERMIT NO. |
|---|--|--|
| : | | FEE \$ 10 00 424 |
| PL GRAND JUNCI | ANNING CLEARAN | |
| LDG ADDRESS <u>568</u> | <u>5 2 Rd</u> sq. ft. of | BLDG: |
| UBDIVISION | | LOT: |
| ILING # $N/ABLK # N/A$ | LOT # N/A NO. OF FAM | MILY UNITS: |
| AX SCHEDULE # | -00-929 NO. OF BU | UILDINGS ON PARCEL BEFORE THIS CONSTRUCTION: |
| OWNER MONUMENT Lit | the heagur use of ex | LISTING BUILDINGS: |
| DDRESS POBOV 716 | GRANDSCH | COSILON STAND |
| ELEPHONE: 243-76/8 | DESCRIPTIO | ON OF WORK AND INTENDED USE: |
| EQUIRED: Two plot plans showing parking | ng, landscaping, setbacks to all prope | erty lines, and all streets which abut the parcel. |
| *********************************** | ***************************** | ************** |
| 71 | FOR OFFICE USE ONLY | |
| one <u>P</u> 2 | FLOODPLAIN: | YES NO |
| TBACKS: FRONT <u>20</u> | GEOLOGIC HAZAF | RD: YES NO |
| DE <u>/0</u> REAR <u>/0</u> | CENSUS TRACT: | $-\frac{4}{2}$ traffic zone: $-\frac{12}{2}$ |
| AXIMUM HEIGHT <u>40</u> | PARKING REQ'MT | NA |
| | | • |
| ANDSCAPING/SCREENING REQUIRE | | |
| and scaping/screening require \mathcal{N}/\mathcal{A} | | |

Building Code).


Any landscaping required by this permit shall be maintained in an acceptable and healthy condition. The replacement of any vegetation materials that die or are in an unhealthy condition shall be required.

I hereby acknowledge that I have read this application and the above is correct, and I agree to comply with the requirements above. Failure to comply shall result in legal action.

oval 6 Date Approved

Ø 52 **Applicant Signature**

VALID FOR SIX MONTHS FROM DATE OF ISSUANCE (Section 9-3-2 D Grand Junction Zoning & Development Code)

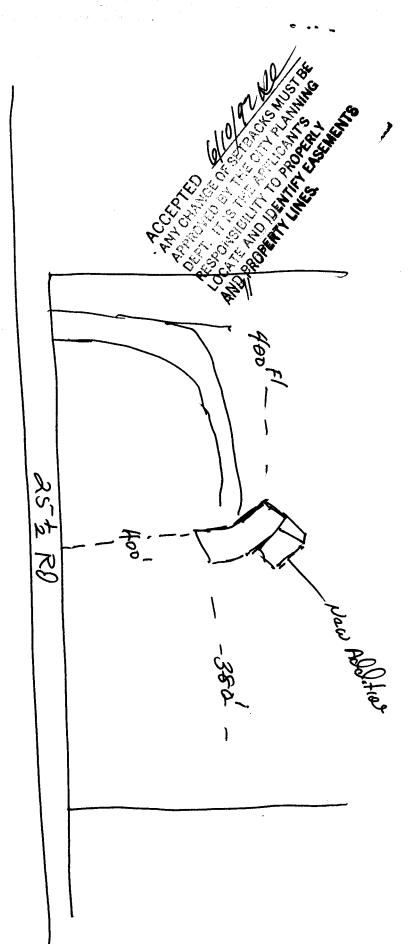

---.