DATE SUBMITTED: 3-24-92	PERMIT NO. 41419
	FEE \$ <u>5.00</u>
	ING CLEARANCE
BLDG ADDRESS 102 EAST PARK AVE	SQ. FT. OF BLDG: $\frac{24'}{X}\frac{28'}{28}$
SUBDIVISION MANTEY HEIGHTS	SQ. FT. OF LOT:
FILING # BLK # LOT # _	35NO. OF FAMILY UNITS:/
TAX SCHEDULE #2943-072-02-0	NO. OF BUILDINGS ON PARCEL BEFORE THIS PLANNED CONSTRUCTION:/
OWNER <u>LICHARD</u> FOREMAN	USE OF EXISTING BUILDINGS:
ADDRESS 102 E PARLAVE 8150	
TELEPHONE:242-3686	DESCRIPTION OF WORK AND INTENDED USE:
	caping, setbacks to all property lines, and all streets which abut the parcel
	DR OFFICE USE ONLY
ZONE RSF-5	FLOODPLAIN: YES NO
	FLOODPLAIN: YES NO GEOLOGIC HAZARD: YES NO
SETBACKS: FRONT 20'	
SETBACKS: FRONT 20' Mar Nal of Marine Side <u>3</u> Rear 10	GEOLOGIC HAZARD: YES NO
SETBACKS: FRONT 20' Max Malf of Deputy SIDE <u>3</u> REAR 10 MAXIMUM HEIGHT	GEOLOGIC HAZARD: YES NO CENSUS TRACT: TRAFFIC ZONE: $\frac{28}{28}$
ZONE	GEOLOGIC HAZARD: YES NO CENSUS TRACT: TRAFFIC ZONE: PARKING REQ'MT

Carefornia and the

and the second second


Modifications to this Planning Clearance must be approved, in writing, by this Department. The structure approved by this application cannot be occupied until a Certificate of Occupancy is issued by the Building Department (Section 307, Uniform Building Code).

Any landscaping required by this permit shall be maintained in an acceptable and healthy condition. The replacement of any vegetation materials that die or are in an unhealthy condition shall be required.

I hereby acknowledge that I have read this application and the above is correct, and I agree to comply with the requirements above. Failure to comply shall result in legal action.

rema Approval **Applicant Signature** 3-24-Date **Date Approved**

VALID FOR SIX MONTHS FROM DATE OF ISSUANCE (Section 9-3-2 D Grand Junction Zoning & Development Code)

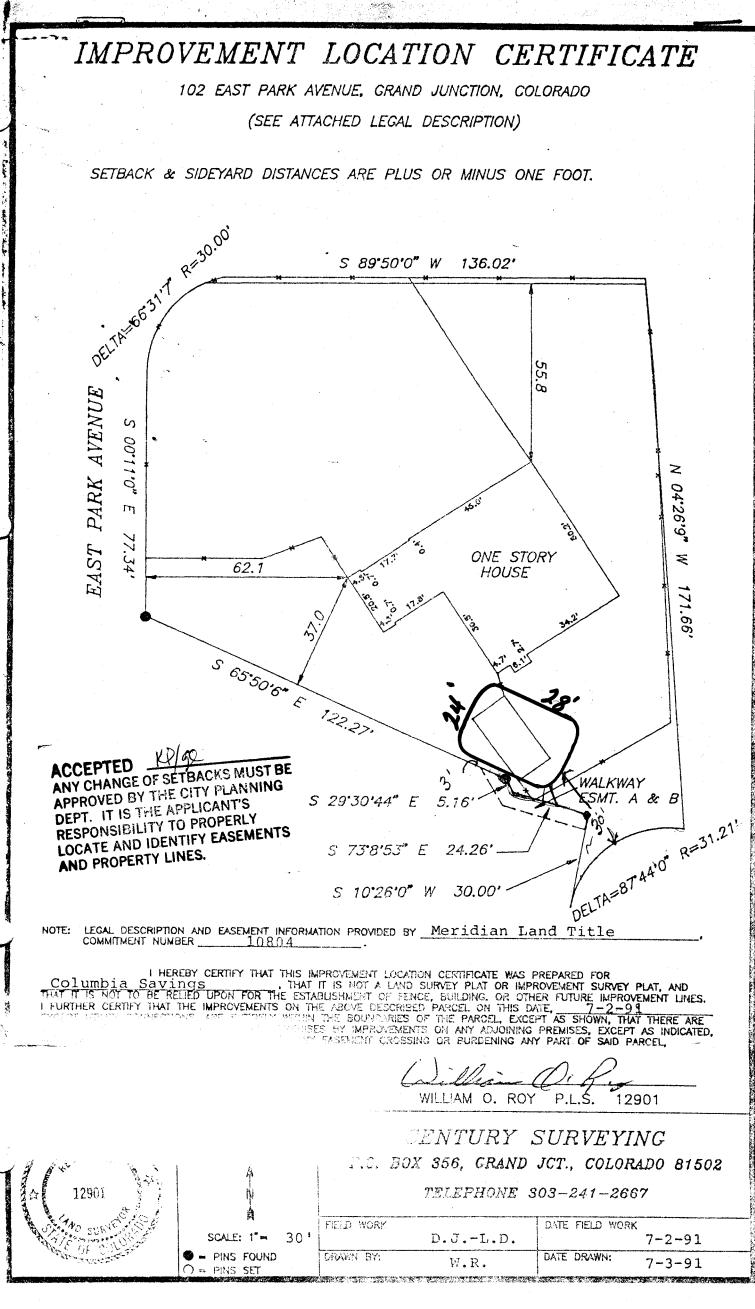

اند. مراجع المراجع Commencing at the found Mesa County Survey Marker #36 set for the Northwest corner of said Section 7, and condidering the Northerly boundary line of said Section 7 to bear N89 50'E, with all bearings herein being relative between said found Mesa County Survey Marker #36 and found Mesa County Survey Marker #1340 set for the Northeast corner of the NW4NW4 of said Section 7, as the basis of bearings:

41

basis of bearings: Thence along the Northerly boundary line of said Section 7 N89°50'E, 372.70 feet; thence S00°10'E, 30.0 feet to the True Point of Beginning, said point also being the Northeast corner of a tract of land as described in Ecok 1503, Page 980 and recorded in the office of the Mesa County Clerk and Recorder; thence S04°26'09"E, 2.01 feet; thence S89°50'W, 134.80 feet to the intersection of a curve; thence Northeasterly, 11.02 feet along the arc of said curve deflecting to the right, having a radius of 30 feet, through a central angle of 21°02'22", and a chord that bears N79°19'49"E, 10.95 feet; thence N89°50'E, 123.88 feet along the Southerly right of way line of the present F Road as described in Plat Book 7, Page 26A and recorded in the above said office, to the True Point of Beginning,

All in Mesa County, Colorado.

Page <u>1</u> CONTINUATION Commitment