


Prop. Line on N. Side of Ditch
Prop. Line on N. Side of Ditch

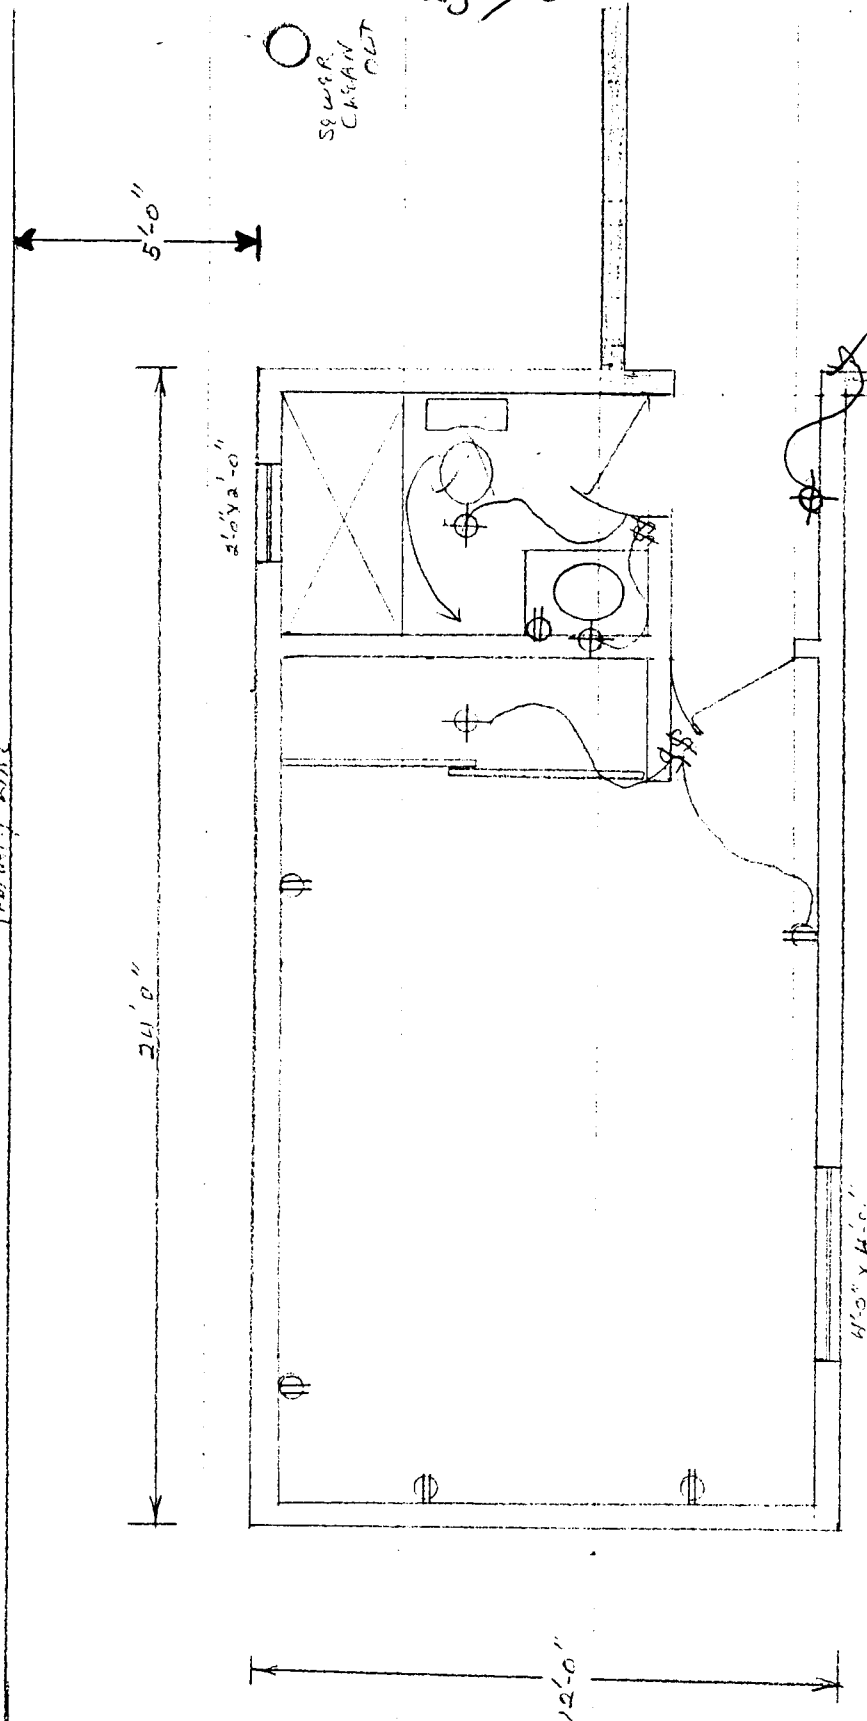

RSK

ACCEPTED FOR RECORD BY THE
ANY WORK DONE BY THE
APPROVED BY THE
DEPT. OF PUBLIC WORKS
RESPONDING TO PROPERTY
LOCATE AND PROPERTY LINES
AND PROPERTY LINES.

SCALE 1/4" = 1'-0"

P.O.W. ↑

105