

DATE SUBMITTED: 5-3-93

PERMIT NO. 44856 ✓

FEE \$ 5.00

PLANNING CLEARANCE

GRAND JUNCTION COMMUNITY DEVELOPMENT DEPARTMENT

BLDG ADDRESS 702 E. HAROLD CIRCLE SO. FC. OF BLDG: _____

SUBDIVISION THE "COVE" AT FOUNTAIN HEAD FT. OF LOT: 1800+

FILING # 1 BLK # _____ LOT # 9 NO. OF FAMILY UNITS: 1

TAX SCHEDULE # 2701 33404008 NO. OF BUILDINGS ON PARCEL BEFORE THIS PLANNED CONSTRUCTION: 0

OWNER BILL NERTZOG USE OF EXISTING BUILDINGS: N/A

ADDRESS 527 KANSAS

TELEPHONE: 241-7554 DESCRIPTION OF WORK AND INTENDED USE: RESIDENTIAL CONSTRUCTION

REQUIRED: Two plot plans showing parking, landscaping, setbacks to all property lines, and all streets which abut the parcel.

FOR OFFICE USE ONLY

ZONE RR Designated FLOODPLAIN: YES _____ NO

SETBACKS: FRONT 20' JCS GEOLOGIC HAZARD: YES _____ NO

SIDE 5 1/2' REAR 1 CENSUS TRACT: 9 TRAFFIC ZONE: 4

MAXIMUM HEIGHT _____ PARKING REQ'MT 2

LANDSCAPING/SCREENING REQUIRED: _____ SPECIAL CONDITIONS: _____

Modifications to this Planning Clearance must be approved, in writing, by this Department. The structure approved by this application cannot be occupied until a Certificate of Occupancy is issued by the Building Department (Section 307, Uniform Building Code).

Any landscaping required by this permit shall be maintained in an acceptable and healthy condition. The replacement of any vegetation materials that die or are in an unhealthy condition shall be required.

I hereby acknowledge that I have read this application and the above is correct, and I agree to comply with the requirements above. Failure to comply shall result in legal action.

M. Pitey
Department Approval

FOUNTAIN HEAD DEVELOPMENT CORPORATION
Applicant Signature

5-3-93
Date Approved

4/26/93
Date

VALID FOR SIX MONTHS FROM DATE OF ISSUANCE (Section 9-3-2 D Grand Junction Zoning & Development Code)

N00°11'29" W

HARBOR

EAST

50.00'

N00°11'29"W

70.00'

70.00'

S89°48'31"W

85.00'

5' UTIL. ESMT.

LOT 10

ACCEPTED 5-3-13
ANY CHANGE OF SETBACKS MUST BE APPROVED BY THE CITY PLANNING DEPT. IT IS THE APPLICANT'S RESPONSIBILITY TO PROPERLY LOCATE AND IDENTIFY EASEMENTS AND PROPERTY LINES.

N89°48'31"E


70.00'

70.00'

N00°11'29"W

548.89'

50'

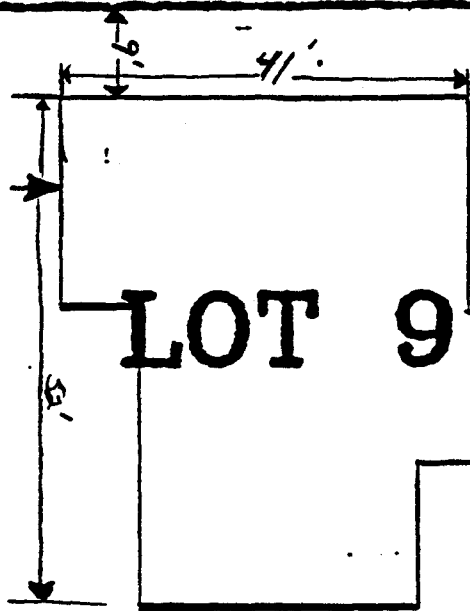

LOT 9

70.00'

85.00'

6.83'

S00°11'29"E

EXISTING RIGHT-OF-WAY