


Driveway Location Ok
 J. Don Newton 4-21-96
 124 Santa Fe Drive

Revised *Ronnie* 5/9/96

ACCEPTED
 ANY CHANGE OF SETBACKS MUST BE APPROVED BY THE CITY PLANNING DEPT. IT IS THE APPLICANT'S RESPONSIBILITY TO PROPERLY LOCATE AND IDENTIFY EASEMENTS AND PROPERTY LINES.

N
 A
 L
 P

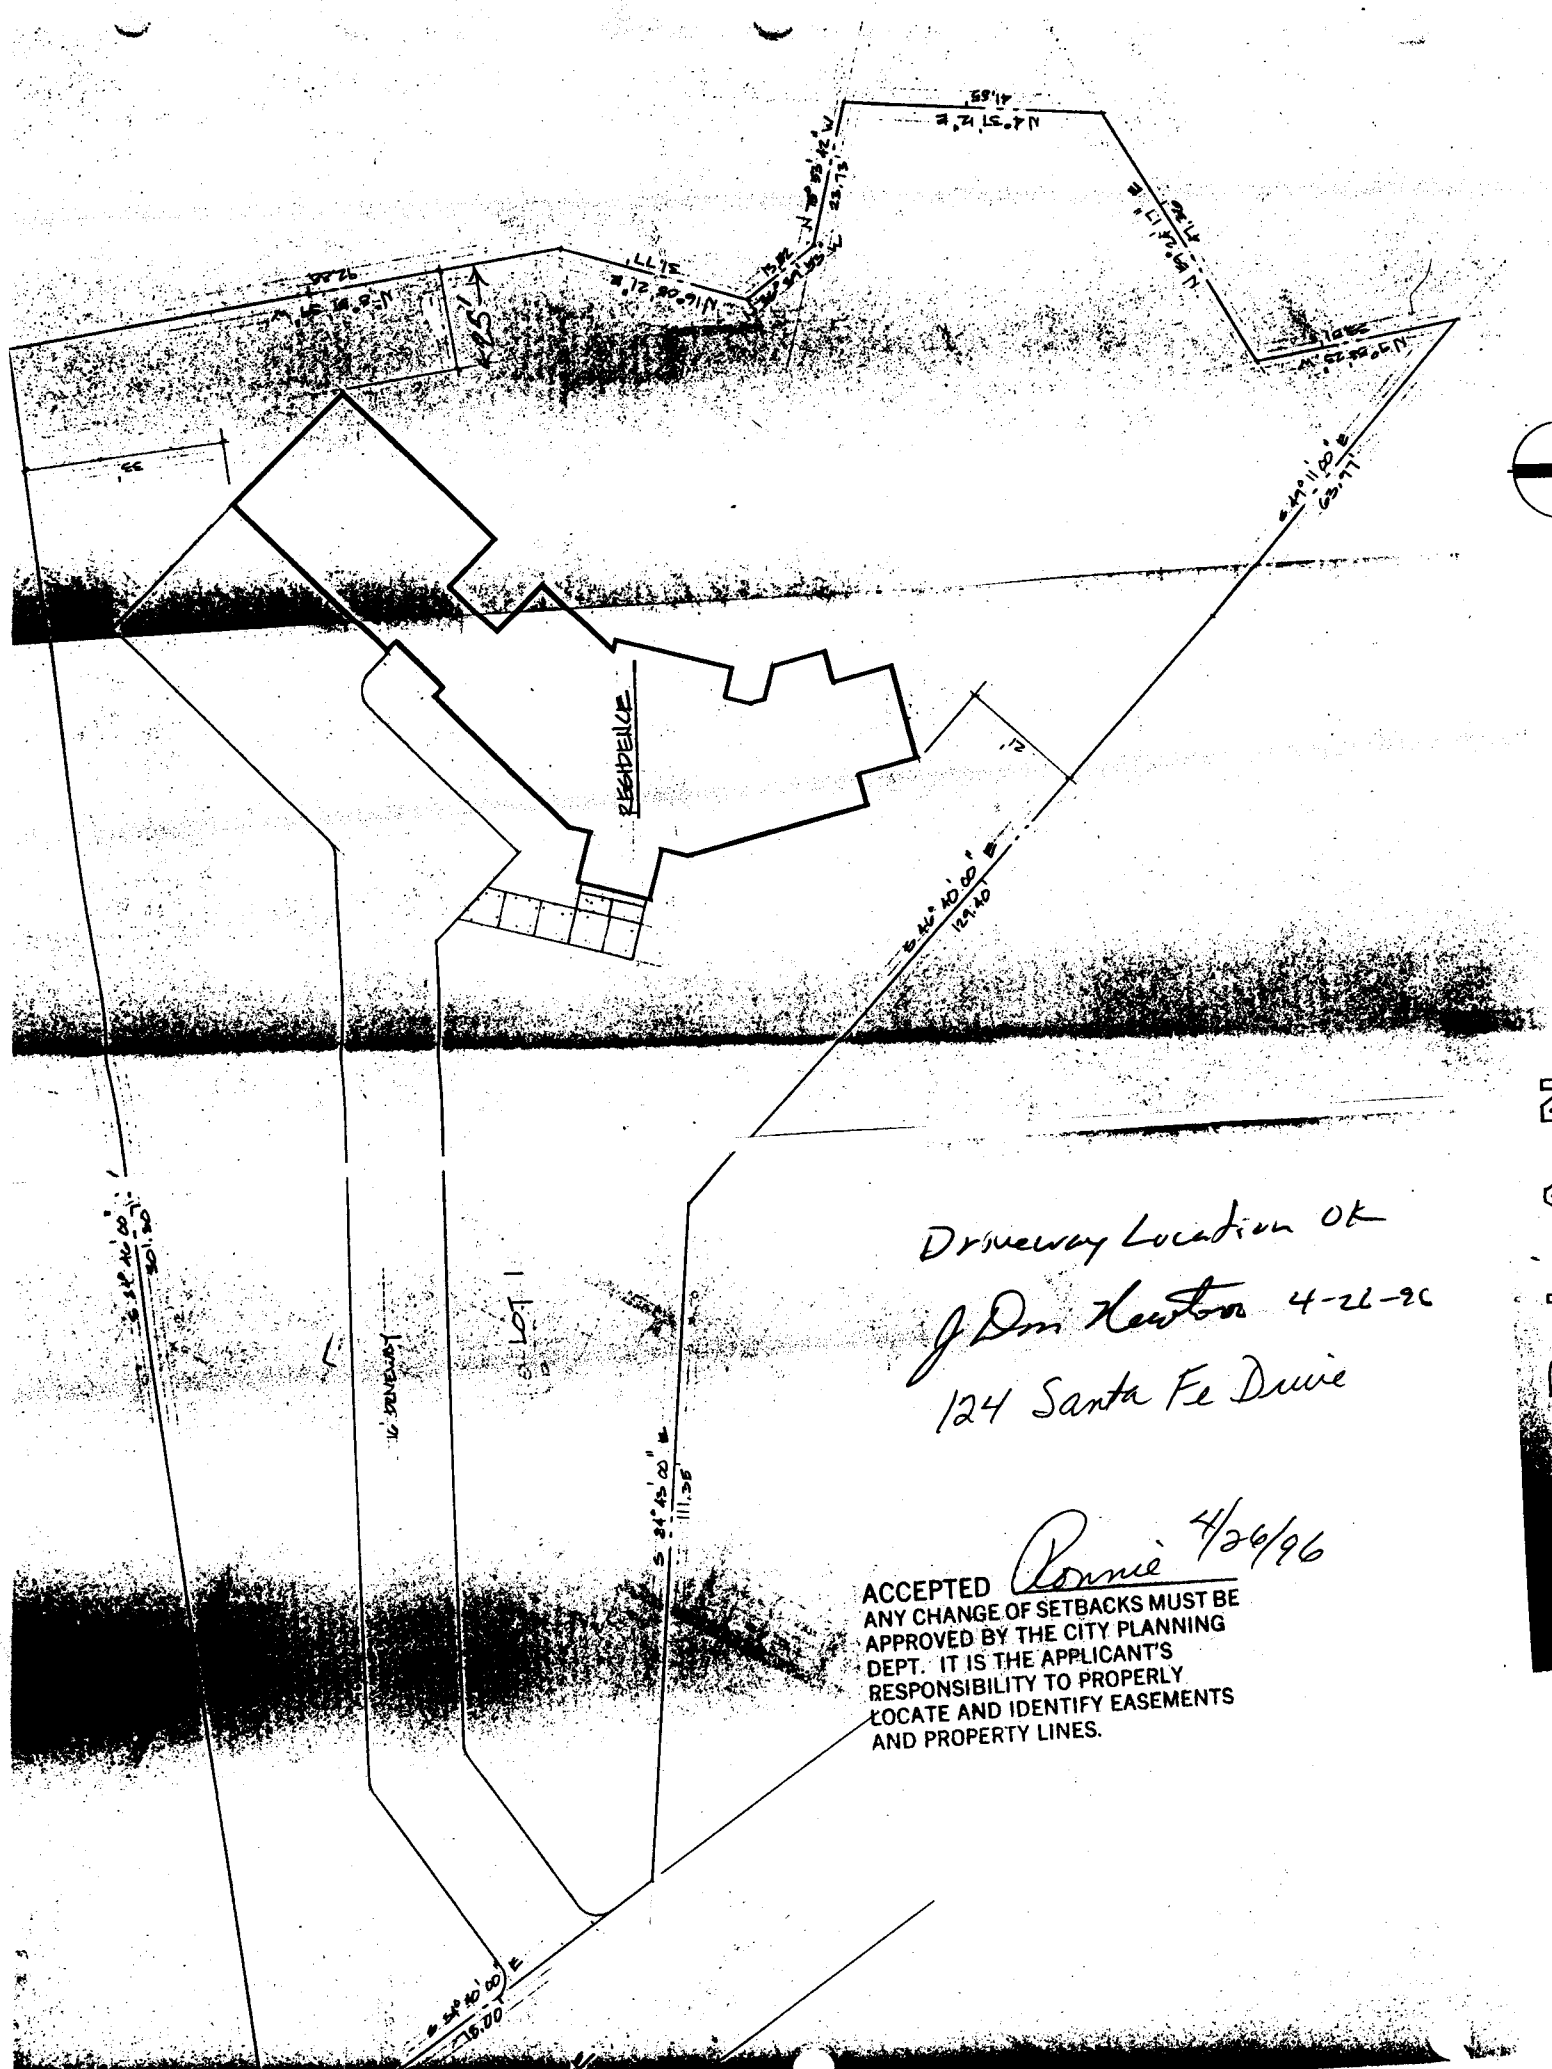

Driveway Location OK
J. Don Newton 4-26-96
124 Santa Fe Drive

ACCEPTED *Ronnie* 4/26/96
ANY CHANGE OF SETBACKS MUST BE APPROVED BY THE CITY PLANNING DEPT. IT IS THE APPLICANT'S RESPONSIBILITY TO PROPERLY LOCATE AND IDENTIFY EASEMENTS AND PROPERTY LINES.

N
A
L
P
L