


ANY OF THE ABOVE INFORMATION THE APPLICANT FAILS TO SHOW ON THE DRAWING WILL RESULT IN A DELAY OF OBTAINING THE DEVELOPMENT CLEARANCE.

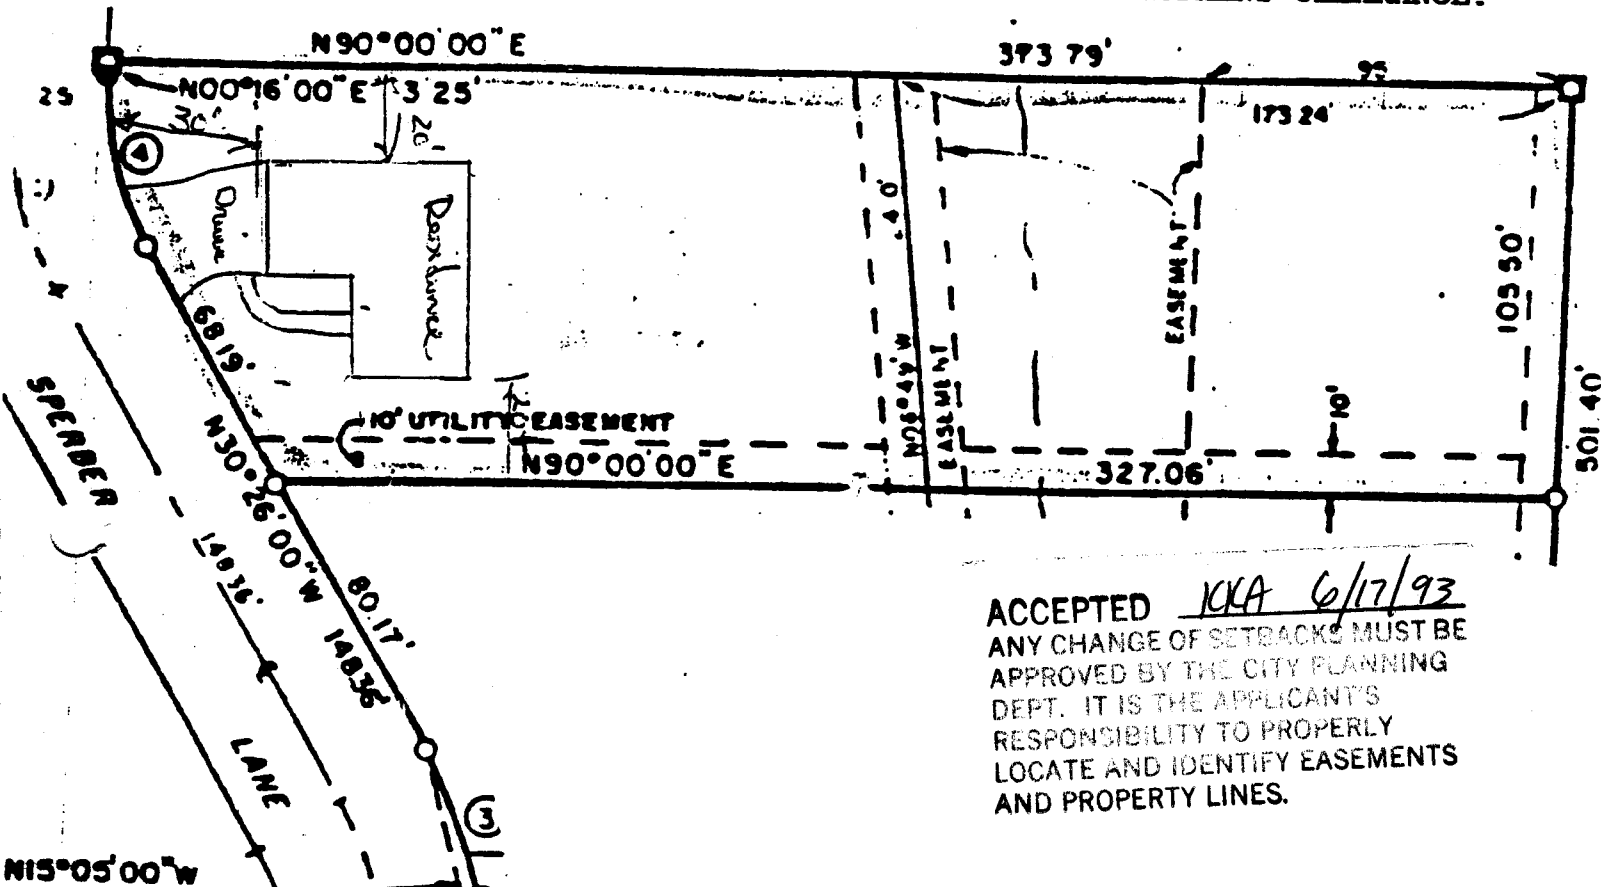

ACCEPTED KKA 6/17/93
 ANY CHANGE OF SETBACKS MUST BE APPROVED BY THE CITY PLANNING DEPT. IT IS THE APPLICANT'S RESPONSIBILITY TO PROPERLY LOCATE AND IDENTIFY EASEMENTS AND PROPERTY LINES.

BY SIGNING BELOW, THE APPLICANT ACCEPTS THE RESPONSIBILITY TO PROPERLY LOCATE AND IDENTIFY ALL EASEMENTS, PROPERTY LINES, EXISTING AND PROPOSED STRUCTURES. IT IS FURTHER UNDERSTOOD THAT ANY CHANGE OF SETBACKS MUST BE APPROVED, IN WRITING BY THE PLANNING DIVISION.

APPLICANT'S SIGNATURE: *Conrad B. McLaughlin* DATE: 6-11-93

APPROVED BY: _____ DATE: _____
 PLANNING DIVISION STAFF