FEE \$ 500

BLDG PERMIT NO.


PLANNING CLEARANCE

(Single Family Residential and Accessory Structures)

Grand Junction Community Development Department

☞ THIS SECTION TO BE COMPLETED BY APPLICANT ®

	and a well	0000
	BLDG ADDRESS 2740 N 1545	TAX SCHEDULE NO. $2945 - 013 - 00 - 063$
	SUBDIVISION	SQ. FT. OF PROPOSED BLDG(S)/ADDITION 1400 10
	FILING BLK LOT	SQ. FT. OF EXISTING BLDG(S)
	1) OWNER <u>Mancy Rissner</u>	NO. OF DWELLING UNITS
	(1) ADDRESS 336 Main St	BEFORE: AFTER: THIS CONSTRUCTION
•	(1) TELEPHONE 241- 2801	NO. OF BLDGS ON PARCEL BEFORE: AFTER: THIS CONSTRUCTION
) }	(2) APPLICANT Touchstene Homes	USE OF EXISTING BLDGS New residence
2	(2) ADDRESS 336 main St	DESCRIPTION OF WORK AND INTENDED USE:
,	(2) TELEPHONE 241. 280]	new residence
}	REQUIRED: Two (2) plot plans, on 8 1/2" x 11"-paper, setbacks to all property lines, ingress/egress to the pro	, showing all existing and proposed structure location(s), parking, perty, and all easements and rights-of-way which about the parcel.
	THIS SECTION TO BE COMPLETED BY COMMUNITY DEVELOPMENT DEPARTMENT STAFF ZONE SETBACKS: Front	
_		
	Maximum Height	census tract 10 traffic zone 21
	Modifications to this Planning Clearance must be approved, in writing, by the Director of the Community Development	
Department. The structure authorized by this application cannot be occupied until a final inspection has and a Certificate of Occupancy has been issued by the Building Department (Section 305, Uniform B		· · · · · · · · · · · · · · · · · · ·
	I hereby acknowledge that I have read this application and the information is correct; I agree to comply with any and	
all codes, ordinances, laws, regulations or restrictions which apply to the project. I understand that failure to cor result in legal action, which may include but not necessarily be limited to non-use of the building(s).		
	Applicant Signature They I how	Date 5/31/94
	Department Approval Konnie Elwan	Date 5/31/94
Additional water and/or_sewer tarp fee(s) Afre required: YES X NO W/O No. 7660		
	Utility Accounting (Ala Macha)	Date 3/3//79
	VALID FOR SIX MONTHS FROM DATE OF ISSUANCE	CE (Section 9-3-2D Grand Junction Zoning & Development Code)
	(White: Planning) (Yellow: Customer) (F	Pink: Building Department) (Goldenrod: Utility Accounting)

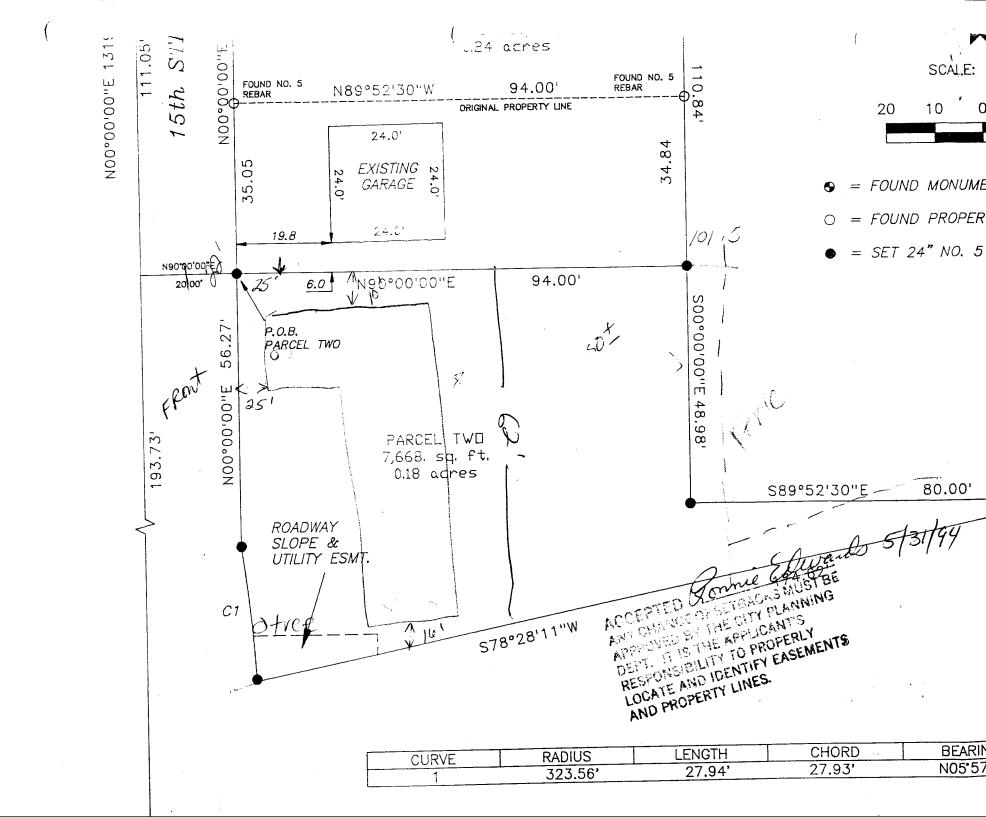

GRAND VALLEY WATER USERS ASSOCIATION

GRAND VALLEY PROJECT, COLORADO

500 South Tenth Street (303) 242-5065 FAX (303) 243-4871 GRAND JUNCTION, COLORADO 81501-3740

June 21, 1994

Steve Thompson Touchstone Homes 336 Main Grand Junction, CO 81501

> RE: House Construction and right-of-way along Grand Valley Water Users Association ("Association") drainage ditch ("ditch") at 2740 North 15th Street Grand Junction, CO 81501

Dear Mr. Thompson:

As per our discussion concerning the location of a house to be built adjacent to the ditch at 2740 North 15th Street, the Association has an undescribed right-of-way along this ditch for its operation and maintenance.

In view of your plans to construct a house on this particular lot at said address, we have agreed with you that at least 10 feet extending northward from the top of the north ditchbank is to be left for ditch operation and maintenance and that this 10 feet is to be evidenced by a straight line starting at a point on the lot's east boundary located South 00% 00'00" East 83.82 feet from the Northeast corner of the lot, and this line is to proceed westerly parallel to the ditch until it intersects the sidewalk at North 15th Street.

The buyers of this property and their successors need to be notified of this operation and maintenance right-of-way and of the fact that the Association will make use of the easement as needed for operation and maintenance of the ditch.

Sincerely,

Dick Proctor, Asst. Manager

Dick Proctor