
DATE SUBMITTED 3/4/194	BUILDING PERMIT NO. N/H
	FEE \$ # Madee
PLANNING CLEARANCE (Major site plan review, multi-family development, non-residential development, interior remodels) Grand Junction Department of Community Development	
BLDG ADDRESS <u>BBO GLINNISON</u> SUBDIVISION <u>G 44 of M-J.</u> FILING BLK <u>42</u> LOT <u>BIK</u>	SQ. FT. OF PROPOSED BLDG(S)/ADDITION
OWNER MEGA CLITY VALLEY SCHOOL	NO. OF BLDGS ON PARCEL BEFORE THIS CONSTRUCTION
ADDRESS ZILS GRAND ALE	USE OF EXISTING BLDGS EDUCATION
TELEPHONE ZAS-ZAZZX ITE	ATHLETIC FACILITY BACKETBALL CPTS
Submittal requirements are outlined in the SSID (Subr	IO' High Chain Unic Bence nittal Standards for Improvements and Development) document.
ZONE <u>IZ</u>	DESIGNATED FLOODPLAIN: YES NO
SETBACKS: Front from property line or from center of ROW, whichever is greater	GEOLOGIC HAZARD: YES NO
Side from property line	CENSUS TRACT TRAFFIC ZONE
Rear from property line	Parking Req'mt <u>lttisfung</u>
Maximum Height651	
Maximum coverage of lot by structures	Special Conditions:
Landscaping/Screening Req'd Misting	
Modifications to this Planning Clearance must be approved, in writing, by this Department. The structure approved by this application cannot be occupied until a Certificate of Occupancy is issued by the Building Department (Section 307, Uniform Building Code). Required improvements in the public right-of-way must be guaranteed prior to issuance of a Planning Clearance. All other required site improvements must be completed or guaranteed prior to issuance of a Certificate of Occupancy. Any landscaping required by this permit shall be maintained in an acceptable and healthy condition. The replacement of any vegetation materials that die or are in an unhealthy condition shall be required.	
Four (4) sets of final construction drawings must be submitted and stamped by City Engineering prior to issuing the Planning Clearance. One stamped set must be available on the job site at all times.	
I hereby acknowledge that I have read this application and the above is correct, and I agree to comply with the requirements above. Failure to comply shall result in legal action.	
	Date 3/4/94
VALID FOR SIX MONTHS FROM DATE OF ISSUANCE (Section 9-3-21) Grand Junction Zoning & Development Code)	
	Customer) (Pink: Building Department)

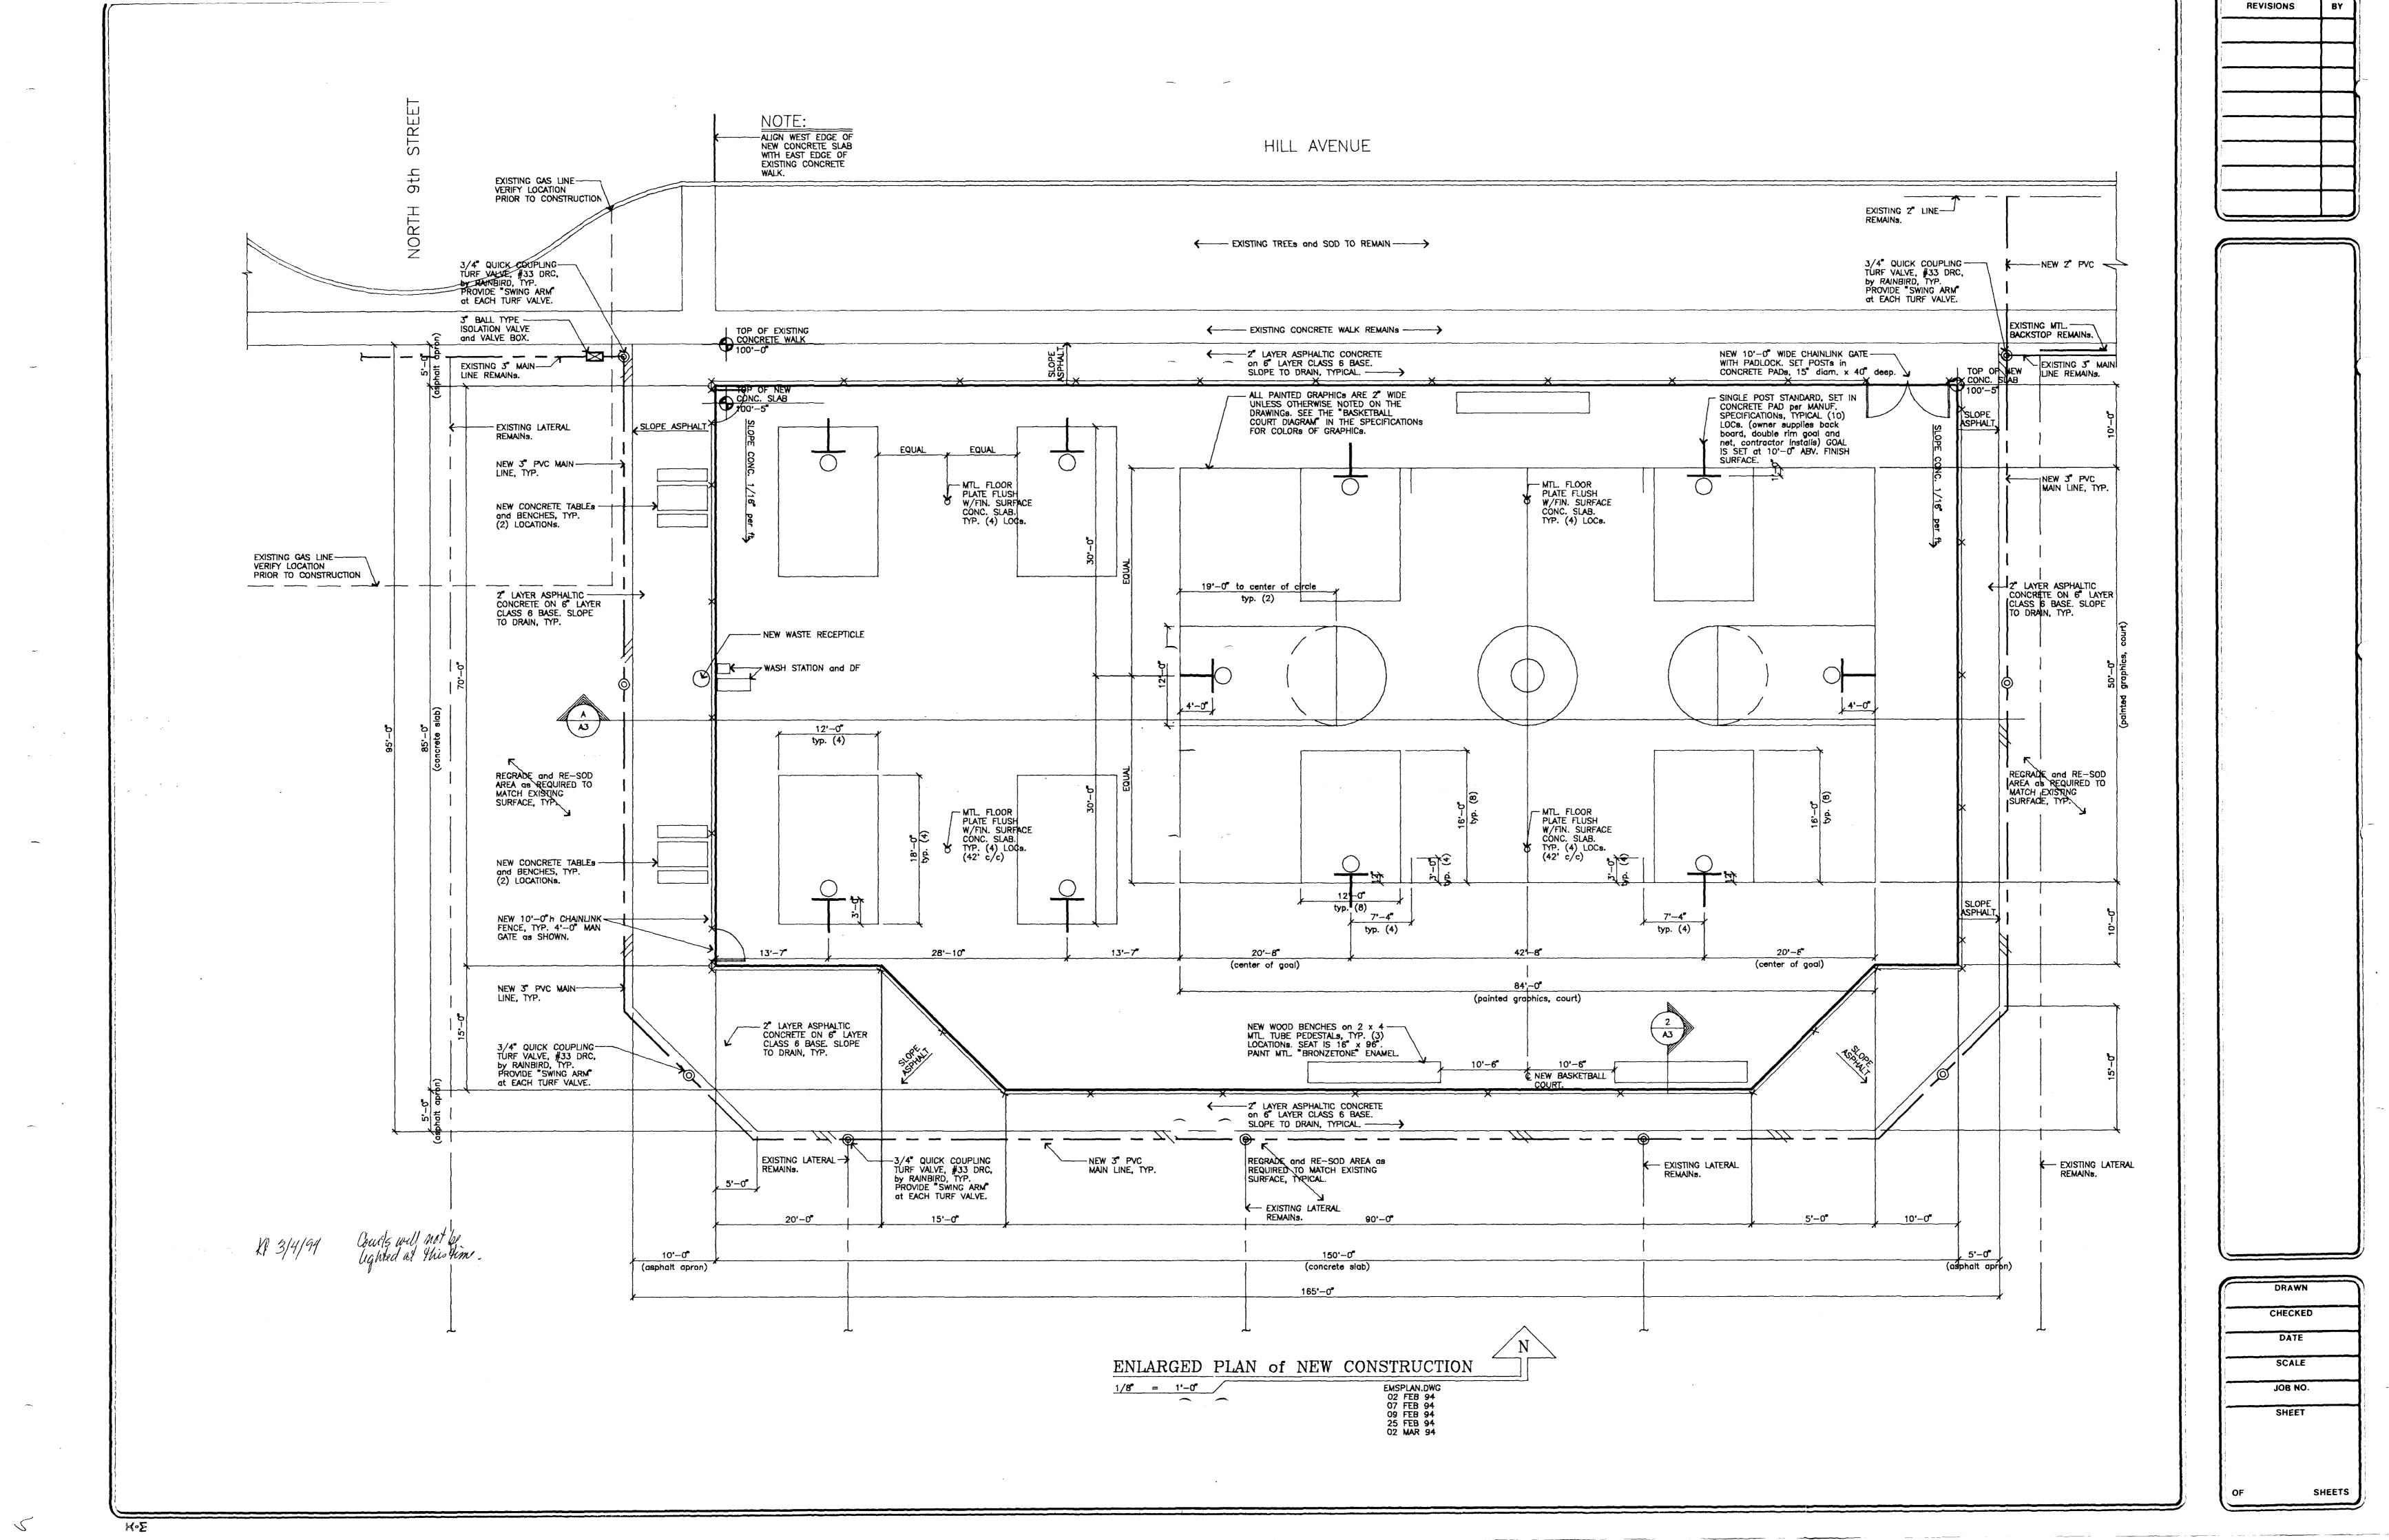

-.

> . • • 7 9 4...