

FEE \$ 500

BLDG PERMIT NO. 49148

PLANNING CLEARANCE
(Single Family Residential and Accessory Structures)
Grand Junction Community Development Department

THIS SECTION TO BE COMPLETED BY APPLICANT

BLDG ADDRESS 815 MAZATIAN TAX SCHEDULE NO. 2701-264-24-009
 SUBDIVISION Paradise Hills SQ. FT. OF PROPOSED BLDG(S)/ADDITION 14122
 FILING 6 BLK 3 LOT 9 SQ. FT. OF EXISTING BLDG(S) 2500
 (1) OWNER DENNIS L. GRANNA NO. OF DWELLING UNITS
 BEFORE: 1 AFTER: 1 THIS CONSTRUCTION
 (1) ADDRESS 815 MAZATIAN
 (1) TELEPHONE 243 4896 NO. OF BLDGS ON PARCEL
 BEFORE: 1 AFTER: 2 THIS CONSTRUCTION
 (2) APPLICANT Same USE OF EXISTING BLDGS Residence
 (2) ADDRESS _____ DESCRIPTION OF WORK AND INTENDED USE: _____
 (2) TELEPHONE _____ Storage Bldg.

REQUIRED: Two (2) plot plans, on 8 1/2" x 11" paper, showing all existing and proposed structure location(s), parking, setbacks to all property lines, ingress/egress to the property, and all easements and rights-of-way which abut the parcel.

THIS SECTION TO BE COMPLETED BY COMMUNITY DEVELOPMENT DEPARTMENT STAFF

ZONE RSF-4 Maximum coverage of lot by structures 35%
 SETBACKS: Front 20' from property line (PL) or
45' from center of ROW, whichever is greater Parking Req'mt _____
 Side 3' from PL Rear 10' from PL Special Conditions _____
 Maximum Height 32' CENSUS TRACT 16 TRAFFIC ZONE 13

Modifications to this Planning Clearance must be approved, in writing, by the Director of the Community Development Department. The structure authorized by this application cannot be occupied until a final inspection has been completed and a Certificate of Occupancy has been issued by the Building Department (Section 305, Uniform Building Code).

I hereby acknowledge that I have read this application and the information is correct; I agree to comply with any and all codes, ordinances, laws, regulations or restrictions which apply to the project. I understand that failure to comply shall result in legal action, which may include but not necessarily be limited to non-use of the building(s).

Applicant Signature [Signature] Date 7-6-94
 Department Approval [Signature] Date 7-6-94

Additional water and/or sewer tap fee(s) are required: YES _____ NO W/O No. 3023-2311-02-4
 Utility Accounting [Signature] Date 7-6-94

VALID FOR SIX MONTHS FROM DATE OF ISSUANCE (Section 9-3-2D Grand Junction Zoning & Development Code)

(White: Planning) (Yellow: Customer) (Pink: Building Department) (Goldenrod: Utility Accounting)


IMPROVEMENT LOCATION CERTIFICATE

815 MAZATLAN DRIVE

LOT 9, BLOCK 3, PARADISE HILLS FILING NO. SIX, MESA COUNTY, COLORADO.

First American Title #

Hoodman Acct.

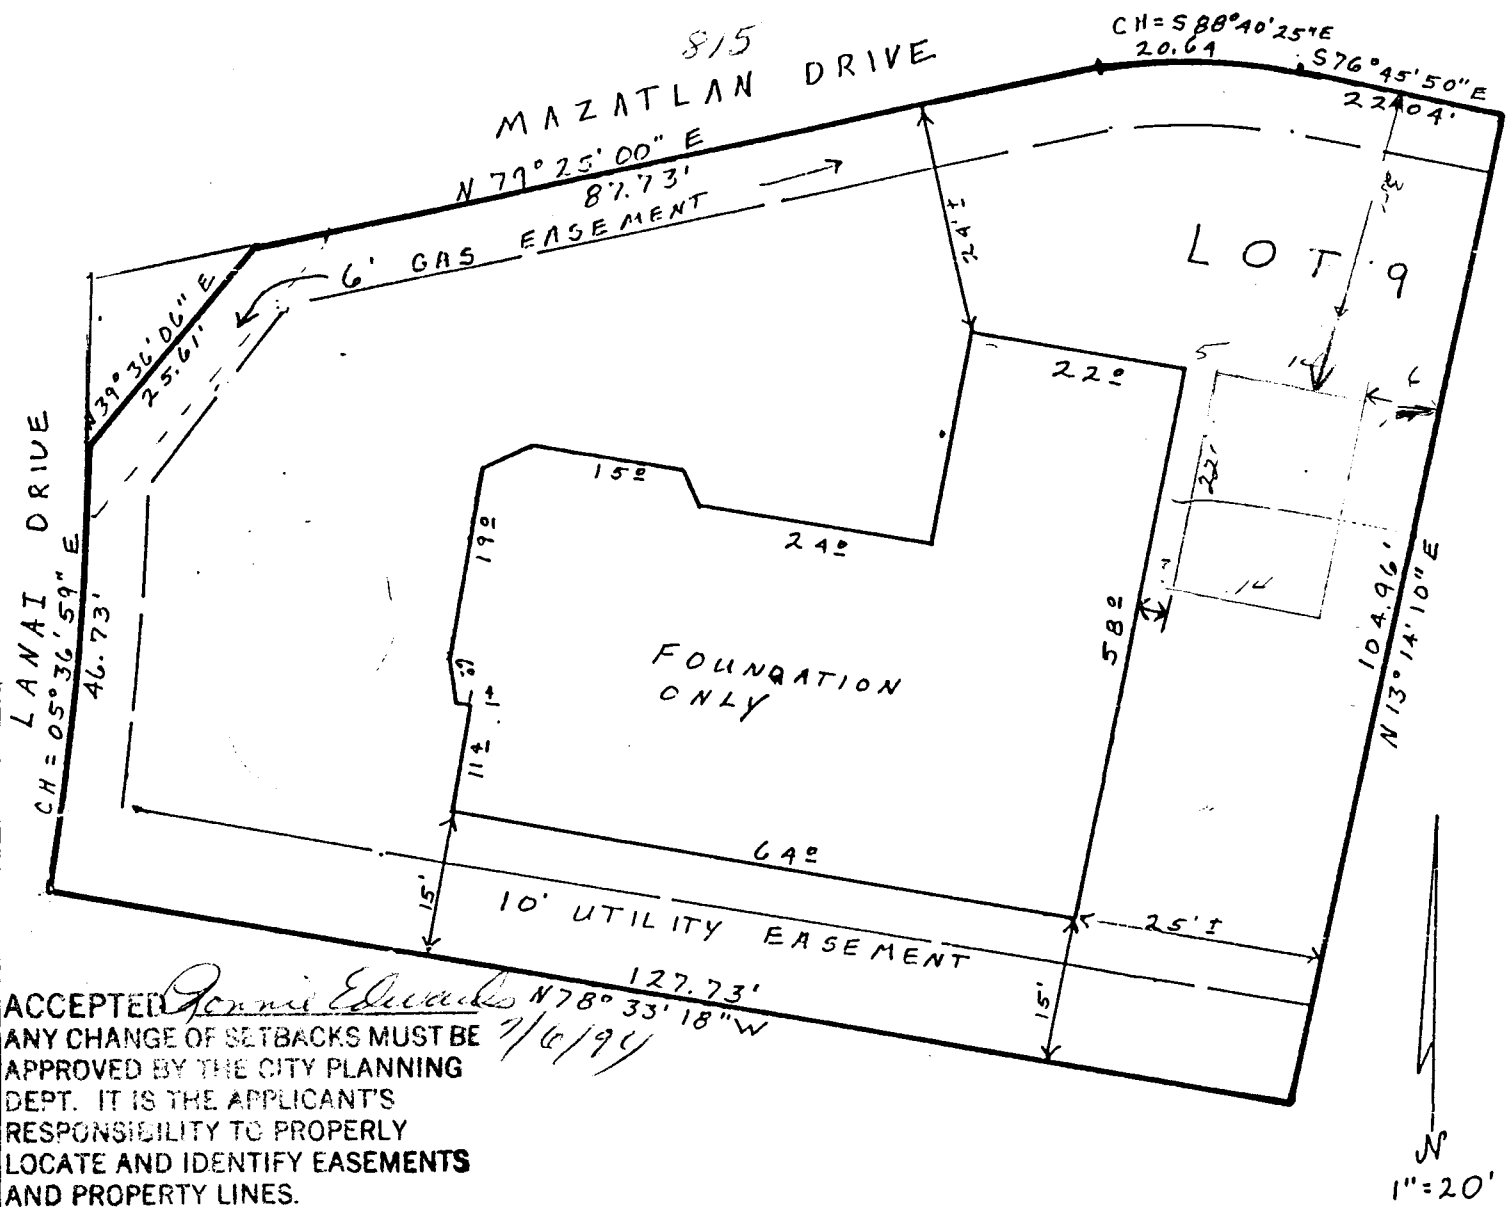

ACCEPTED *Jennis Edwards* 7/6/91
 ANY CHANGE OF SETBACKS MUST BE APPROVED BY THE CITY PLANNING DEPT. IT IS THE APPLICANT'S RESPONSIBILITY TO PROPERLY LOCATE AND IDENTIFY EASEMENTS AND PROPERTY LINES.

NOTE: This property does not fall within any 100 year floodplain.

I HEREBY CERTIFY THAT THIS IMPROVEMENT LOCATION CERTIFICATE WAS PREPARED FOR Ted Munkres Acct-Unifirst Mortgage THAT IT IS NOT A LAND SURVEY PLAT OR IMPROVEMENT SURVEY PLAT, AND THAT IT IS NOT TO BE RELIED UPON FOR THE ESTABLISHMENT OF FENCE, BUILDING, OR OTHER FUTURE IMPROVEMENT LINES. I FURTHER CERTIFY THE IMPROVEMENTS ON THE ABOVE DESCRIBED PARCEL ON THIS DATE 2/13/91 EXCEPT UTILITY CONNECTIONS, ARE ENTIRELY WITHIN THE BOUNDARIES OF THE PARCEL, EXCEPT AS SHOWN, THAT THERE ARE NO ENCROACHMENTS UPON THE DESCRIBED PREMISES BY IMPROVEMENTS ON ANY ADJOINING PREMISES, EXCEPT AS INDICATED, AND THAT THERE IS NO EVIDENCE OR SIGN OF ANY EASEMENT CROSSING OR BURDENING ANY PART OF SAID PARCEL, EXCEPT AS NOTED.

Jennis Edwards