


FEE- \$ 10.00

BLDG PERMIT NO. 50659

PLANNING CLEARANCE
(Single Family Residential and Accessory Structures)
Grand Junction Community Development Department

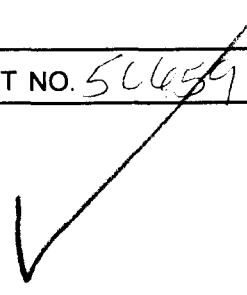

THIS SECTION TO BE COMPLETED BY APPLICANT

BLDG ADDRESS 2803 MESA AVE TAX SCHEDULE NO. 2943-073-13-002
SUBDIVISION VIRGINIA VILLAGE SQ. FT. OF PROPOSED BLDG(S)/ADDITION 450
FILING BLK 3 LOT 2 SQ. FT. OF EXISTING BLDG(S) 1227
(1) OWNER RUSSELL K. WILLIAMS NO. OF DWELLING UNITS BEFORE: 1 AFTER: 1 THIS CONSTRUCTION
(1) ADDRESS 2803 MESA AVE NO. OF BLDGS ON PARCEL BEFORE: 1 AFTER: 1 THIS CONSTRUCTION
(1) TELEPHONE 245-9172 USE OF EXISTING BLDGS DWELLING
(2) APPLICANT OWNER DESCRIPTION OF WORK AND INTENDED USE: ADDITION
(2) ADDRESS OF SHOP SPACE & SUN ROOM
(2) TELEPHONE

REQUIRED: Two (2) plot plans, on 8 1/2" x 11" paper, showing all existing and proposed structure location(s), parking, setbacks to all property lines, ingress/egress to the property, and all easements and rights-of-way which abut the parcel.

THIS SECTION TO BE COMPLETED BY COMMUNITY DEVELOPMENT DEPARTMENT STAFF

ZONE RSE-8 Maximum coverage of lot by structures
SETBACKS: Front 30' from property line (PL) or from center of ROW, whichever is greater
Side 5' from PL Rear 15' from PL
Maximum Height
CENSUS TRACT 4 TRAFFIC ZONE 30

Modifications to this Planning Clearance must be approved, in writing, by the Director of the Community Development Department. The structure authorized by this application cannot be occupied until a final inspection has been completed and a Certificate of Occupancy has been issued by the Building Department (Section 305, Uniform Building Code).

I hereby acknowledge that I have read this application and the information is correct; I agree to comply with any and all codes, ordinances, laws, regulations or restrictions which apply to the project. I understand that failure to comply shall result in legal action, which may include but not necessarily be limited to non-use of the building(s).


Applicant Signature Russell K. Williams Date 12-8-94
Department Approval Maria Rodriguez Date 12-8-94

Additional water and/or sewer tap fee(s) are required: YES NO X W/O No. 3008-1660-07-5
Utility Accounting Richardson Date 12-8-94

VALID FOR SIX MONTHS FROM DATE OF ISSUANCE (Section 9-3-2D Grand Junction Zoning & Development Code)
(White: Planning) (Yellow: Customer) (Pink: Building Department) (Goldenrod: Utility Accounting)

MESA AVE

70'

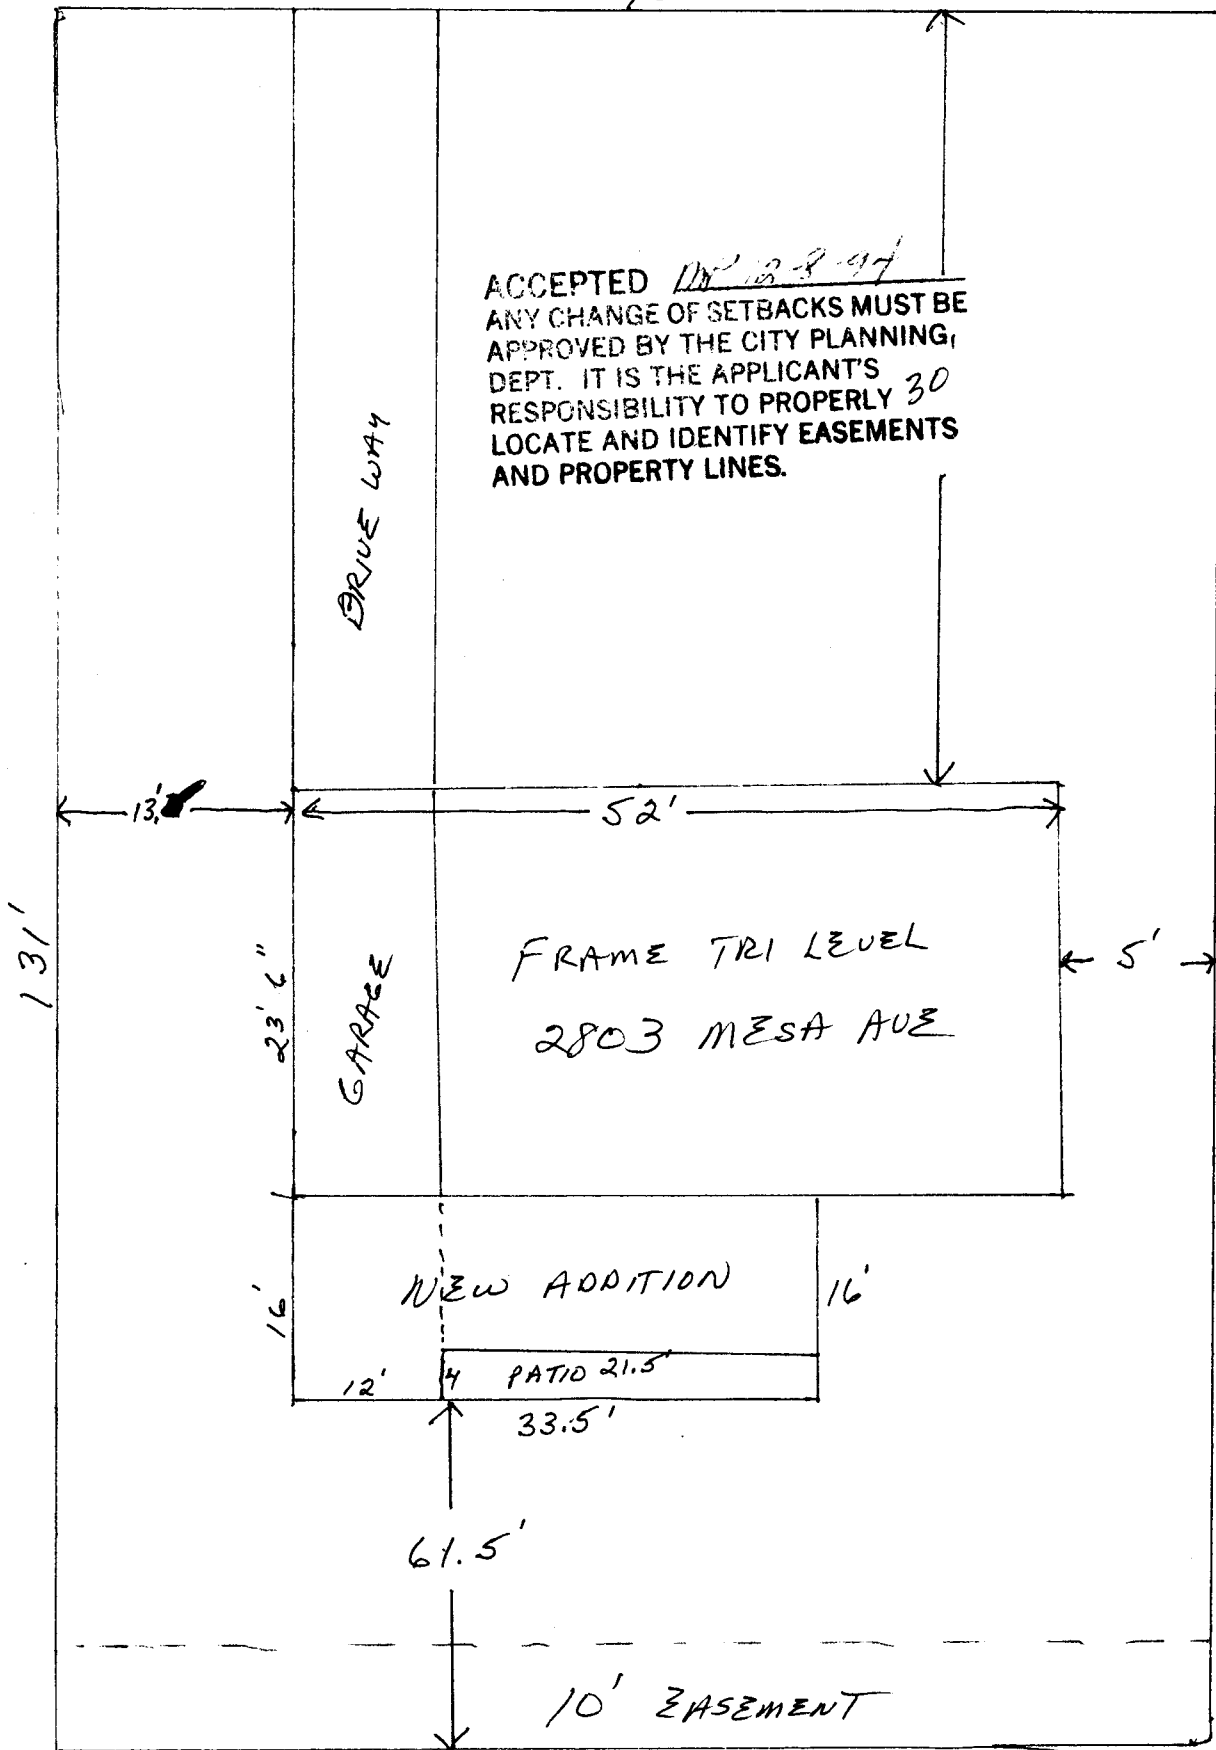

NOT TO SCALE MEASUREMENTS ARE ACCURATE