

FEE \$	10 ⁰⁰
TCP \$	324 ⁰⁰

BLDG PERMIT NO. 52668

PLANNING CLEARANCE
 (Single Family Residential and Accessory Structures)
 Grand Junction Community Development Department

THIS SECTION TO BE COMPLETED BY APPLICANT

BLDG ADDRESS 578 Darby Dr. TAX SCHEDULE NO. 2943-081-00-043
 SUBDIVISION Cody SQ. FT. OF PROPOSED BLDG(S)/ADDITION 1226
 FILING _____ BLK 1 LOT 7 SQ. FT. OF EXISTING BLDG(S) 0
 (1) OWNER Jhn Davis NO. OF DWELLING UNITS
 BEFORE: 0 AFTER: 1 THIS CONSTRUCTION
 (1) ADDRESS _____
 (1) TELEPHONE 243-7711 NO. OF BLDGS ON PARCEL
 BEFORE: 0 AFTER: 1 THIS CONSTRUCTION
 (2) APPLICANT CASTLE CONST USE OF EXISTING BLDGS Single Fam Res
 (2) ADDRESS 3068 DUPONT CS CO 8.508 DESCRIPTION OF WORK AND INTENDED USE: _____
 (2) TELEPHONE 434-2267 Single Fam Res

REQUIRED: Two (2) plot plans, on 8 1/2" x 11" paper, showing all existing and proposed structure location(s), parking, setbacks to all property lines, ingress/egress to the property, and all easements and rights-of-way which abut the parcel.

THIS SECTION TO BE COMPLETED BY COMMUNITY DEVELOPMENT DEPARTMENT STAFF

ZONE PR Maximum coverage of lot by structures _____
 SETBACKS: Front 20' from property line (PL) Parking Req'mt _____
 or _____ from center of ROW, whichever is greater
 Side 5' from PL Rear 10' from PL Special Conditions _____
 Maximum Height _____ or easements
 CENS.T. 11 T.ZONE 51 ANN# _____

Modifications to this Planning Clearance must be approved, in writing, by the Director of the Community Development Department. The structure authorized by this application cannot be occupied until a final inspection has been completed and a Certificate of Occupancy has been issued by the Building Department (Section 305, Uniform Building Code).

I hereby acknowledge that I have read this application and the information is correct; I agree to comply with any and all codes, ordinances, laws, regulations or restrictions which apply to the project. I understand that failure to comply shall result in legal action, which may include but not necessarily be limited to non-use of the building(s).

Applicant Signature William S. Spauld Date 6/30/95
 Department Approval Ronnie Edwards Date 6/30/95


Additional water and/or sewer tap fee(s) are required: YES NO _____ W/O No. 8440

Utility Accounting Jackie S. Bosny Date 6/30/95

VALID FOR SIX MONTHS FROM DATE OF ISSUANCE (Section 9-3-2C Grand Junction Zoning & Development Code)

(White: Planning) (Yellow: Customer) (Pink: Building Department) (Goldenrod: Utility Accounting)

CASTLE CONST
578 DARBY
LOT 7 B1K 1
CODY SUBD

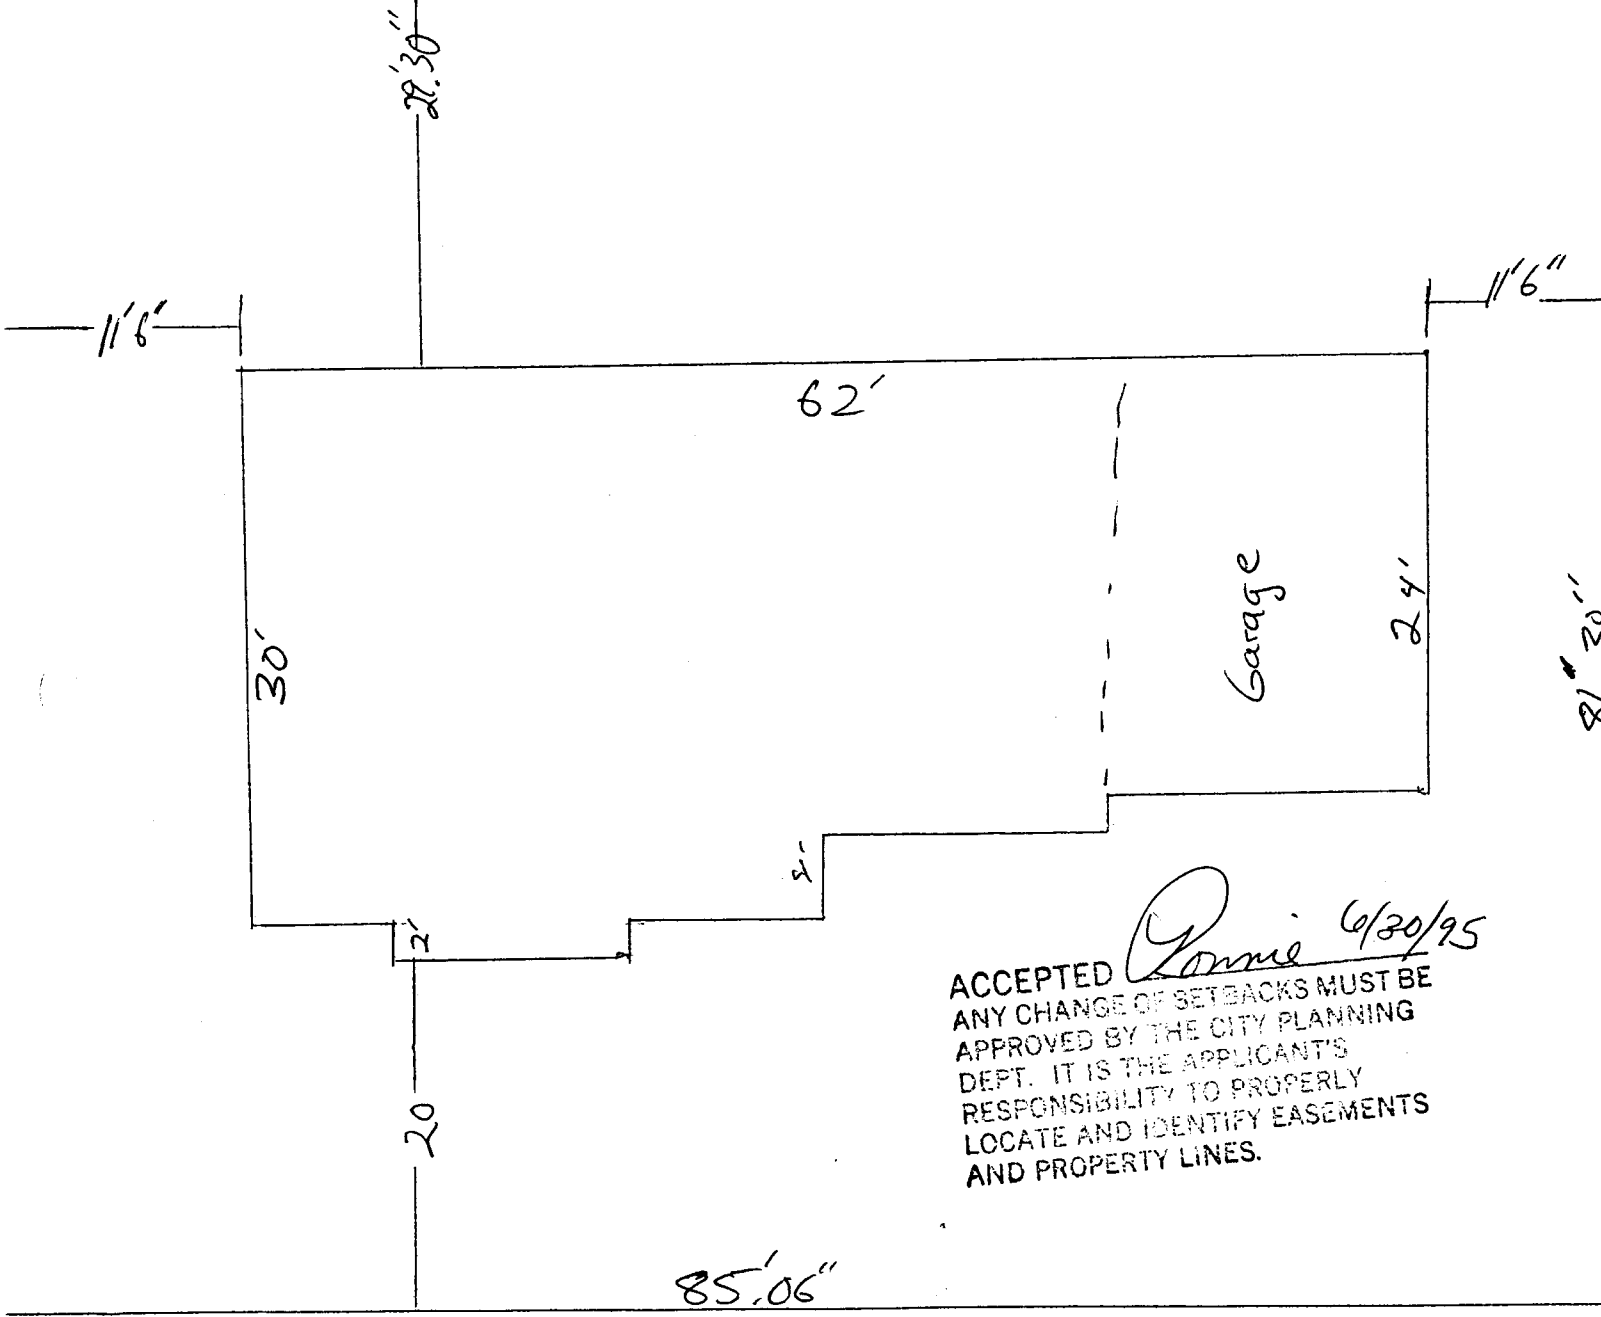

ACCEPTED *Ronnie* 6/30/95
ANY CHANGE OF SETBACKS MUST BE
APPROVED BY THE CITY PLANNING
DEPT. IT IS THE APPLICANT'S
RESPONSIBILITY TO PROPERLY
LOCATE AND IDENTIFY EASEMENTS
AND PROPERTY LINES.

Darby Dr. Front