


↑
GRAND AVE

ACCEPTED KP 4/10/95
ANY CHANGE OF SETBACKS MUST BE
APPROVED BY THE CITY PLANNING
DEPT. IT IS THE APPLICANT'S
RESPONSIBILITY TO PROPERLY
LOCATE AND IDENTIFY EASEMENTS
AND PROPERTY LINES.

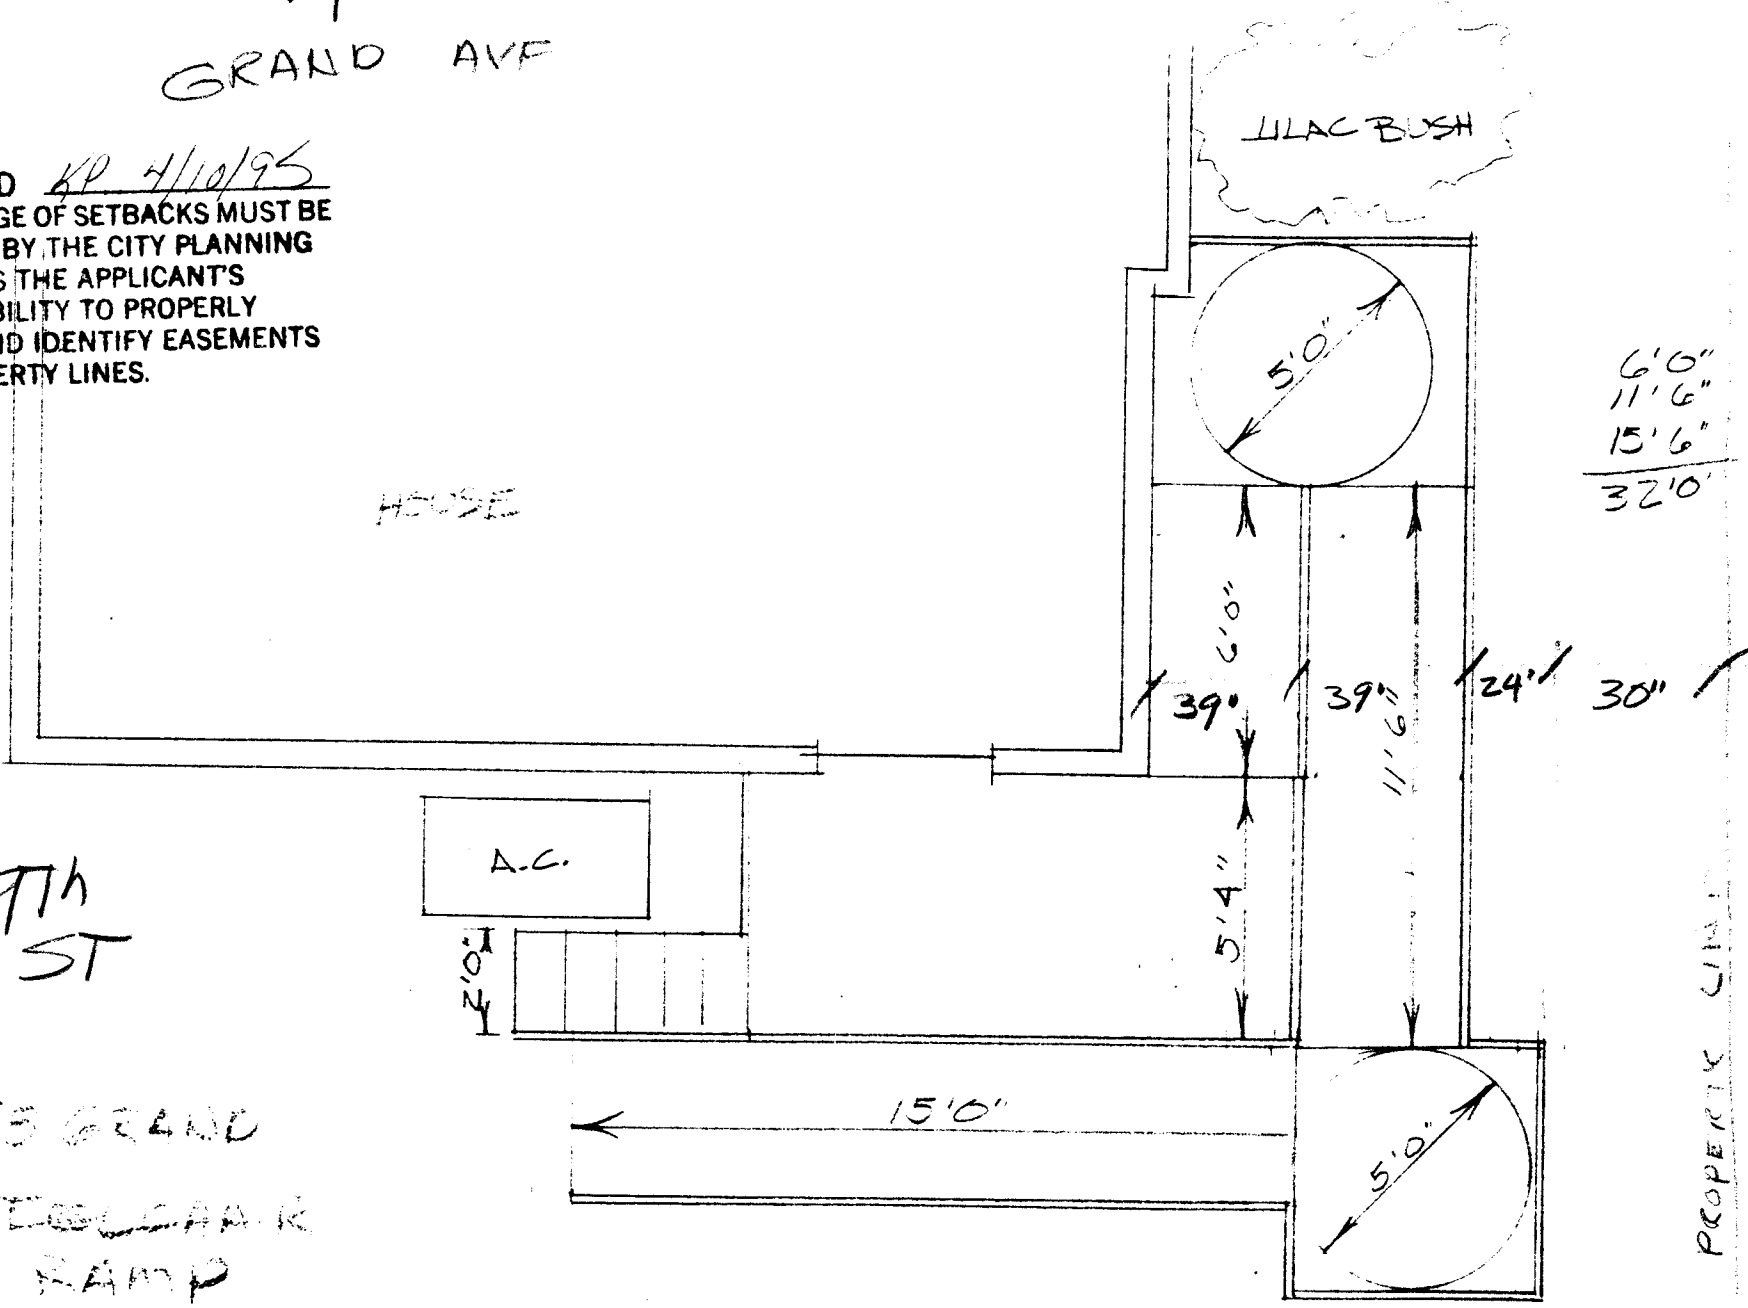

355 GRAND
WHEELCHAIR
RAMP

SCALE
 $\frac{1}{4}'' = 1'0''$

6/11/15

within PROPERTY LINES