

FEE \$ 10-
TCP \$ 500-

BLDG PERMIT NO. 53876

PLANNING CLEARANCE
(Single Family Residential and Accessory Structures)
Grand Junction Community Development Department

*4pc
JCP*

THIS SECTION TO BE COMPLETED BY APPLICANT

BLDG ADDRESS 588 Heidel St. TAX SCHEDULE NO. 2943-081-00-009
SUBDIVISION Cody SQ. FT. OF PROPOSED BLDG(S)/ADDITION 1620
FILING 3 BLK 1 LOT 3 SQ. FT. OF EXISTING BLDG(S) _____
(1) OWNER John Davis NO. OF DWELLING UNITS
BEFORE: 0 AFTER: 1 THIS CONSTRUCTION
(1) ADDRESS _____
(1) TELEPHONE 243-7711 NO. OF BLDGS ON PARCEL
BEFORE: 0 AFTER: 1 THIS CONSTRUCTION
(2) APPLICANT CASTLE CONST USE OF EXISTING BLDGS _____
(2) ADDRESS 3068 Duport ct. DESCRIPTION OF WORK AND INTENDED USE: _____
(2) TELEPHONE ~~243-7711~~ 434-2267 Single Fam Res

REQUIRED: Two (2) plot plans, on 8 1/2" x 11" paper, showing all existing and proposed structure location(s), parking, setbacks to all property lines, ingress/egress to the property, and all easements and rights-of-way which abut the parcel.

THIS SECTION TO BE COMPLETED BY COMMUNITY DEVELOPMENT DEPARTMENT STAFF

ZONE PR Maximum coverage of lot by structures _____
SETBACKS: Front 20' from property line (PL) Parking Req'mt _____
or _____ from center of ROW, whichever is greater
Special Conditions _____
Side 5' from PL Rear 10' from PL
Maximum Height _____
CENS.T. 11 T.ZONE 51 ANN# _____

Modifications to this Planning Clearance must be approved, in writing, by the Director of the Community Development Department. The structure authorized by this application cannot be occupied until a final inspection has been completed and a Certificate of Occupancy has been issued by the Building Department (Section 305, Uniform Building Code).

I hereby acknowledge that I have read this application and the information is correct; I agree to comply with any and all codes, ordinances, laws, regulations or restrictions which apply to the project. I understand that failure to comply shall result in legal action, which may include but not necessarily be limited to non-use of the building(s).

Applicant Signature Walter Soper Date 10/23/95
Department Approval Marcia Rubideaux Date 10-23-95

Additional water and/or sewer tap fee(s) are required: YES NO _____ W/O No. 8696
Utility Accounting Richardson Date 10-23-95

VALID FOR SIX MONTHS FROM DATE OF ISSUANCE (Section 9-3-2C Grand Junction Zoning & Development Code)

(White: Planning) (Yellow: Customer) (Pink: Building Department) (Goldenrod: Utility Accounting)

83.00




CASTLE CONSTRUCTION

BILL FITZGERALD
"It's not just a home, it's a Castle"

Contractors License No.
2950784

3068 Dupont Court
Grand Junction, CO 81504

(970) 434-2261
Pager (970) 256-3341

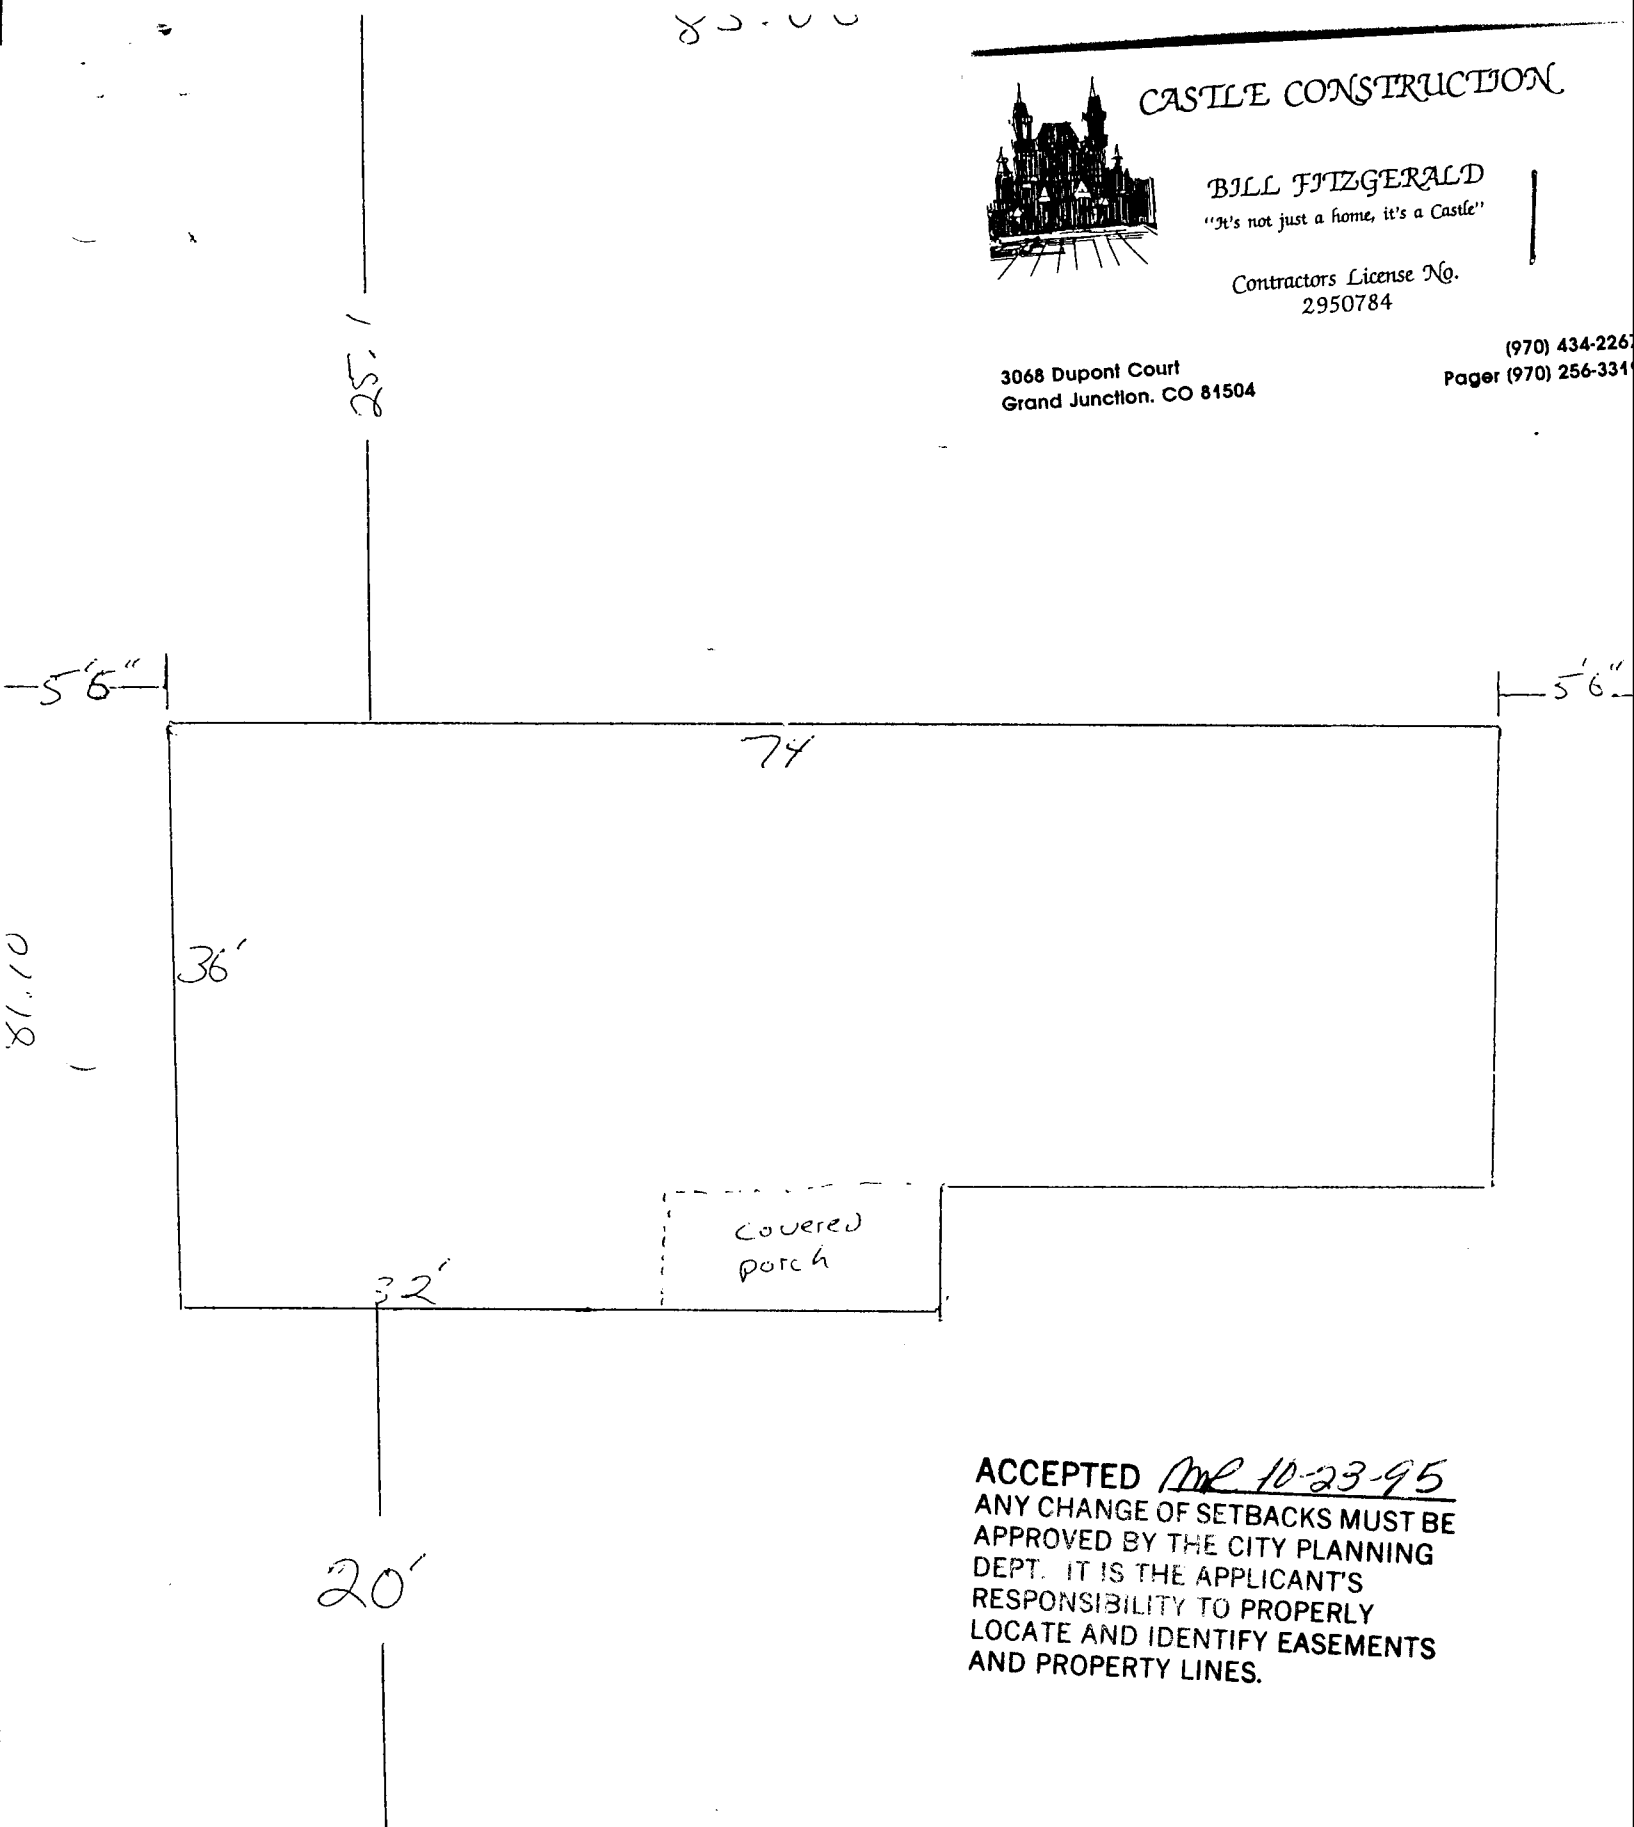

ACCEPTED ML 10-23-95
ANY CHANGE OF SETBACKS MUST BE APPROVED BY THE CITY PLANNING DEPT. IT IS THE APPLICANT'S RESPONSIBILITY TO PROPERLY LOCATE AND IDENTIFY EASEMENTS AND PROPERTY LINES.

LOT 3 B1K 1

588 HIEDEL ST.



CASTLE CONSTRUCTION

BILL FITZGERALD

"It's not just a home, it's a Castle"

Contractors License No. 2950784


3068 Dupont Court
Grand Junction, CO 81504

(970) 434-2267
Pager (970) 256-3311

85.00


25.1

13.1

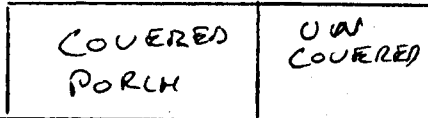

5'6"

5'6"

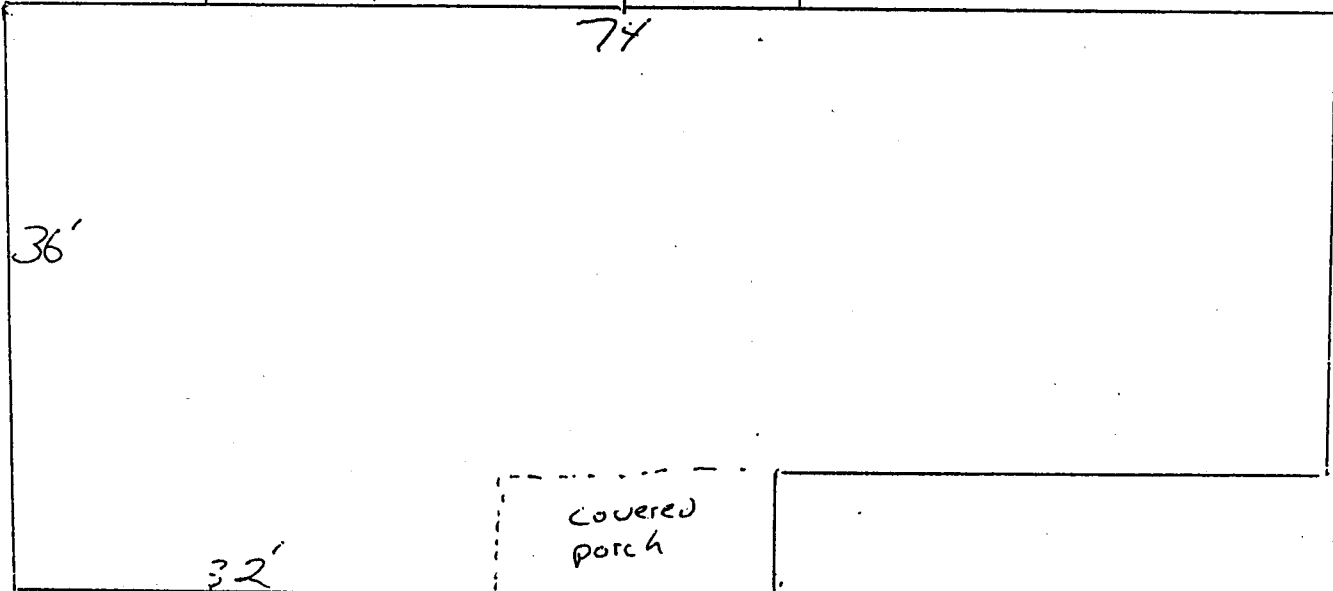

0.1.10

36'

74

covered porch

32'

20'

Revision okay -
 ACCEPTED *Donnie* 11/15/95
 ANY CHANGE OF SETBACKS MUST BE APPROVED BY THE CITY PLANNING DEPT. IT IS THE APPLICANT'S RESPONSIBILITY TO PROPERLY LOCATE AND IDENTIFY EASEMENTS AND PROPERTY LINES.

LOT 3 B1K 1

588 HIEDEL ST.