

FEE \$ 10-
 TCP \$ 500-

BLDG PERMIT NO. 53825

lpc
tcp

PLANNING CLEARANCE
 (Single Family Residential and Accessory Structures)
 Grand Junction Community Development Department

THIS SECTION TO BE COMPLETED BY APPLICANT

BLDG ADDRESS 590 HIEBEL WAY TAX SCHEDULE NO. 2943-081-00-009
 SUBDIVISION Cody SQ. FT. OF PROPOSED BLDG(S)/ADDITION 1409
 FILING 3 BLK 3 LOT 2 SQ. FT. OF EXISTING BLDG(S) _____
 (1) OWNER John Davis NO. OF DWELLING UNITS
 BEFORE: 0 AFTER: 1 THIS CONSTRUCTION
 (1) ADDRESS _____
 (1) TELEPHONE 243-7711 NO. OF BLDGS ON PARCEL
 BEFORE: 0 AFTER: 1 THIS CONSTRUCTION
 (2) APPLICANT CASTLE CONST USE OF EXISTING BLDGS _____
 (2) ADDRESS 3068 Dupont ct DESCRIPTION OF WORK AND INTENDED USE: _____
 (2) TELEPHONE 434-2267 Single Fam Res

REQUIRED: Two (2) plot plans, on 8 1/2" x 11" paper, showing all existing and proposed structure location(s), parking, setbacks to all property lines, ingress/egress to the property, and all easements and rights-of-way which abut the parcel.

THIS SECTION TO BE COMPLETED BY COMMUNITY DEVELOPMENT DEPARTMENT STAFF

ZONE PR Maximum coverage of lot by structures _____
 SETBACKS: Front 20' from property line (PL) Parking Req'mt _____
 or _____ from center of ROW, whichever is greater
 Side 5' from PL Rear 10' from PL Special Conditions _____
 Maximum Height _____
 CENS.T. 11 T.ZONE 51 ANN# _____

Modifications to this Planning Clearance must be approved, in writing, by the Director of the Community Development Department. The structure authorized by this application cannot be occupied until a final inspection has been completed and a Certificate of Occupancy has been issued by the Building Department (Section 305, Uniform Building Code).

I hereby acknowledge that I have read this application and the information is correct; I agree to comply with any and all codes, ordinances, laws, regulations or restrictions which apply to the project. I understand that failure to comply shall result in legal action, which may include but not necessarily be limited to non-use of the building(s).

Applicant Signature William [Signature] Date 10/23/95
 Department Approval Marcia [Signature] Date 10-23-95

Additional water and/or sewer tap fee(s) are required: YES X NO _____ W/O No. 8691
 Utility Accounting [Signature] Date 10-23-95

VALID FOR SIX MONTHS FROM DATE OF ISSUANCE (Section 9-3-2C Grand Junction Zoning & Development Code)

(White: Planning) (Yellow: Customer) (Pink: Building Department) (Goldenrod: Utility Accounting)

85 06



CASTLE CONSTRUCTION

BILL FITZGERALD

"It's not just a home, it's a Castle"

Contractors License No.
2950784

3068 Dupont Court
Grand Junction, CO 81504


(970) 434-2267
Pager (970) 256-3319

81.10

29.1

5'6"

5'6"

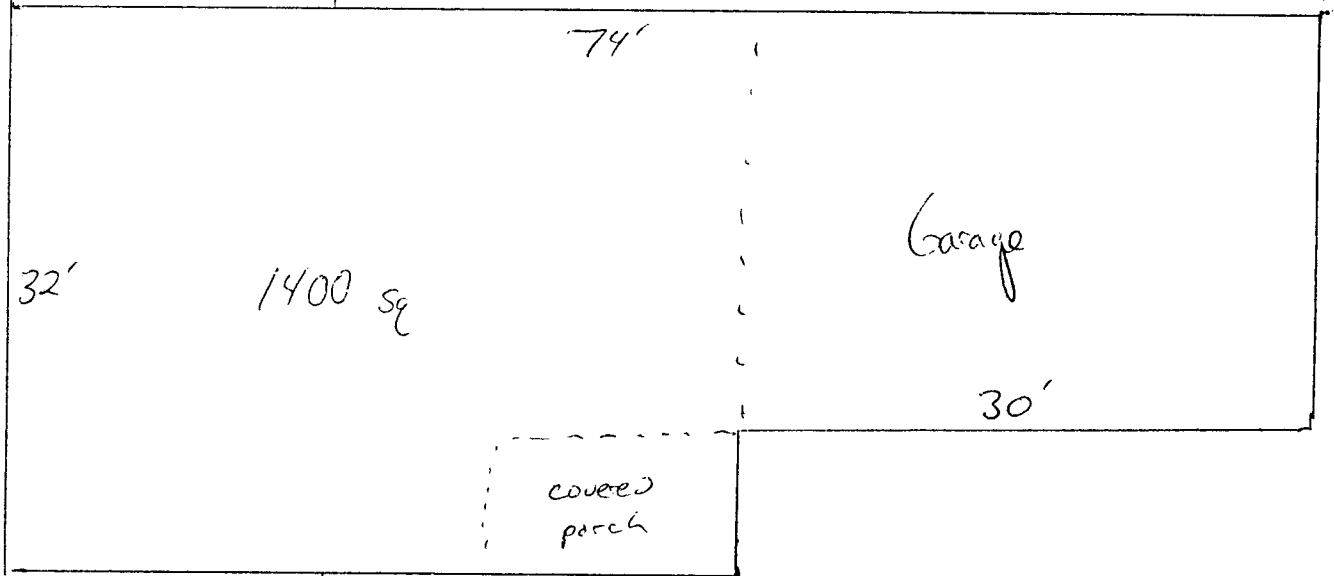

20'

ACCEPTED me 10-23-95
 ANY CHANGE OF SETBACKS MUST BE
 APPROVED BY THE CITY PLANNING
 DEPT. IT IS THE APPLICANT'S
 RESPONSIBILITY TO PROPERLY
 LOCATE AND IDENTIFY EASEMENTS
 AND PROPERTY LINES.

Lot 2 B 3 F3. 591 Heidel St