	<u>,-</u>	
1	FEE\$	1000
	TCP\$	

(White: Planning)

(Yellow: Customer)

	1211
BLDG PERMIT NO.	53615

(Goldenrod: Utility Accounting)


PLANNING CLEARANCE

(Single Family Residential and Accessory Structures)

Grand Junction Community Development Department

3021-2035-01-5 ™ THIS SECTION TO B	E COMPLETED BY APPLICANT 🐿
BLDG ADDRESS 2698 Kimberly Dr	TAX SCHEDULE NO. 270/ 354z 800/
SUBDIVISION Bulla Vista	SQ. FT. OF PROPOSED BLDG(S)/ADDITION 140 T
FILING / BLK 2 LOT /	SQ. FT. OF EXISTING BLDG(S) 2500 4 t
(1) OWNER LOA Same	NO. OF DWELLING UNITS
(1) ADDRESS Same	BEI ORE ITIIS CONSTRUCTION
(1) TELEPHONE <u>256-7972</u>	NO. OF BLDGS ON PARCEL BEFORE: / AFTER: Z THIS CONSTRUCTION
(2) APPLICANT SAME	USE OF EXISTING BLDGS RESIDENCE
(2) ADDRESS SCIME	DESCRIPTION OF WORK AND INTENDED USE:
(2) TELEPHONE SAME	STURAGE
	r, showing all existing and proposed structure location(s), parking, perty, and all easements and rights-of-way which abut the parcel.
ZONE from property line (PL)	Maximum coverage of lot by structures Parking Req'mt
or from center of ROW, whichever is greater Side from PL Rear from F	Special Conditions
Maximum Height	- CENS.T. 10 T.ZONE 17 ANNX#
	roved, in writing, by the Director of the Community Development cannot be occupied until a final inspection has been completed and ling Department (Section 305, Uniform Building Code).
	d the information is correct; I agree to comply with any and all codes, o the project. I understand that failure to comply shall result in legal to non-use of the building(s).
Applicant Signature My Meles	Date SEFT 29, 1995
Department Approval Lannue Eliura	us Date 9/29/95
Additional water and/or sewer tap fee(s) are required: Y	ES_NO \ WO NO. W/A - no Change
Utility Accounting Mullie Four	2e
VALID FOR SIX MONTHS FROM DATE OF ISSUANCE	(Section 9-3-2C Grand Junction Zoning & Development Code)

(Pink: Building Department)

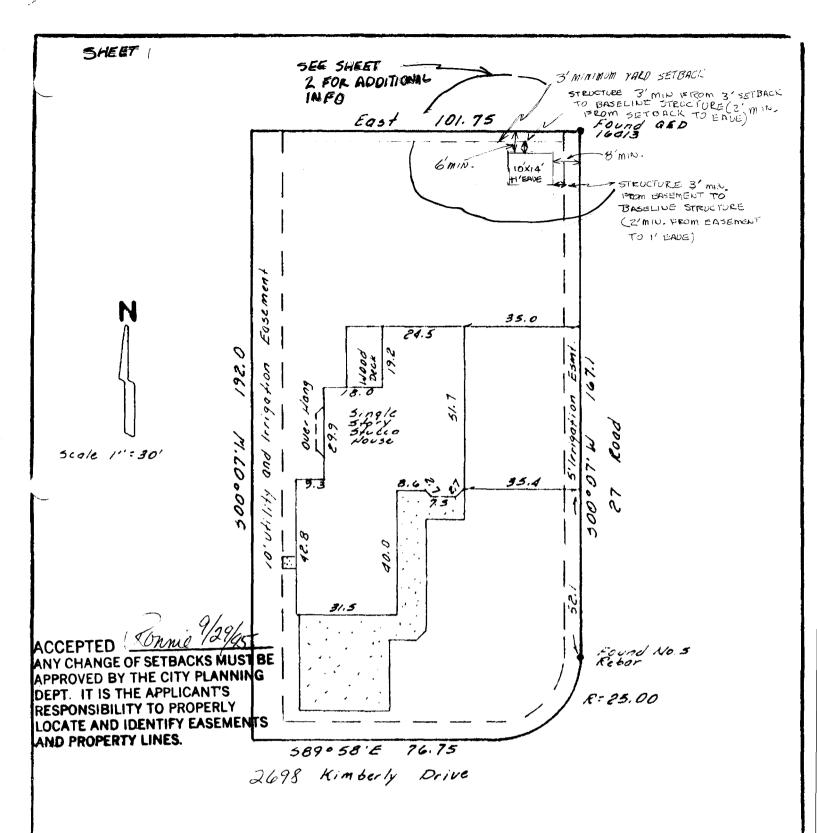


IMPROVEMENT LOCATION CERTIFICATE

LEGAL DESCRIPTION: Lot 1 Block 2 Bella VistA Subdivision, First Addition.

I hereby certify that this IMPROVEMENT LOCATION CERTIFICATE was prepared for bon Hickman that this is not a land survey plat or improvement survey plat, and that it is not to be relied upon for the establishment of fences, buildings or other future improvements.

I further certify that the improvements on the above described parcel on this date 6/2/95 , except utility connections are entirely within the boundaries of the parcel, except as shown, that there no encroachments upon the described premises by improvements of any adjoining premises, except as indicated, and that there is no apparent evidence or sign of any easement crossing or burdening any part of said parcel, except as noted.

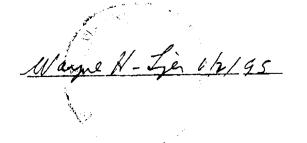



Monument Surveying Co.

755 Rood Avenue Grand Junction Co. 81501

245-4189 6/2/95

2698 Kimberle Dr. Don Hickman Property