

FEE \$	1000 500
TCP \$	0

See receipt #586

BLDG PERMIT NO. 52866

PLANNING CLEARANCE
 (Single Family Residential and Accessory Structures)
 Grand Junction Community Development Department

1008-0550-10-5

THIS SECTION TO BE COMPLETED BY APPLICANT

BLDG ADDRESS 2026 Road TAX SCHEDULE NO. 2945 134 02 015

SUBDIVISION East Main St. SQ. FT. OF PROPOSED BLDG(S)/ADDITION 800

FILING _____ BLK 8 LOT 13 SQ. FT. OF EXISTING BLDG(S) 400

(1) OWNER Adamson, Mary NO. OF DWELLING UNITS
 BEFORE: 1 AFTER: 1 THIS CONSTRUCTION

(1) ADDRESS 2026 Road

(1) TELEPHONE 245-5430 NO. OF BLDGS ON PARCEL
 BEFORE: 2 AFTER: 2 THIS CONSTRUCTION

(2) APPLICANT Adamson Mary USE OF EXISTING BLDGS Home

(2) ADDRESS 2026 Road DESCRIPTION OF WORK AND INTENDED USE: _____

(2) TELEPHONE 245 5430 open carport

REQUIRED: Two (2) plot plans, on 8 1/2" x 11" paper, showing all existing and proposed structure location(s), parking, setbacks to all property lines, ingress/egress to the property, and all easements and rights-of-way which abut the parcel.

THIS SECTION TO BE COMPLETED BY COMMUNITY DEVELOPMENT DEPARTMENT STAFF

ZONE RMF-32 Maximum coverage of lot by structures 60%

SETBACKS: Front 20' from property line (PL) Parking Req'mt _____
 or _____ from center of ROW, whichever is greater

Side 10'5' from PL Rear 20' from PL Special Conditions _____

Maximum Height 32' CENS.T. 7 T.ZONE 40 ANN# _____

Modifications to this Planning Clearance must be approved, in writing, by the Director of the Community Development Department. The structure authorized by this application cannot be occupied until a final inspection has been completed and a Certificate of Occupancy has been issued by the Building Department (Section 305, Uniform Building Code).

I hereby acknowledge that I have read this application and the information is correct; I agree to comply with any and all codes, ordinances, laws, regulations or restrictions which apply to the project. I understand that failure to comply shall result in legal action, which may include but not necessarily be limited to non-use of the building(s).

Applicant Signature Mary Adamson Date 6-2-95


Department Approval Ronnie Edwards Date 6-2-95

Additional water and/or sewer tap fee(s) are required: YES _____ NO X W/O No. N/A no change in SF use

Utility Accounting Millie Fowler Date 6-2-95

VALID FOR SIX MONTHS FROM DATE OF ISSUANCE (Section 9-3-2C Grand Junction Zoning & Development Code)

(White: Planning) (Yellow: Customer) (Pink: Building Department) (Goldenrod: Utility Accounting)

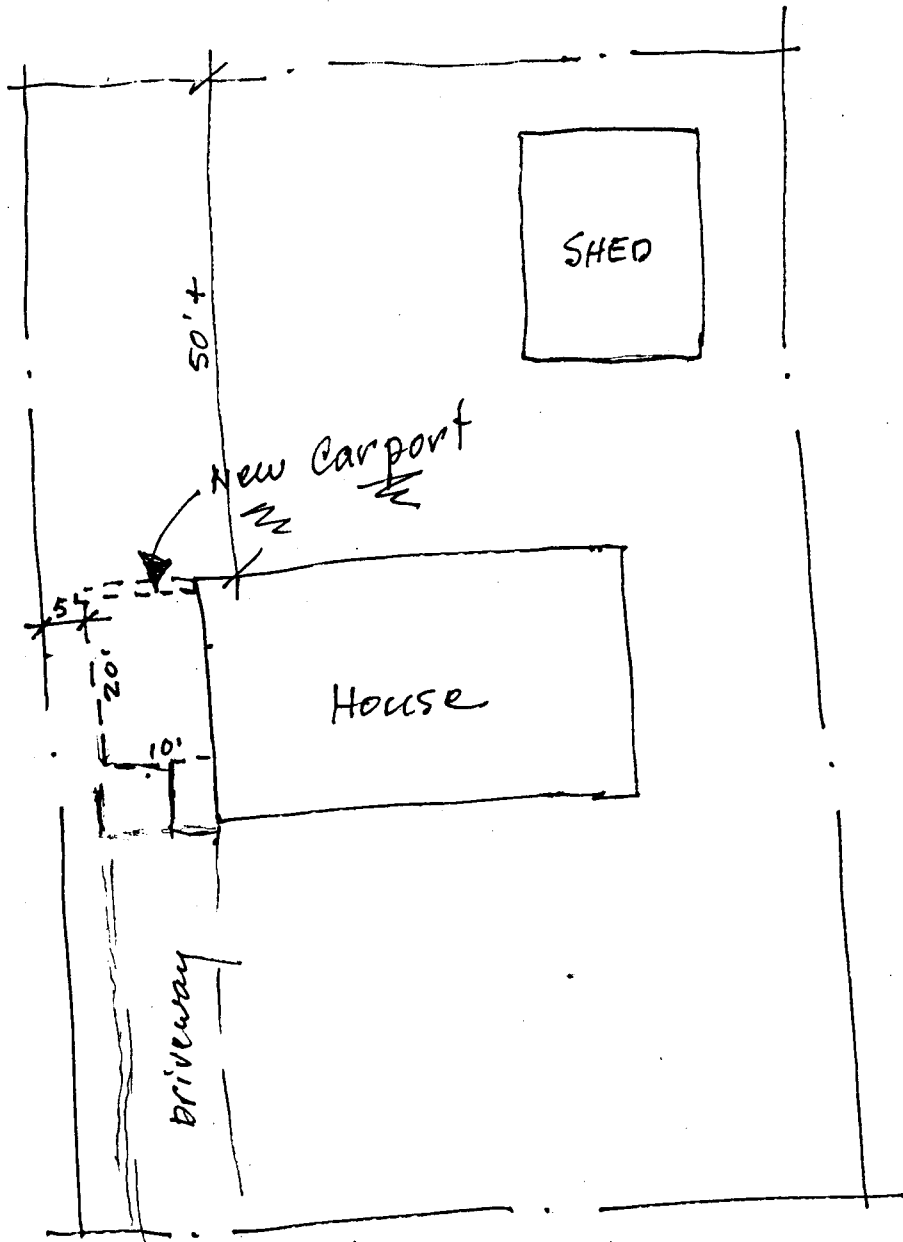

2026 ROOD AVE.

ACCEPTED Ronnie Edwards 6/2/95
 ANY CHANGE OF SETBACKS MUST BE APPROVED BY THE CITY PLANNING DEPT. IT IS THE APPLICANT'S RESPONSIBILITY TO PROPERLY LOCATE AND IDENTIFY EASEMENTS AND PROPERTY LINES.

ACCEPTED A. Barrett
 ANY CHANGE OF SETBACKS MUST BE APPROVED BY THE CITY PLANNING DEPT. IT IS THE APPLICANT'S RESPONSIBILITY TO PROPERLY LOCATE AND IDENTIFY EASEMENTS AND PROPERTY LINES.