11-7	
	NG CLEARANCE BLDG PERMIT NO. 51442
(Single Family Resid	dential and Accessory Structures)
1 .	BE COMPLETED BY APPLICANT 🔊
BLDG ADDRESS 2830 - Uillan lien	TAX SCHEDULE NO. $2943-072-29-009$ SQ. FT. OF PROPOSED BLDG(S)/ADDITION $1188^{10}$
SUBDIVISION Falls Village	SQ. FT. OF PROPOSED BLDG(S)/ADDITION _//P&
	_ SQ. FT. OF EXISTING BLDG(S)
(1) OWNER Ribersson	NO. OF DWELLING UNITS BEFORE:AFTER:THIS CONSTRUCTION
(1) ADDRESS Logo Zyth Rd.	NO. OF BLDGS ON PARCEL
(1) TELEPHONE <u>Z 4 7-230 c</u>	BEFORE: AFTER: THIS CONSTRUCTION
(2) APPLICANT	
<sup>(2)</sup> ADDRESS	DESCRIPTION OF WORK AND INTENDED USE: $\frac{5}{F}$
<sup>(2)</sup> TELEPHONE	Red
	er, showing all existing and proposed structure location(s), parking, roperty, and all easements and rights-of-way which abut the parcel.
THIS SECTION TO BE COMPLETED B	Y COMMUNITY DEVELOPMENT DEPARTMENT STAFF T
ZONE <u>PR</u>	Maximum coverage of lot by structures
SETBACKS: Front	Maximum coverage of lot by structures     ) or   Parking Req'mt
SETBACKS: Front from property line (PL)	Maximum coverage of lot by structures ) or Parking Req'mt
SETBACKS: Front from property line (PL) from center of ROW, whichever is greater Side from PL Rear from	Maximum coverage of lot by structures ) or Parking Req'mt Special Conditions
SETBACKS: Front from property line (PL)	Maximum coverage of lot by structures     ) or   Parking Req'mt
SETBACKS: Front	Maximum coverage of lot by structures ) or Parking Req'mt Special Conditions
SETBACKS: Front	Maximum coverage of lot by structures
SETBACKS: Front	Maximum coverage of lot by structures

(White: Planning)

----

(Yellow: Customer)

(Pink: Building Department)

(Goldenrod: Utility Accounting)

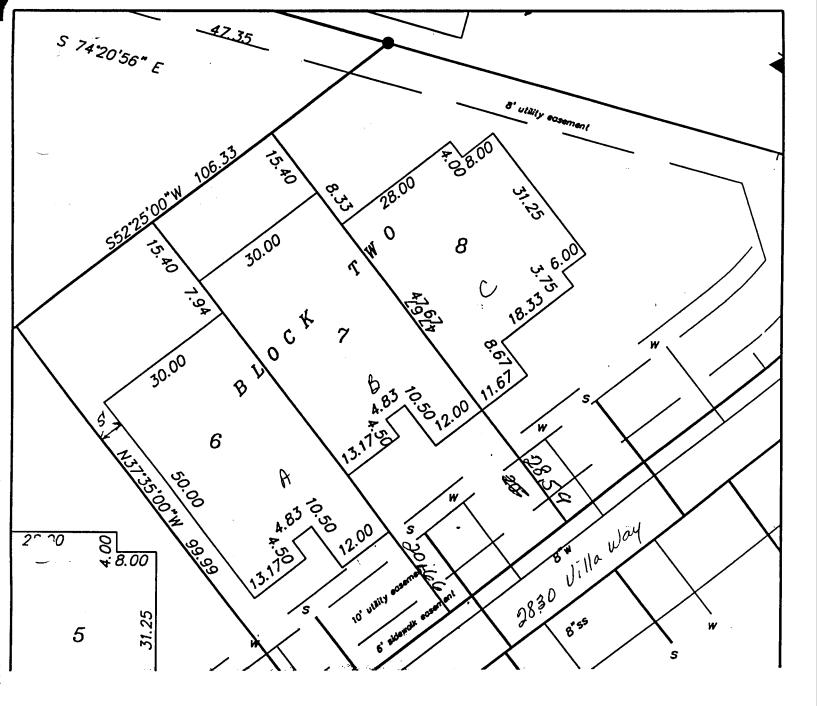

2830 Villa Word

ACCEPTED Connie Edwards #3/95 ANY CHANGE OF SETBACKS MUST BE

APPROVED BY THE CITY PLANNING DEPT. IT IS THE APPLICAN I'S RESPONSIBILITY TO PROPERLY LOCATE AND IDENTIFY EASEMENTS AND PROPERTY LINES. 1999 - A. 1992

.