

FEE \$10.00
TCP \$500.00

BLDG PERMIT NO. 58290

School fee: 292.00

PLANNING CLEARANCE
(Single Family Residential and Accessory Structures)
Grand Junction Community Development Department

RZF-96-195

L
TCP *Schulz*

THIS SECTION TO BE COMPLETED BY APPLICANT

BLDG ADDRESS 1620 Canon TAX SCHEDULE NO. 2945-233-09-001
 SUBDIVISION Ashmont Heights SQ. FT. OF PROPOSED BLDG(S)/ADDITION 1200
 FILING - BLK 4 LOT 2 SQ. FT. OF EXISTING BLDG(S) ---
 (1) OWNER Ronald Ashley NO. OF DWELLING UNITS
 BEFORE: 0 AFTER: 1 THIS CONSTRUCTION
 (1) ADDRESS 545 Grand mesa
 NO. OF BLDGS ON PARCEL
 BEFORE: 0 AFTER: 1 THIS CONSTRUCTION
 (1) TELEPHONE 970-242-2633
 (2) APPLICANT Ronald Ashley USE OF EXISTING BLDGS ---
 (2) ADDRESS 545 Grand mesa DESCRIPTION OF WORK AND INTENDED USE: ---
 (2) TELEPHONE 241-3488 new home

REQUIRED: Two (2) plot plans, on 8 1/2" x 11" paper, showing all existing and proposed structure location(s), parking, setbacks to all property lines, ingress/egress to the property, and all easements and rights-of-way which abut the parcel.

THIS SECTION TO BE COMPLETED BY COMMUNITY DEVELOPMENT DEPARTMENT STAFF

ZONE RZF-8 Maximum coverage of lot by structures ---
 SETBACKS: Front 20' from property line (PL) Parking Req'mt ---
 or 45' from center of ROW, whichever is greater Special Conditions ---
 Side 5' from PL Rear 15' from PL
 Maximum Height 32' CENSUS TRACT 13 TRAFFIC ZONE 80

Modifications to this Planning Clearance must be approved, in writing, by the Director of the Community Development Department. The structure authorized by this application cannot be occupied until a final inspection has been completed and a Certificate of Occupancy has been issued by the Building Department (Section 305, Uniform Building Code).

I hereby acknowledge that I have read this application and the information is correct; I agree to comply with any and all codes, ordinances, laws, regulations or restrictions which apply to the project. I understand that failure to comply shall result in legal action, which may include but not necessarily be limited to non-use of the building(s).

Applicant Signature Ronald Ashley Date ---

Department Approval Walter K. Brown Date 11/21/96


Additional water and/or sewer tap fee(s) are required: YES NO W/O No. 9678

Utility Accounting Patricia Hobbes Date 11/21/96

VALID FOR SIX MONTHS FROM DATE OF ISSUANCE (Section 9-3-2C Grand Junction Zoning & Development Code)

(White: Planning) (Yellow: Customer) (Pink: Building Department) (Goldenrod: Utility Accounting)

ASH TON H
 A REPLAT OF LOTS 6, 7, 8, 9
 MESA HEIGHTS SUBDIVISION

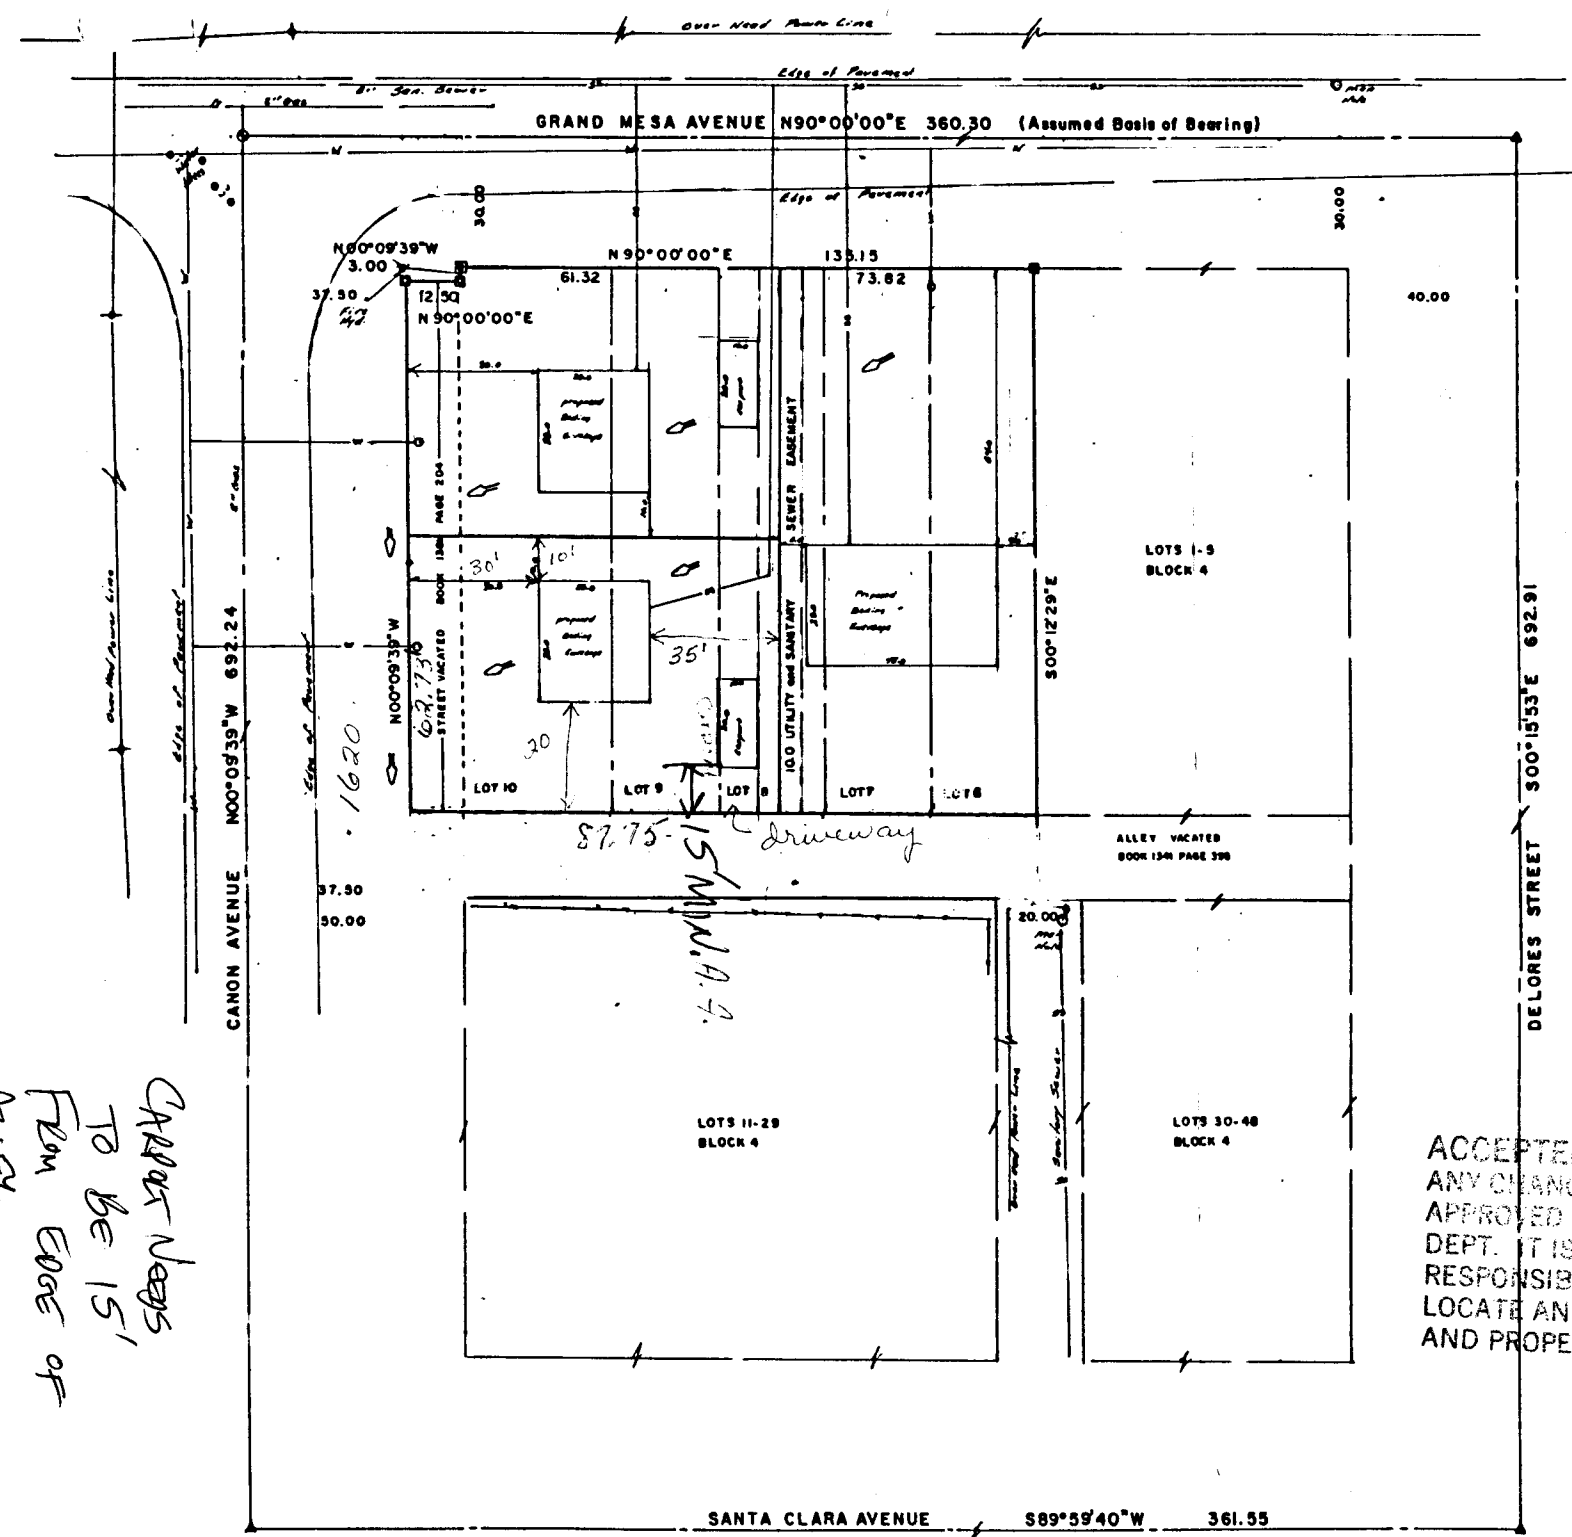

*CHANGES
 TO BE 15'
 FROM EDGE OF
 ALLEY,
 J. Webb
 11-20-96*

ACCEPTED *Ronne 11/21/96*
 ANY CHANGE OF SETBACKS MUST BE
 APPROVED BY THE CITY PLANNING
 DEPT. IT IS THE APPLICANT'S
 RESPONSIBILITY TO PROPERLY
 LOCATE AND IDENTIFY EASEMENTS
 AND PROPERTY LINES.

