

FEE \$ 10 -
TCP \$ 0 -

BLDG PERMIT NO. 57995

School 292-

PLANNING CLEARANCE
(Single Family Residential and Accessory Structures)
Grand Junction Community Development Department

Schump

THIS SECTION TO BE COMPLETED BY APPLICANT

BLDG ADDRESS 1614 Chama Lane TAX SCHEDULE NO. 2945-031-00-155
SUBDIVISION Valley Meadows East SQ. FT. OF PROPOSED BLDG(S)/ADDITION 1528
FILING 1 BLK 3 LOT 3 SQ. FT. OF EXISTING BLDG(S) -
(1) OWNER John Davis NO. OF DWELLING UNITS
BEFORE: _____ AFTER: 1 THIS CONSTRUCTION
(1) ADDRESS _____ NO. OF BLDGS ON PARCEL
BEFORE: _____ AFTER: 1 THIS CONSTRUCTION
(1) TELEPHONE 243-1771 USE OF EXISTING BLDGS -
(2) APPLICANT Castle Homes DESCRIPTION OF WORK AND INTENDED USE:
(2) ADDRESS 2755 N. Ave. single family
(2) TELEPHONE 248-4638

REQUIRED: Two (2) plot plans, on 8 1/2" x 11" paper, showing all existing and proposed structure location(s), parking, setbacks to all property lines, ingress/egress to the property, and all easements and rights-of-way which abut the parcel.

THIS SECTION TO BE COMPLETED BY COMMUNITY DEVELOPMENT DEPARTMENT STAFF

ZONE PR-2.93 Maximum coverage of lot by structures _____
SETBACKS: Front 20' from property line (PL) Parking Req'mt 2
or _____ from center of ROW, whichever is greater Special Conditions _____
Side 10' from PL Rear 20' from PL
Maximum Height 32' CENSUS TRACT 10 TRAFFIC ZONE 19

Modifications to this Planning Clearance must be approved, in writing, by the Director of the Community Development Department. The structure authorized by this application cannot be occupied until a final inspection has been completed and a Certificate of Occupancy has been issued by the Building Department (Section 305, Uniform Building Code).

I hereby acknowledge that I have read this application and the information is correct; I agree to comply with any and all codes, ordinances, laws, regulations or restrictions which apply to the project. I understand that failure to comply shall result in legal action, which may include but not necessarily be limited to non-use of the building(s).

Applicant Signature [Signature] Date 10/16/96
Department Approval [Signature] Date 10-24-96

Additional water and/or sewer tap fee(s) are required: YES X NO _____ W/O No. 9624

Utility Accounting [Signature] Date 10/25/96


VALID FOR SIX MONTHS FROM DATE OF ISSUANCE (Section 9-3-2C Grand Junction Zoning & Development Code)

(White: Planning) (Yellow: Customer) (Pink: Building Department) (Goldenrod: Utility Accounting)

VALLEY MEADOWS EAST SUBDIVISION

L3 B3 F1

APPROVED

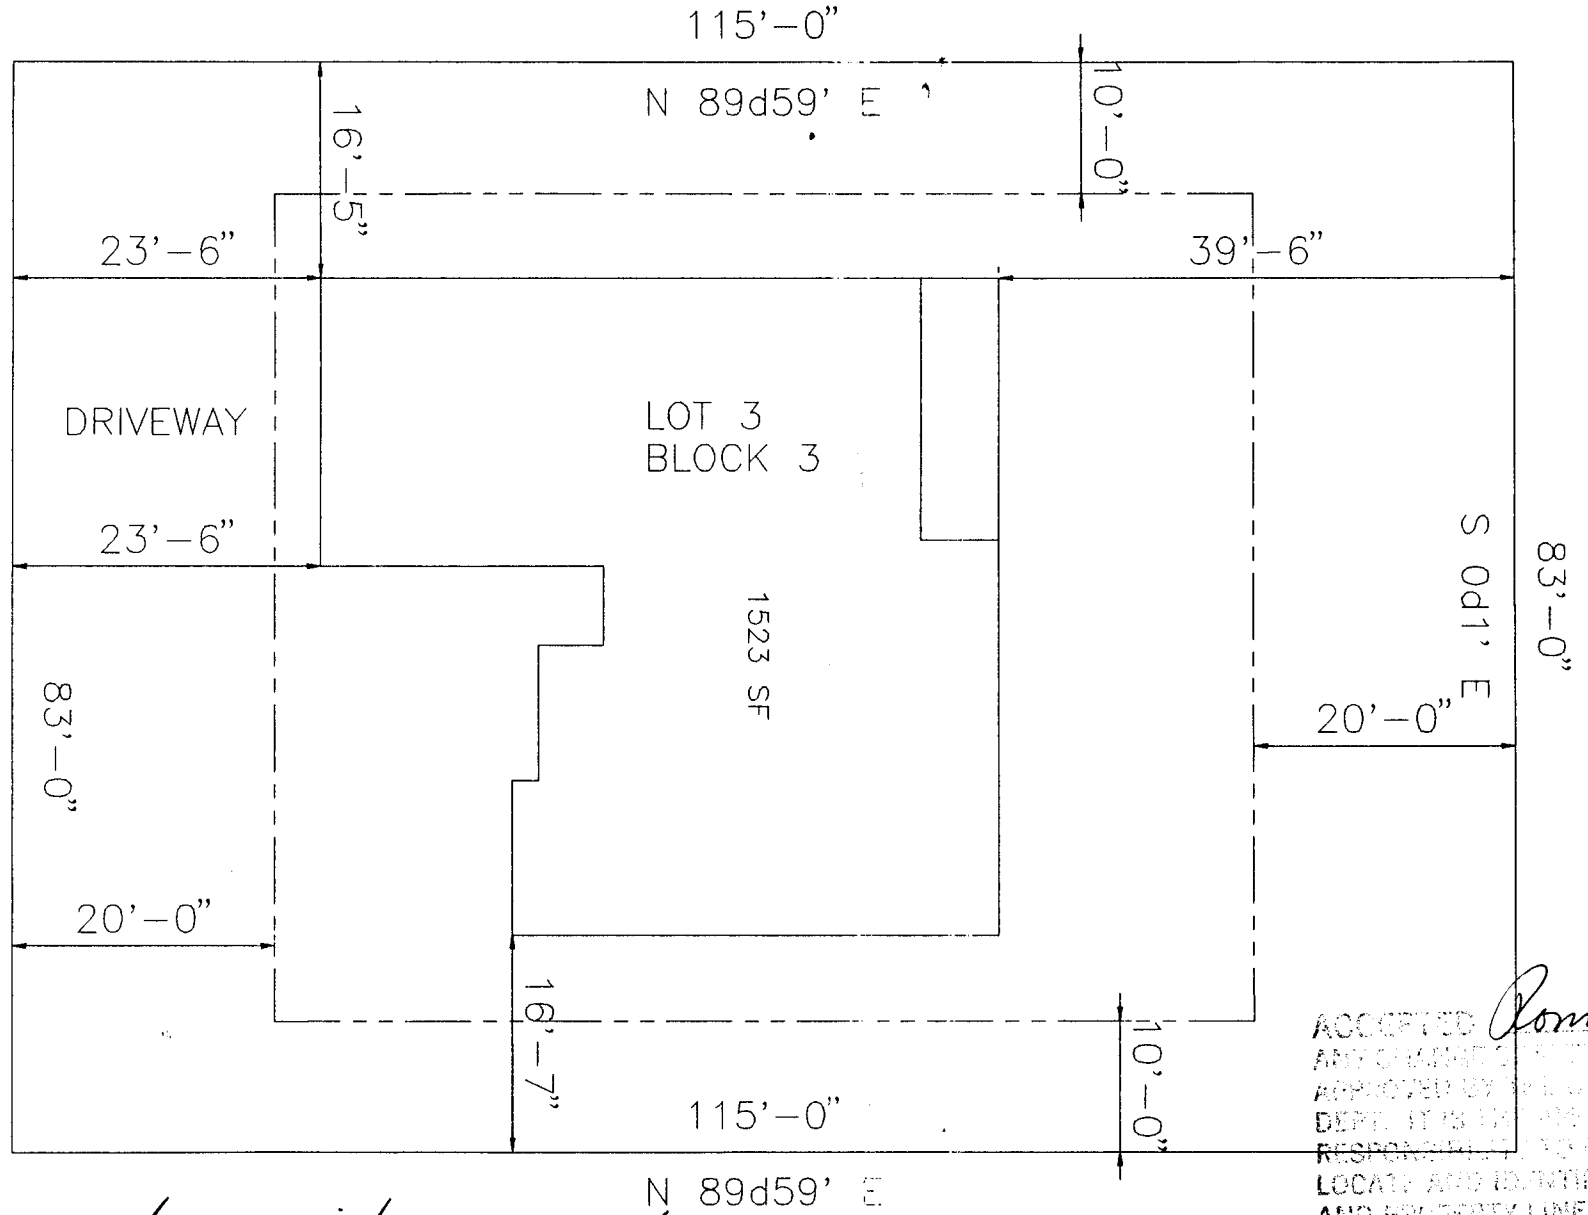

Handwritten:
 Driveway
 Location OK
 10-24-96
 CHAMA LANE
 664
 599

Handwritten: No overhangs into easements

ACCEPTED *Ronnie 10/24/96*
 ANY CHANGE TO THIS PLAN MUST BE
 APPROVED BY THE CITY PLANNING
 DEPT. IT IS THE APPLICANT'S
 RESPONSIBILITY TO PROPERLY
 LOCATE AND IDENTIFY EASEMENTS
 AND PROPERTY LINES.