	FEE\$	15,08
	TCP\$	
9	chool	\$292

(White: Planning)

(Yellow: Customer)

BLDG	PERMIT!	NO. 5	1418	1

(Goldenrod: Utility Accounting)

PLANNING CLEARANCE

(Single Family Residential and Accessory Structures)


Grand Junction Community Development Department



IS THIS SECTION TO BE COMPLETED BY APPLICANT 150

BLDG ADDRESS 2809 Cottage LANK	TAX SCHEDULE NO. 243-63-00-090		
SUBDIVISION DACUN	SQ. FT. OF PROPOSED BLDG(S)/ADDITION		
FILINGBLKLOT	SQ. FT. OF EXISTING BLDG(S)		
(1) OWNER SOHN BAUIS	NO. OF DWELLING UNITS BEFORE: AFTER: THIS CONSTRUCTION		
(1) ADDRESS			
(1) TELEPHONE 243-7711	NO. OF BLDGS ON PARCEL / THIS CONSTRUCTION		
(2) APPLICANT CASTUE CONST	USE OF EXISTING BLDGS		
(2) ADDRESS 2755 N Aue 65 CO 8150	DESCRIPTION OF WORK AND INTENDED USE:		
(2) TELEPHONE <u>248 - 4638</u>	SINGLE FAMILY		
	r, showing all existing and proposed structure location(s), parking, erty, and all easements and rights-of-way which abut the parcel.		
™ THIS SECTION TO BE COMPLETED BY C	OMMUNITY DEVELOPMENT DEPARTMENT STAFF 🖘		
ZONE KSF-4	Maximum coverage of lot by structures 35		
SETBACKS: Front from property line (PL)	Parking Req'mt		
or 45 from center of ROW, whichever is greater			
or 45 from center of ROW, whichever is greater Side from PL Rear from F	Special Conditions		
or 45 from center of ROW, whichever is greater Side from PL Rear from F	Special Conditions		
or 45 from center of ROW, whichever is greater	Special ConditionsPL		
or 45 from center of ROW, whichever is greater Side from PL Rear from F Maximum Height Modifications to this Planning Clearance must be app	Special Conditions		
or 45 from center of ROW, whichever is greater Side	Special Conditions CENSUS TRACT TRAFFIC ZONE TOUR TOUR TRAFFIC ZONE TOUR TOUR TOUR TOUR TRAFFIC ZONE TOUR TOUR TRAFFIC ZONE TOUR TOUR TOUR TOUR TRAFFIC ZONE TOUR TOUR TRAFFIC ZONE TOUR TO		
or 45 from center of ROW, whichever is greater Side	Special Conditions CENSUS TRACT TRAFFIC ZONE TOUR TOUR TRAFFIC ZONE TOUR TOUR TOUR TOUR TRAFFIC ZONE TOUR TOUR TRAFFIC ZONE TOUR TOUR TOUR TOUR TRAFFIC ZONE TOUR TOUR TRAFFIC ZONE TOUR TO		
Side from PL Rear from PL Maximum Height Modifications to this Planning Clearance must be app Department. The structure authorized by this application a Certificate of Occupancy has been issued by the Build I hereby acknowledge that I have read this application an ordinances, laws, regulations or restrictions which apply the action, which may include but not recessarily be limited.	CENSUS TRACT TRAFFIC ZONE TRAFFIC ZONE Troved, in writing, by the Director of the Community Development cannot be occupied until a final inspection has been completed and ling Department (Section 305, Uniform Building Code). If the information is correct; I agree to comply with any and all codes, to the project. I understand that failure to comply shall result in legal to non-use of the building(s).		
Side	CENSUS TRACT D TRAFFIC ZONE 22 Troved, in writing, by the Director of the Community Development cannot be occupied until a final inspection has been completed and ling Department (Section 305, Uniform Building Code). If the information is correct; I agree to comply with any and all codes, to the project. I understand that failure to comply shall result in legal to non-use of the building(s). Date 2/9/9/		
Side	CENSUS TRACT D TRAFFIC ZONE 22 Troved, in writing, by the Director of the Community Development cannot be occupied until a final inspection has been completed and ling Department (Section 305, Uniform Building Code). If the information is correct; I agree to comply with any and all codes, to the project. I understand that failure to comply shall result in legal to non-use of the building(s). Date 2/9/9/		

(Pink: Building Department)

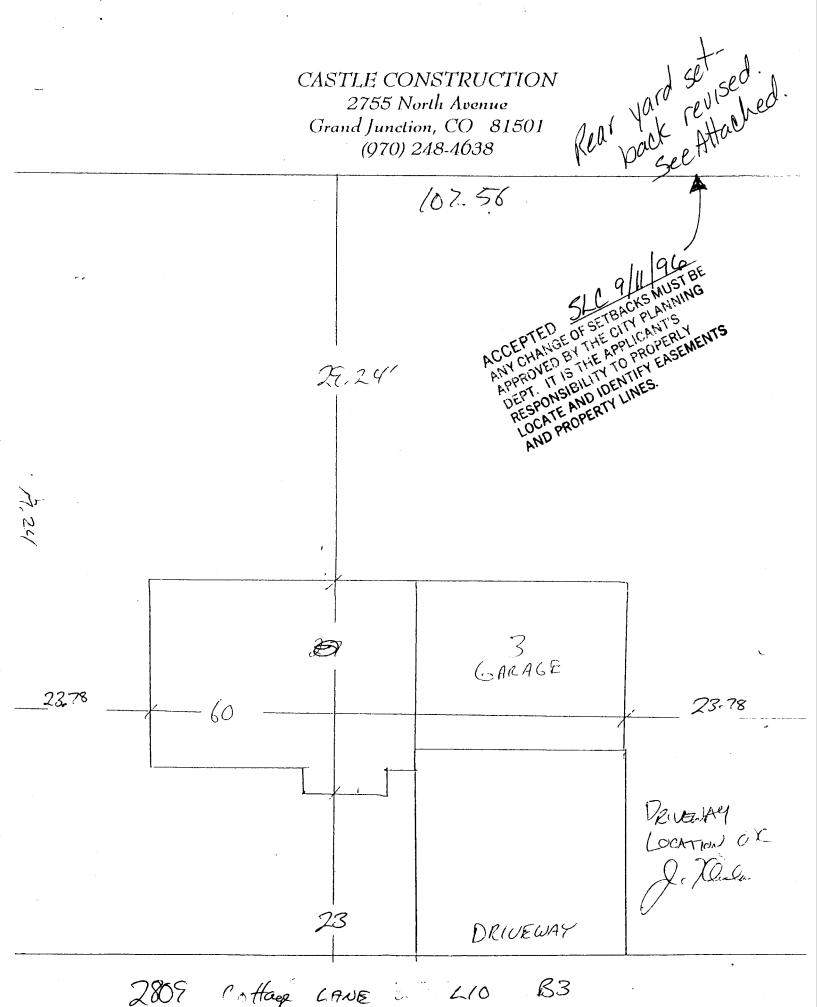

FOR BILL "BIG DADDY" FITZGERALD

LOT 10 BLOCK 3 DAWN SUBDIVISION B3-L10.DWG ACCEPTED SLC 9/11/96
ANY CHANGE OF SETBACKS MUST BE APPROVED BY THE CITY PLANNING DEPT. IT IS THE APPLICANT'S RESPONSIBILITY TO PROPERLY LOCATE AND IDENTIFY EASEMENTS AND PROPERTY LINES.

