

FEE \$	10 -
TCP \$	-0 -

BLDG PERMIT NO. 57182

School Fee 292 -

PLANNING CLEARANCE

(Single Family Residential and Accessory Structures)
Grand Junction Community Development Department

John Jumper

THIS SECTION TO BE COMPLETED BY APPLICANT

BLDG ADDRESS 2814 Cottage Lane TAX SCHEDULE NO. 2943 - 063 - 00 - 080
 SUBDIVISION Dawn SQ. FT. OF PROPOSED BLDG(S)/ADDITION 1607
 FILING 1 BLK 2 LOT 6 SQ. FT. OF EXISTING BLDG(S) —
 (1) OWNER John Davis NO. OF DWELLING UNITS BEFORE: — AFTER: 1 THIS CONSTRUCTION
 (1) ADDRESS —
 (1) TELEPHONE 243 - 7711 NO. OF BLDGS ON PARCEL BEFORE: — AFTER: 1 THIS CONSTRUCTION
 (2) APPLICANT CASTLE CONST USE OF EXISTING BLDGS —
 (2) ADDRESS 2755 N. Ave 65 @ 8181 DESCRIPTION OF WORK AND INTENDED USE: —
 (2) TELEPHONE 248 - 4638 Single Family

REQUIRED: Two (2) plot plans, on 8 1/2" x 11" paper, showing all existing and proposed structure location(s), parking, setbacks to all property lines, ingress/egress to the property, and all easements and rights-of-way which abut the parcel.

THIS SECTION TO BE COMPLETED BY COMMUNITY DEVELOPMENT DEPARTMENT STAFF

ZONE RSF-4 Maximum coverage of lot by structures 35%
 SETBACKS: Front 20' from property line (PL) or 45' from center of ROW, whichever is greater Parking Req'mt 2
 Side 7' from PL Rear 30' from PL Special Conditions —
 Maximum Height 32' CENSUS TRACT 10 TRAFFIC ZONE 22

Modifications to this Planning Clearance must be approved, in writing, by the Director of the Community Development Department. The structure authorized by this application cannot be occupied until a final inspection has been completed and a Certificate of Occupancy has been issued by the Building Department (Section 305, Uniform Building Code).

I hereby acknowledge that I have read this application and the information is correct; I agree to comply with any and all codes, ordinances, laws, regulations or restrictions which apply to the project. I understand that failure to comply shall result in legal action, which may include but not necessarily be limited to non-use of the building(s).

Applicant Signature WJ Date 8/8/66
 Department Approval Marcia Rabideaux Date 8-9-96


Additional water and/or sewer tap fee(s) are required: YES NO W/O No. 940 - S/F
 Utility Accounting CM Caly Date 8/14/94

VALID FOR SIX MONTHS FROM DATE OF ISSUANCE (Section 9-3-2C Grand Junction Zoning & Development Code)

(White: Planning) (Yellow: Customer) (Pink: Building Department) (Goldenrod: Utility Accounting)

CASTLE CONSTRUCTION
2755 North Avenue
Grand Junction, CO 81501
(970) 248-4638

ACCEPTED MP 8-9-96
ANY CHANGE OF SETBACKS MUST BE
APPROVED BY THE CITY PLANNING
DEPT. IT IS THE APPLICANT'S
RESPONSIBILITY TO PROPERLY
LOCATE AND IDENTIFY EASEMENTS
AND PROPERTY LINES.

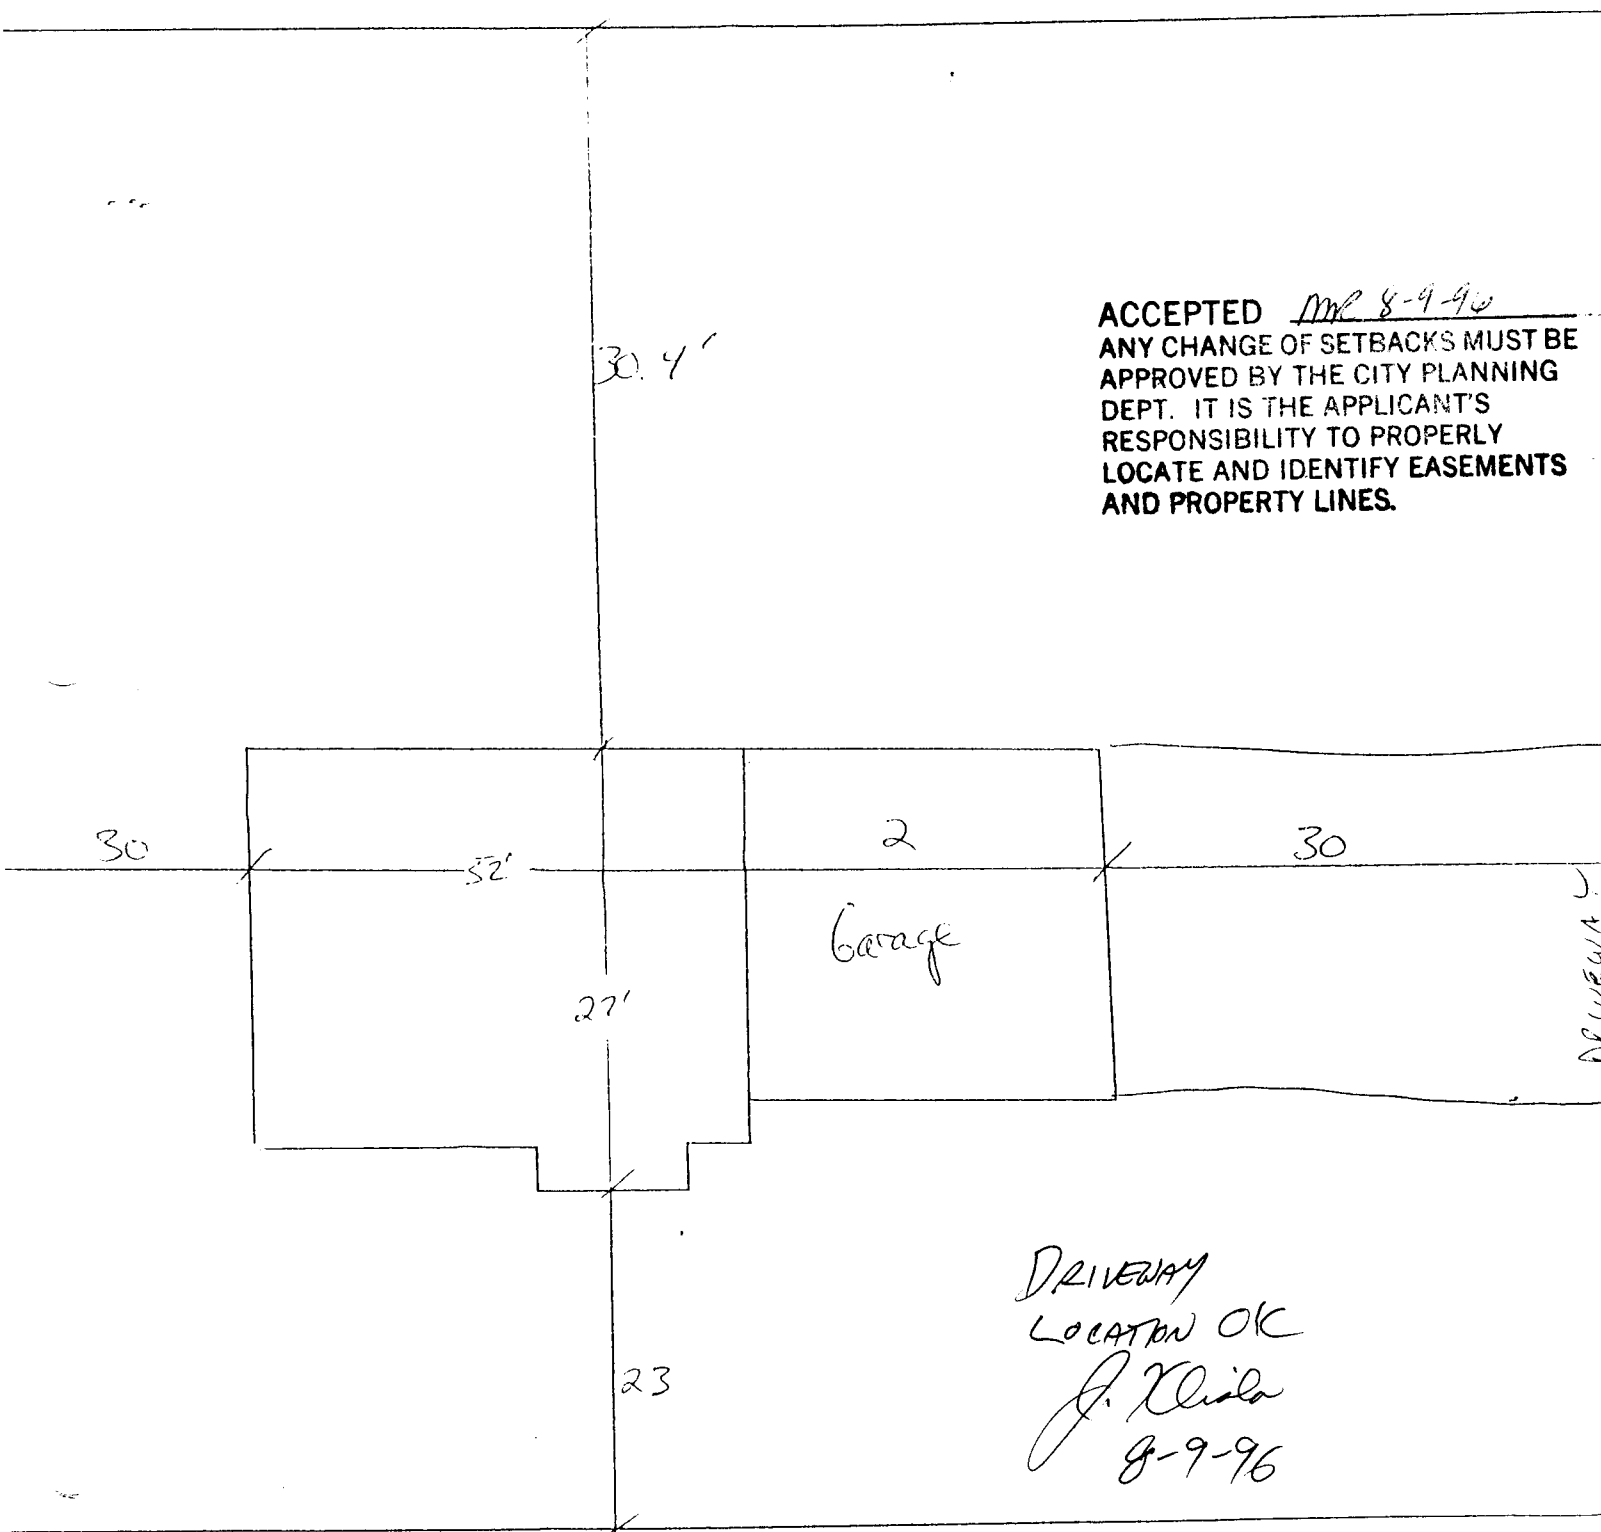

DRIVEWAY
LOCATION OK
J. Kliala
8-9-96

L682 2814 Cottage Lane