

FEE \$ 10.00
TCP \$ _____

BLDG PERMIT NO. 57471

School - \$292

PLANNING CLEARANCE
(Single Family Residential and Accessory Structures)
Grand Junction Community Development Department

Schump

THIS SECTION TO BE COMPLETED BY APPLICANT

BLDG ADDRESS 2804 Daybreak TAX SCHEDULE NO. 2943-063-00090
 SUBDIVISION Dawn SQ. FT. OF PROPOSED BLDG(S)/ADDITION ~~1000~~ 1248
 FILING 1 BLK 3 LOT 9 SQ. FT. OF EXISTING BLDG(S) _____
 (1) OWNER John Davis NO. OF DWELLING UNITS
 BEFORE: 5 AFTER: 1 THIS CONSTRUCTION
 (1) ADDRESS _____
 (1) TELEPHONE 243-7711 NO. OF BLDGS ON PARCEL
 BEFORE: 5 AFTER: 1 THIS CONSTRUCTION
 (2) APPLICANT Castle Const USE OF EXISTING BLDGS _____
 (2) ADDRESS 2755 North Ave DESCRIPTION OF WORK AND INTENDED USE: _____
 (2) TELEPHONE 248-4638 single family

REQUIRED: Two (2) plot plans, on 8 1/2" x 11" paper, showing all existing and proposed structure location(s), parking, setbacks to all property lines, ingress/egress to the property, and all easements and rights-of-way which abut the parcel.

THIS SECTION TO BE COMPLETED BY COMMUNITY DEVELOPMENT DEPARTMENT STAFF

ZONE RSF-4 Maximum coverage of lot by structures 35%
 SETBACKS: Front 23 from property line (PL) Parking Req'mt _____
 or _____ from center of ROW, whichever is greater Special Conditions _____
 Side 7 from PL Rear 30 from PL
 Maximum Height 32'
 CENSUS TRACT 10 TRAFFIC ZONE 22

Modifications to this Planning Clearance must be approved, in writing, by the Director of the Community Development Department. The structure authorized by this application cannot be occupied until a final inspection has been completed and a Certificate of Occupancy has been issued by the Building Department (Section 305, Uniform Building Code).

I hereby acknowledge that I have read this application and the information is correct; I agree to comply with any and all codes, ordinances, laws, regulations or restrictions which apply to the project. I understand that failure to comply shall result in legal action, which may include but not necessarily be limited to non-use of the building(s).

Applicant Signature *W/D* Date 9/9/96

Department Approval *Kristen L. Ambrose* Date 9/9/96

Additional water and/or sewer tap fee(s) are required: YES NO _____ W/O No. W/O 9496

Utility Accounting *Cedward* Date 9-10-96

VALID FOR SIX MONTHS FROM DATE OF ISSUANCE (Section 9-3-2C Grand Junction Zoning & Development Code)


(White: Planning) (Yellow: Customer) (Pink: Building Department) (Goldenrod: Utility Accounting)

CASTLE CONSTRUCTION

2755 North Avenue

Grand Junction, CO 81501

(970) 248-4638

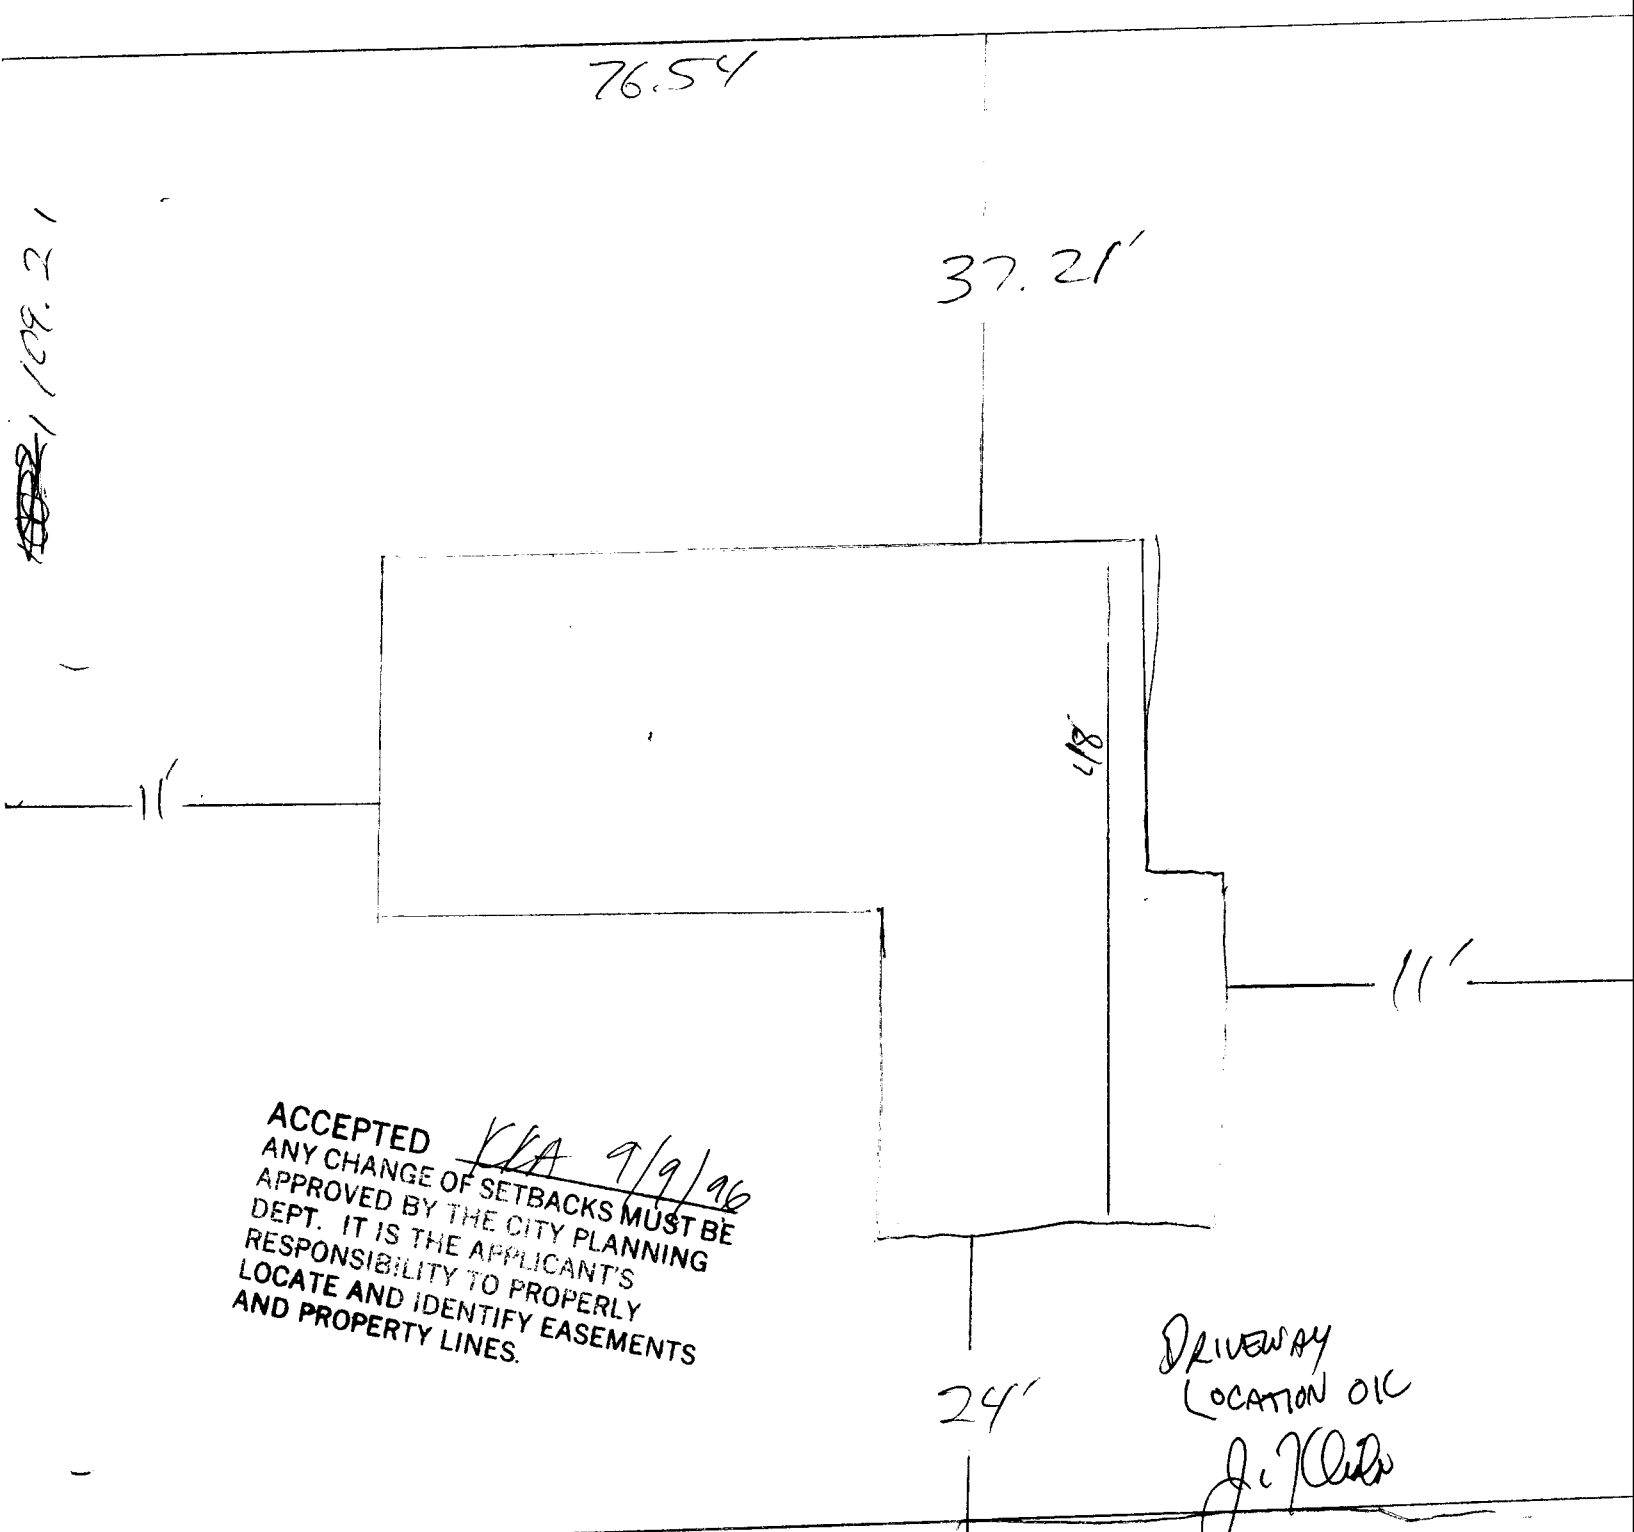

~~109.21~~

ACCEPTED *KJA 9/9/96*
ANY CHANGE OF SETBACKS MUST BE
APPROVED BY THE CITY PLANNING
DEPT. IT IS THE APPLICANT'S
RESPONSIBILITY TO PROPERLY
LOCATE AND IDENTIFY EASEMENTS
AND PROPERTY LINES.

DRIVEWAY
LOCATION OIC

J. J. [Signature]

8-29-96

2804 DAYBREAK

L9 R3