

FEE \$ 10⁰⁰
 TCP \$ 400⁰⁰

BLDG PERMIT NO. 54775

PLANNING CLEARANCE
 (Single Family Residential and Accessory Structures)
 Grand Junction Community Development Department

JCP
PC

9009-0075

THIS SECTION TO BE COMPLETED BY APPLICANT

BLDG ADDRESS 2834 Grd. Falls Cir #B TAX SCHEDULE NO. 2943-072-29-013
 SUBDIVISION Falls Village SQ. FT. OF PROPOSED BLDG(S)/ADDITION 1298⁰
 FILING 3 BLK 2 LOT 12 SQ. FT. OF EXISTING BLDG(S) NA
 (1) OWNER R Durssey NO. OF DWELLING UNITS
 BEFORE: 0 AFTER: 1 THIS CONSTRUCTION
 (1) ADDRESS 690 29 1/2 Rd.
 NO. OF BLDGS ON PARCEL
 BEFORE: 0 AFTER: 1 THIS CONSTRUCTION
 (2) APPLICANT Durssey & Sons USE OF EXISTING BLDGS NA
 (2) ADDRESS 690 29 1/2 Rd. DESCRIPTION OF WORK AND INTENDED USE:
 (2) TELEPHONE 212-2300 Residence

REQUIRED: Two (2) plot plans, on 8 1/2" x 11" paper, showing all existing and proposed structure location(s), parking, setbacks to all property lines, ingress/egress to the property, and all easements and rights-of-way which abut the parcel. 260-6464

THIS SECTION TO BE COMPLETED BY COMMUNITY DEVELOPMENT DEPARTMENT STAFF

ZONE PR Maximum coverage of lot by structures _____
 SETBACKS: Front _____ from property line (PL)
 or _____ from center of ROW, whichever is greater Parking Req't 2
 Side _____ from PL Rear per plan from PL Special Conditions Sidewalk must be in and
 Maximum Height per plan accepted prior to issuance of C.O.
 CENS.T. _____ T.ZONE _____ ANN# _____

Modifications to this Planning Clearance must be approved, in writing, by the Director of the Community Development Department. The structure authorized by this application cannot be occupied until a final inspection has been completed and a Certificate of Occupancy has been issued by the Building Department (Section 305, Uniform Building Code).

I hereby acknowledge that I have read this application and the information is correct; I agree to comply with any and all codes, ordinances, laws, regulations or restrictions which apply to the project. I understand that failure to comply shall result in legal action, which may include but not necessarily be limited to non-use of the building(s).

Applicant Signature R Durssey Date 1/17/96

Department Approval Kathy Parker Date 1/17/96

Additional water and/or sewer tap fee(s) are required: YES NO _____ W/O No. 8879 S/F

Utility Accounting Mellie Jowley Date 1-18-96

VALID FOR SIX MONTHS FROM DATE OF ISSUANCE (Section 9-3-2C Grand Junction Zoning & Development Code)


(White: Planning) (Yellow: Customer) (Pink: Building Department) (Goldenrod: Utility Accounting)

021 200 75

BLOCK TWO

S 89°50'00" W 240.00

P.O.B.

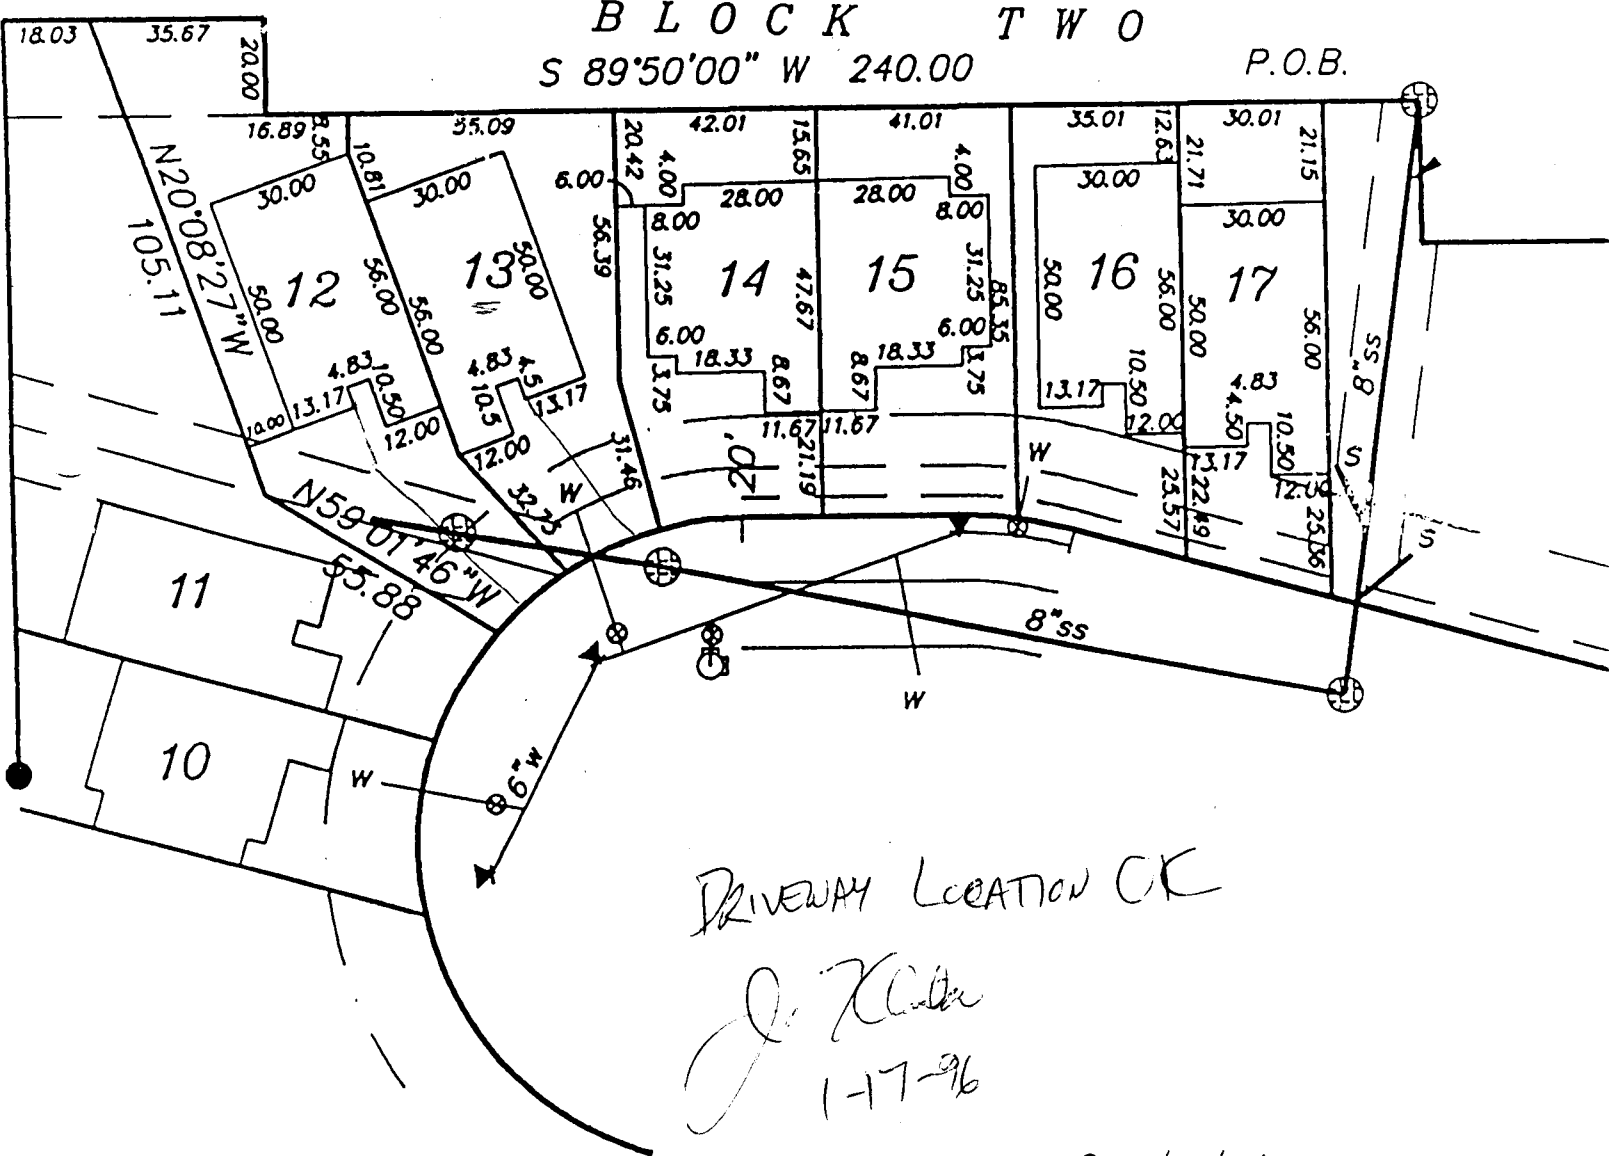

DRIVEWAY LOCATION OK
J. K. Carter
1-17-96

ACCEPTED KP 1/17/96
I, _____
Surveyor
RESPONSIBLE FOR THE ACCURACY
LOCATE AND CORRECT EASEMENTS
AND PROPERTY LINES.